



Architects

1133 E. 2nd St.
Wichita, KS 67214
316.262.7435

Seal:



**PIPING AND EQUIPMENT
NEW BUILDING
37TH STREET NORTH & OHIO STREET
WICHITA, KANSAS**

Revisions:

Proj no: PPNEN07100
Date: 8/2007
Sheet Title:
PPW Plan & Prof
Drawn by: NS
Checked by: KM

C3.2
of

© 2007 PBA Architects

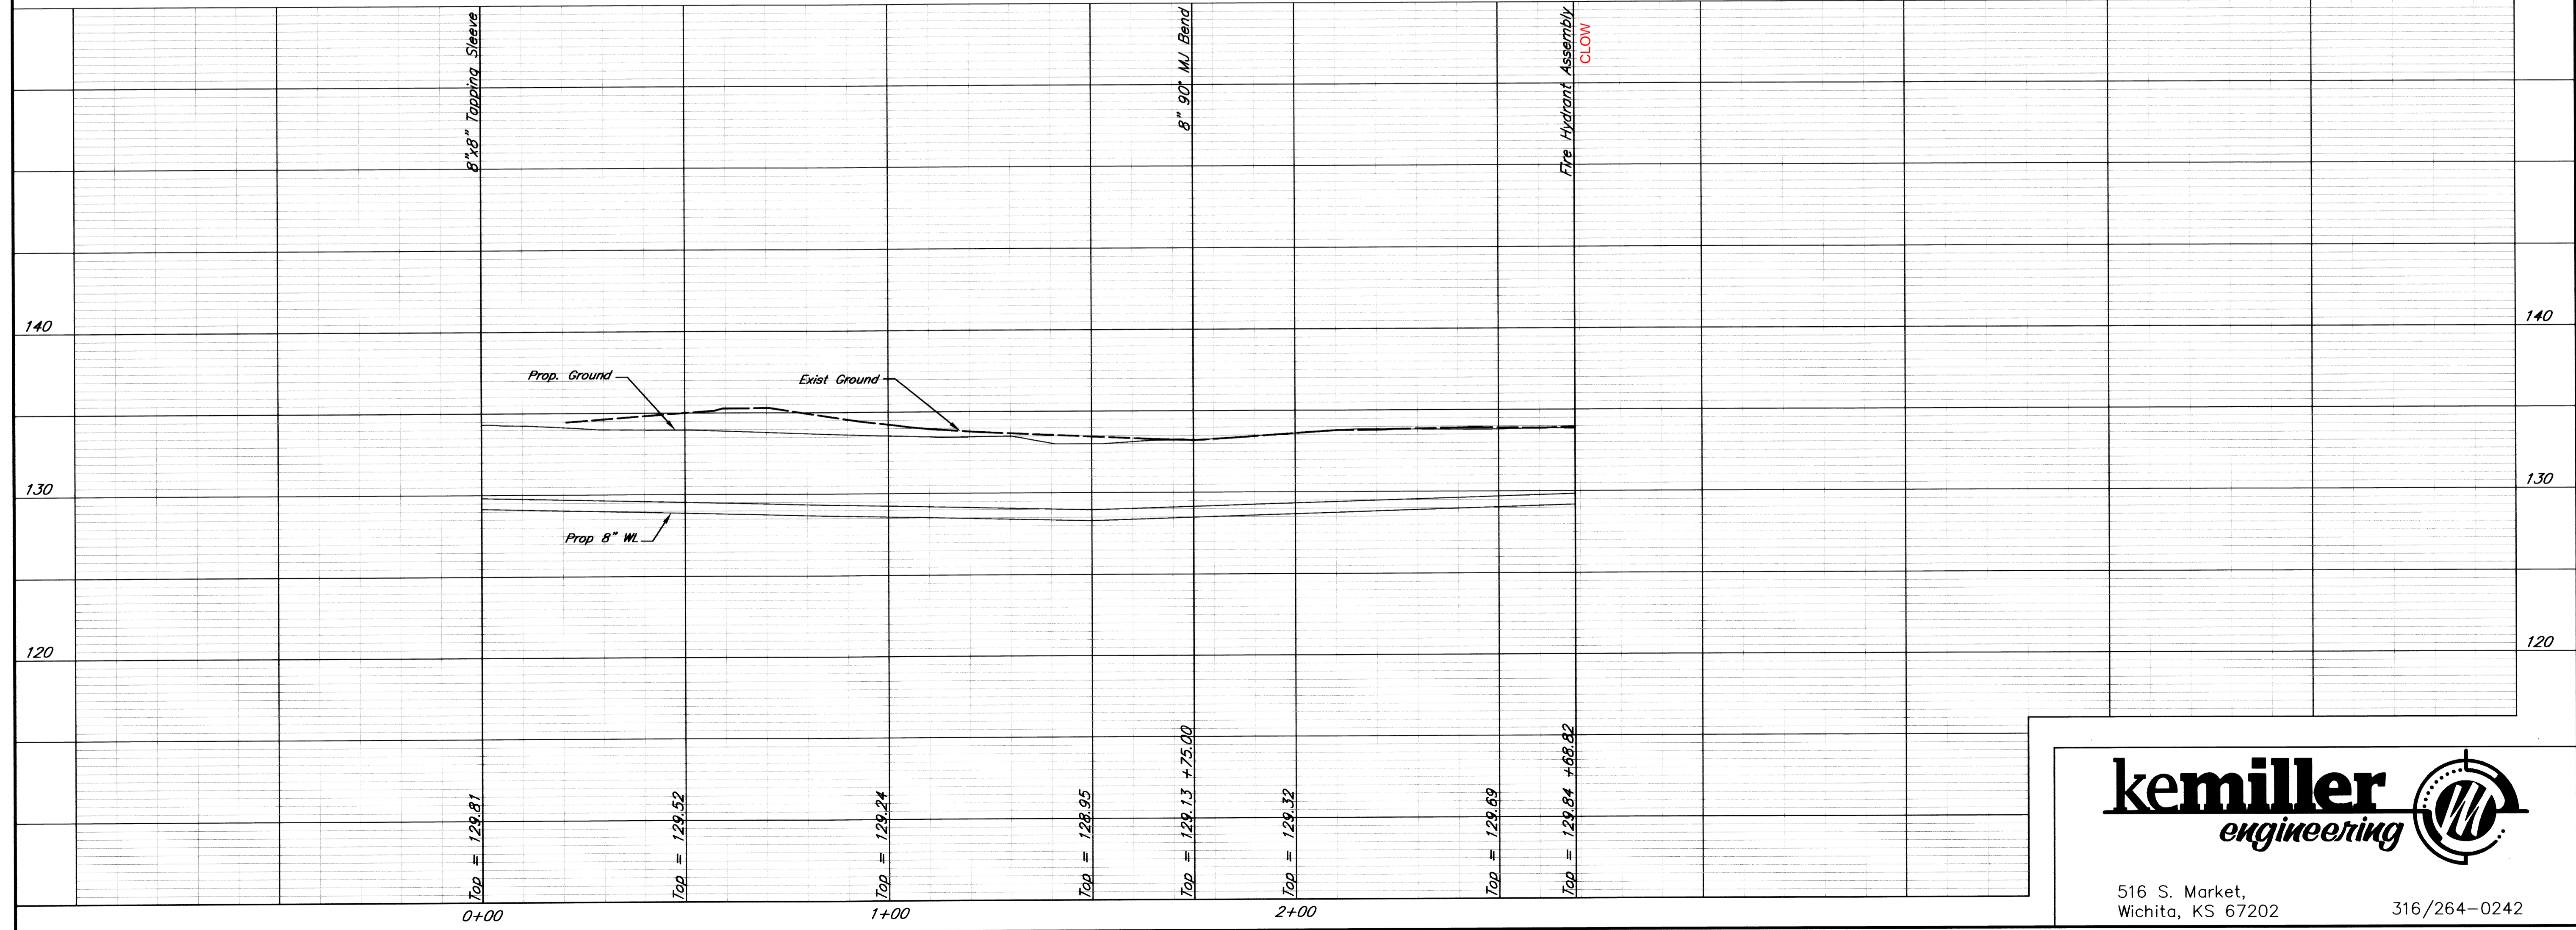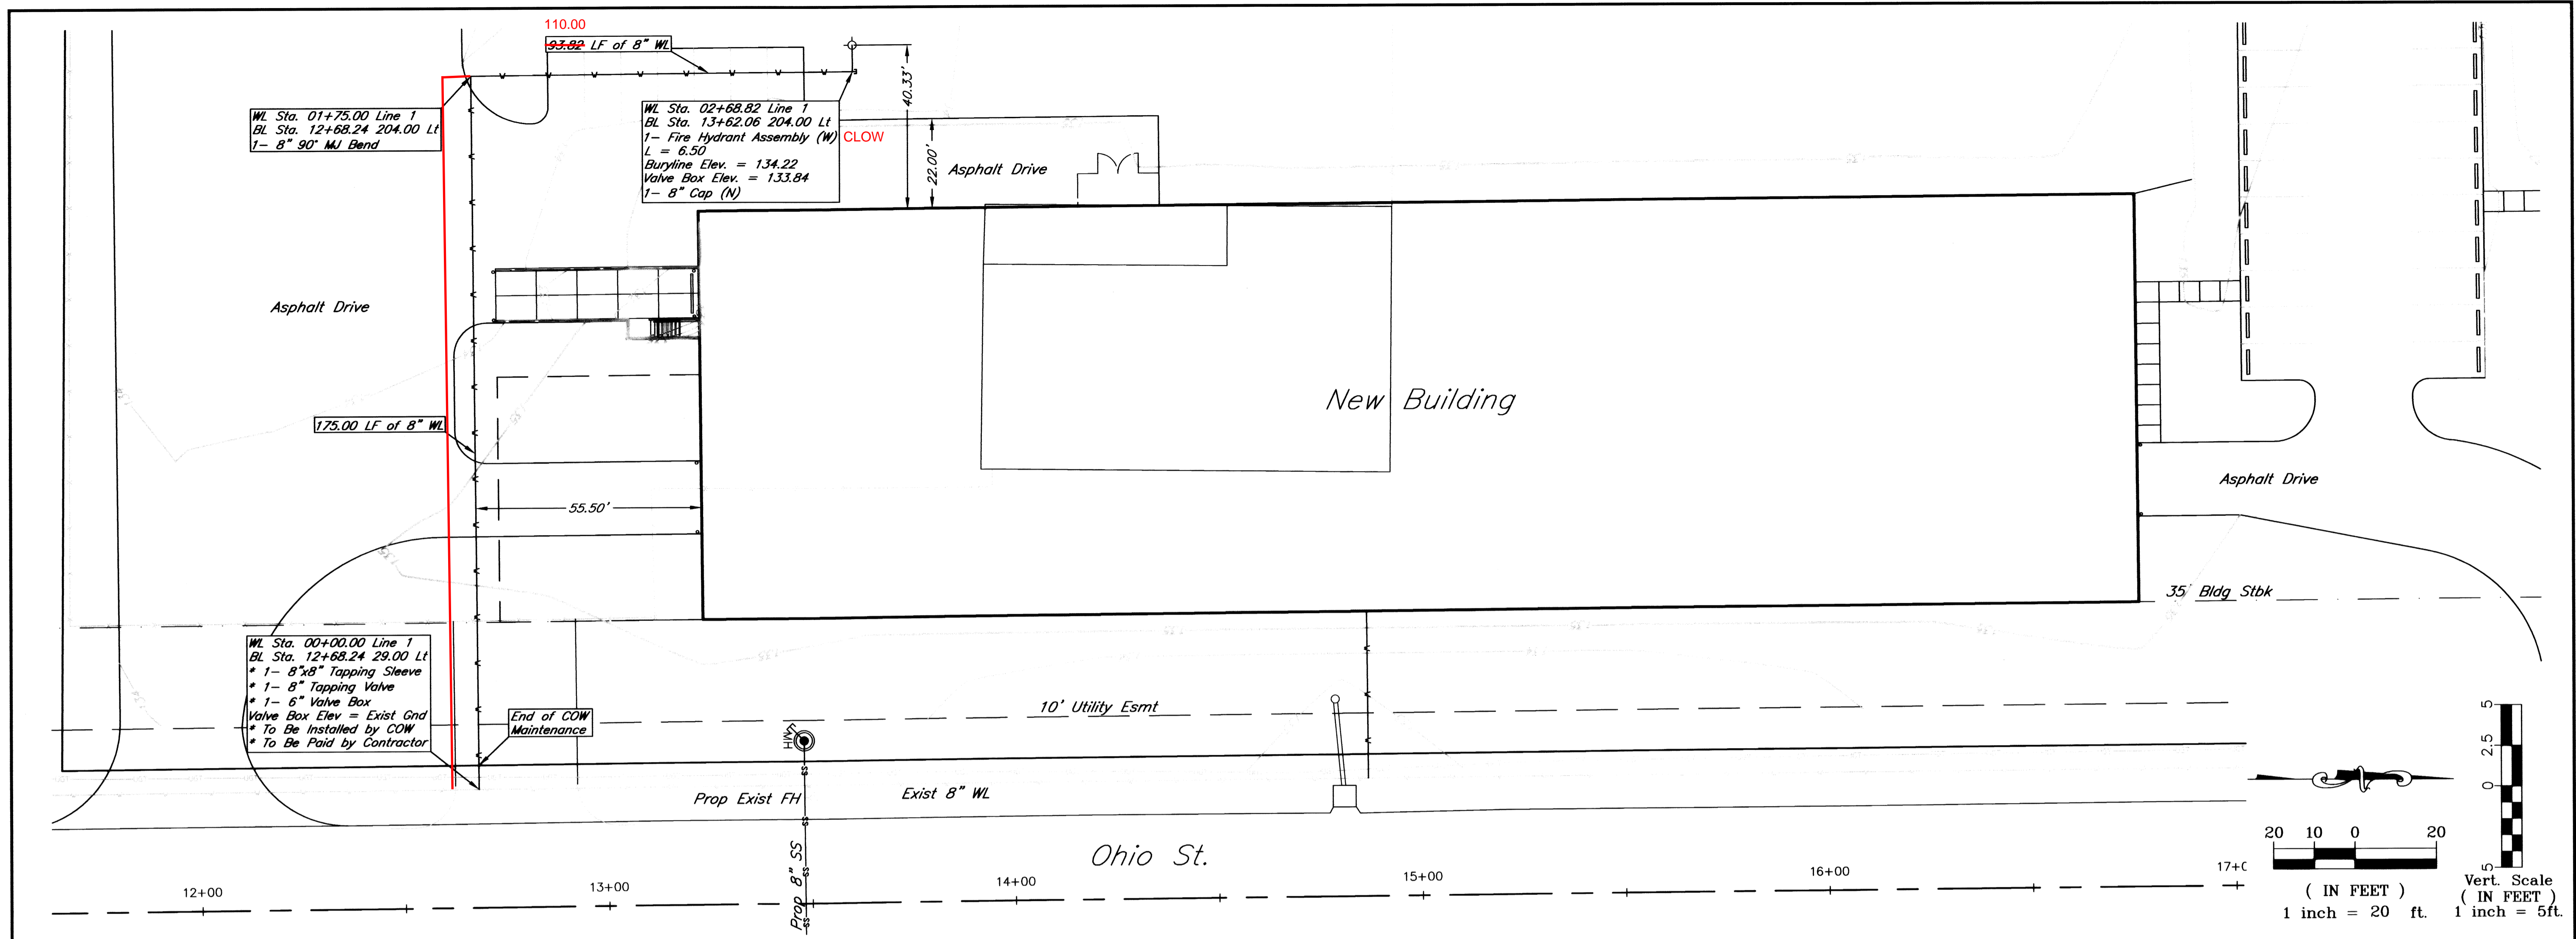

kemiller
engineering

516 S. Market,
Wichita, KS 67202

316/264-0242