

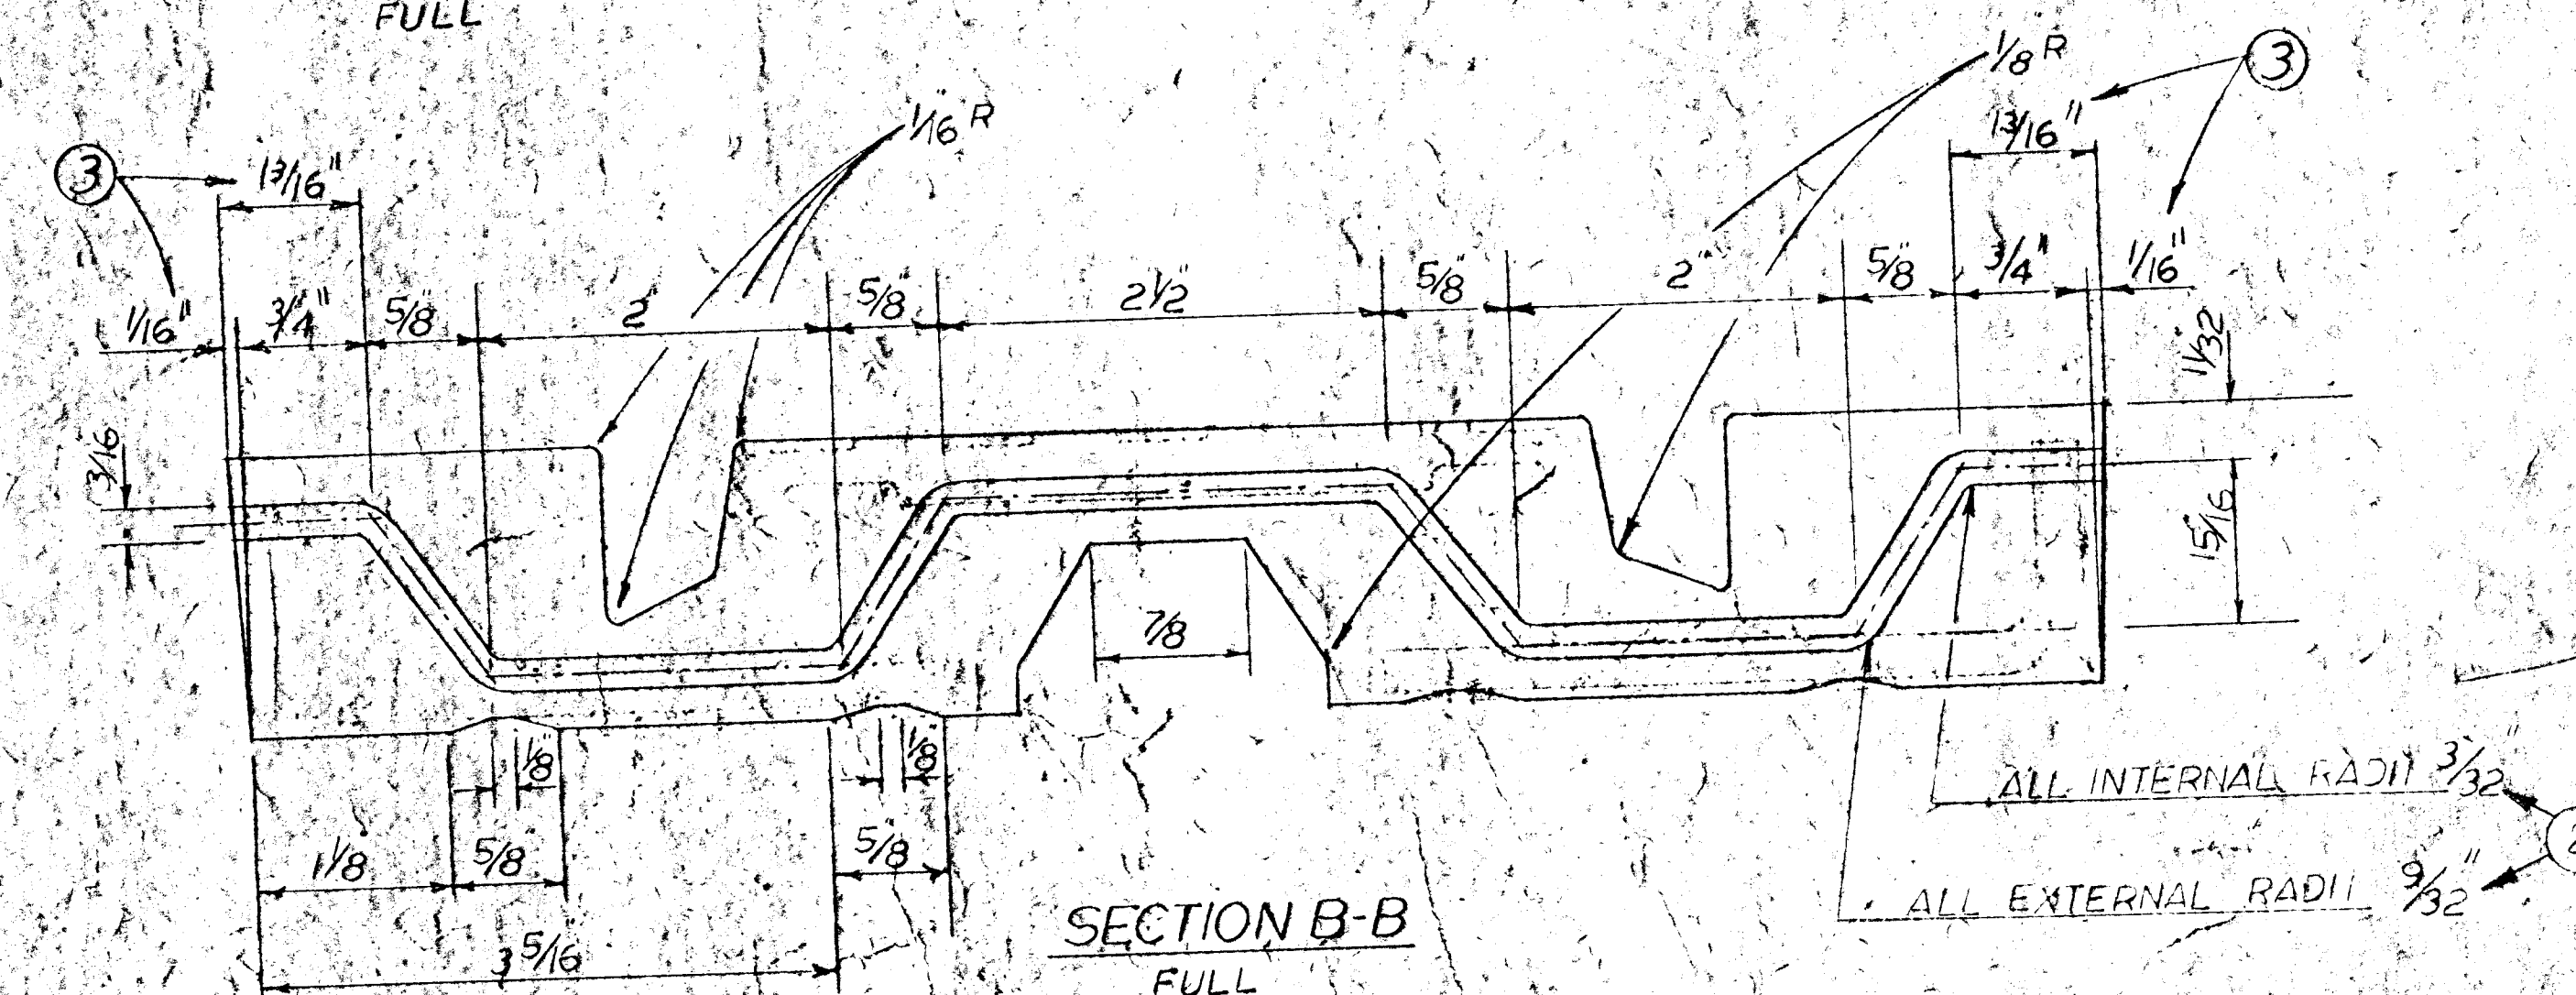
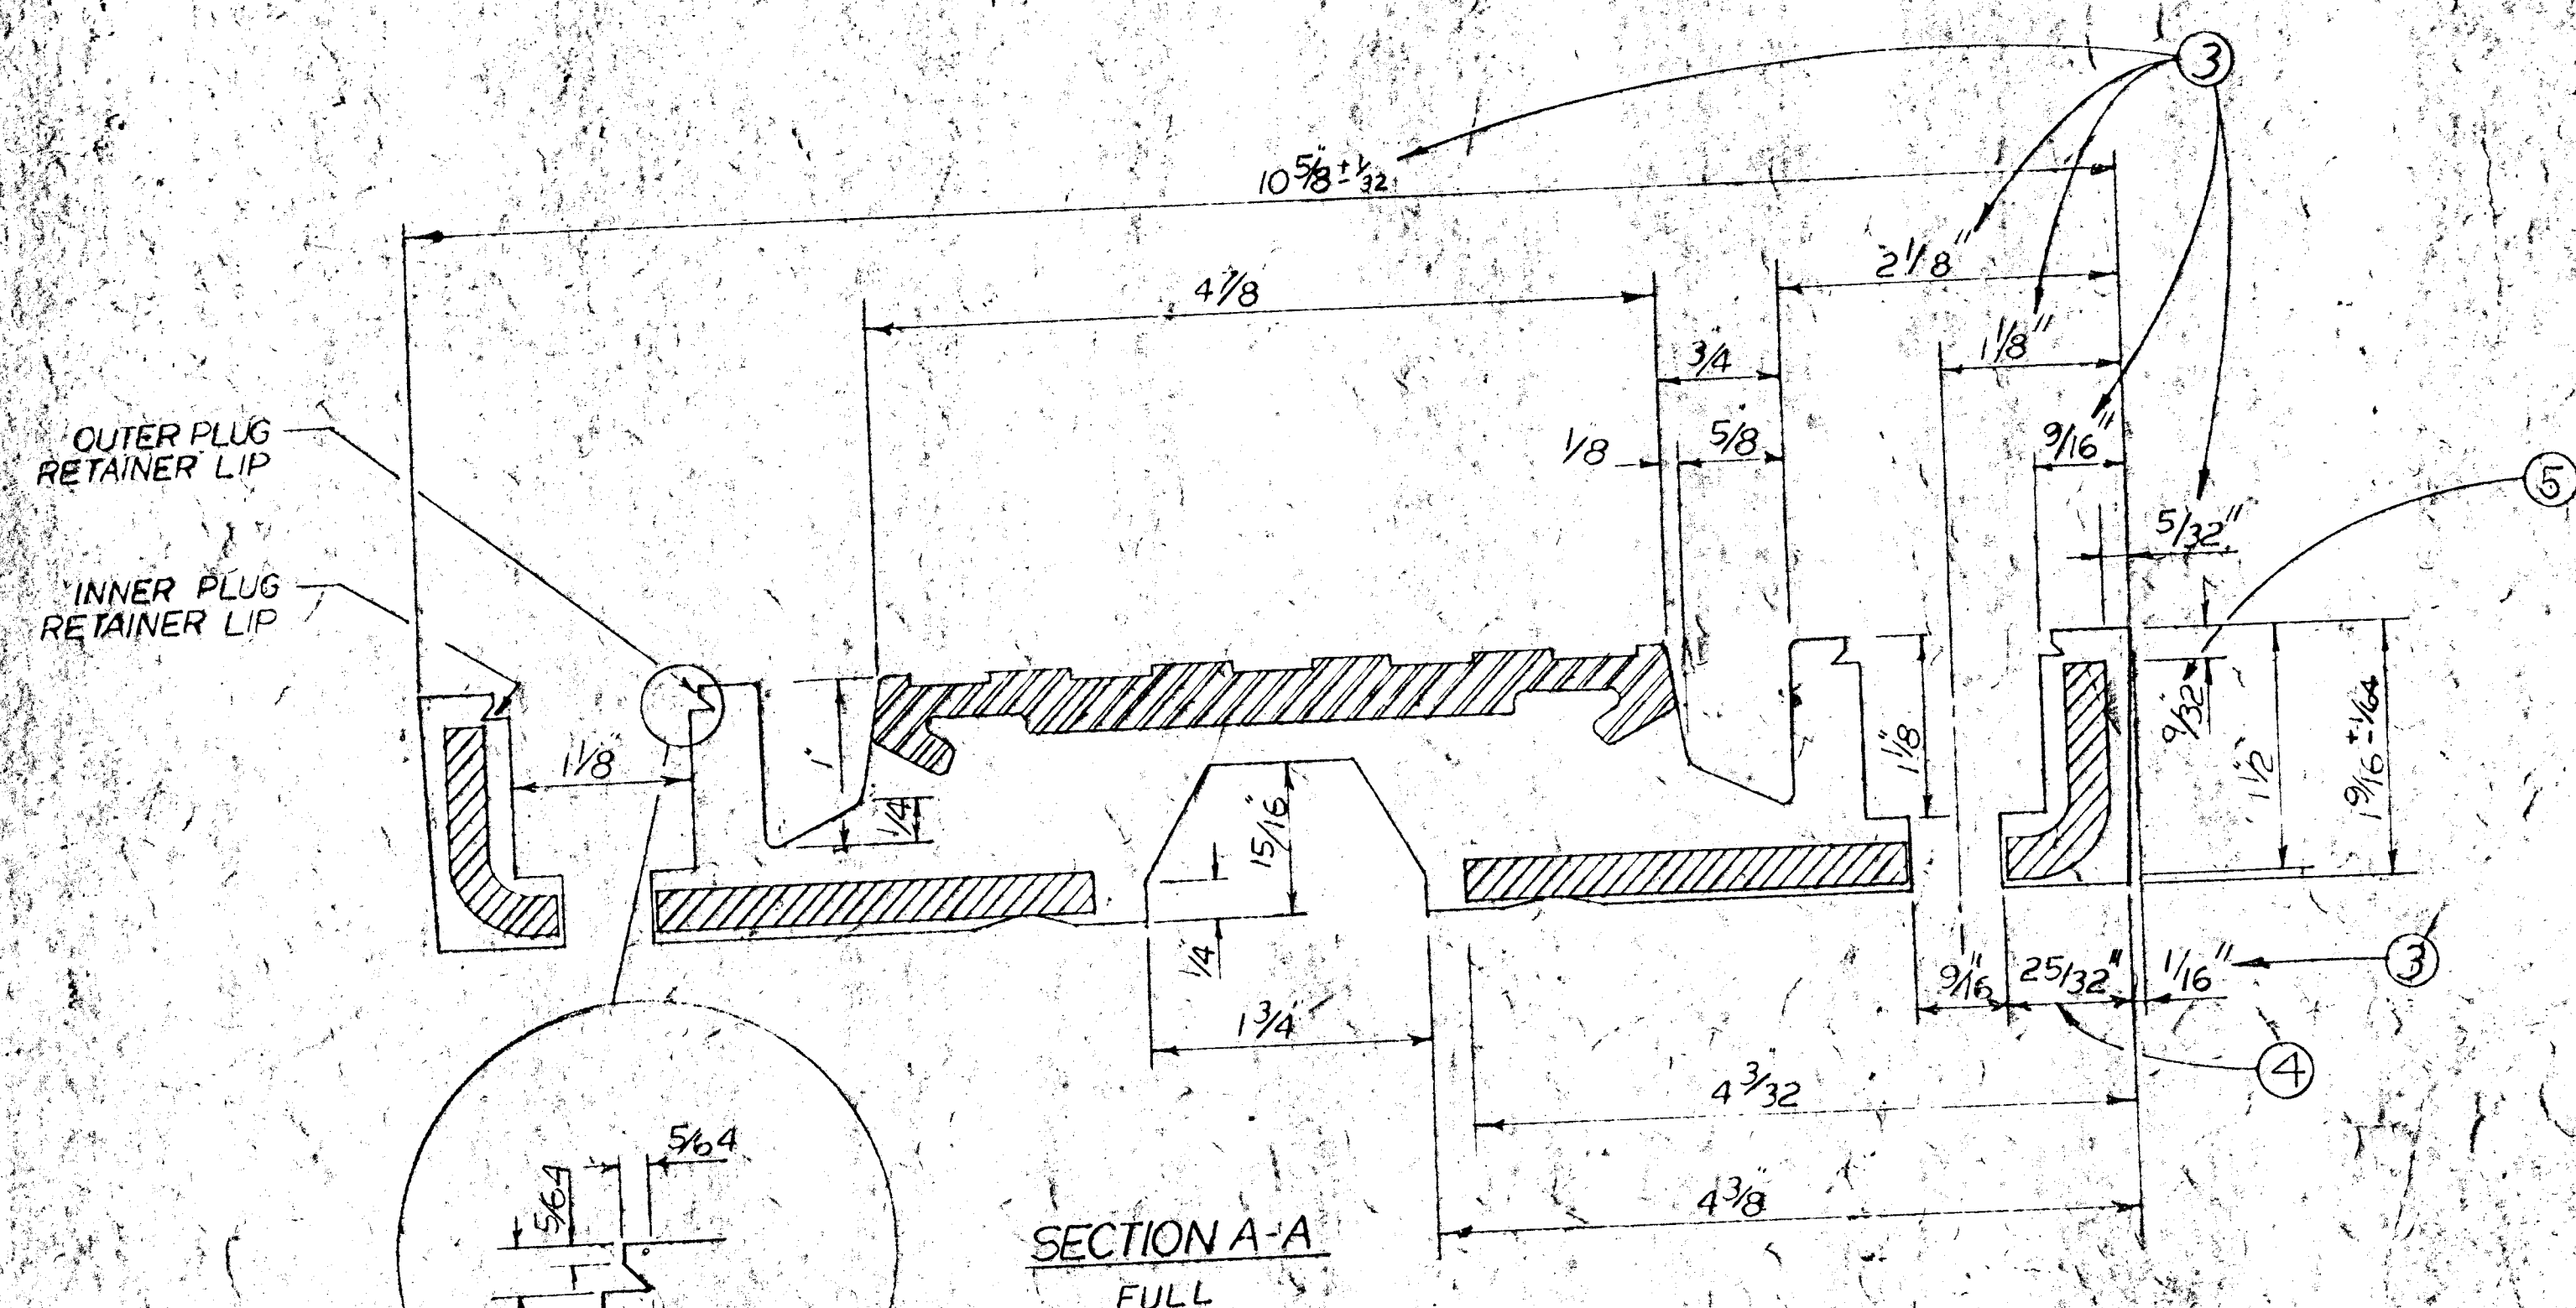
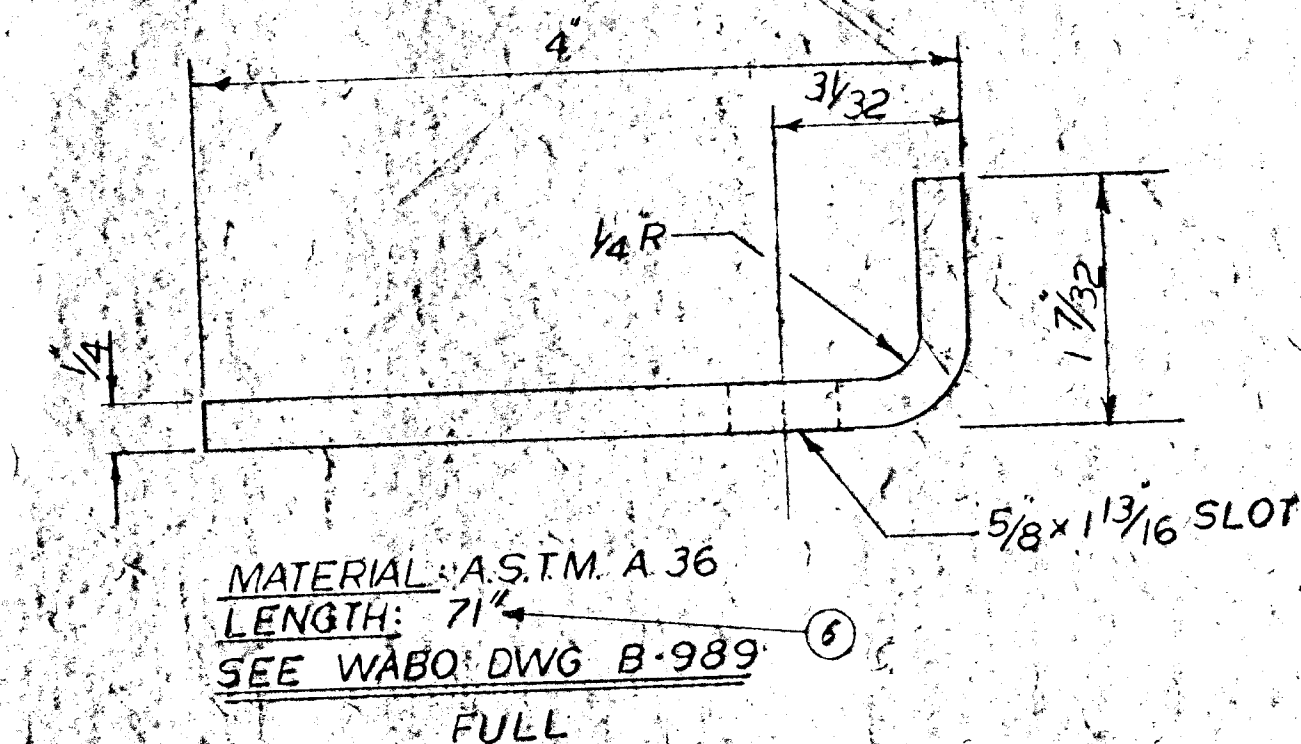
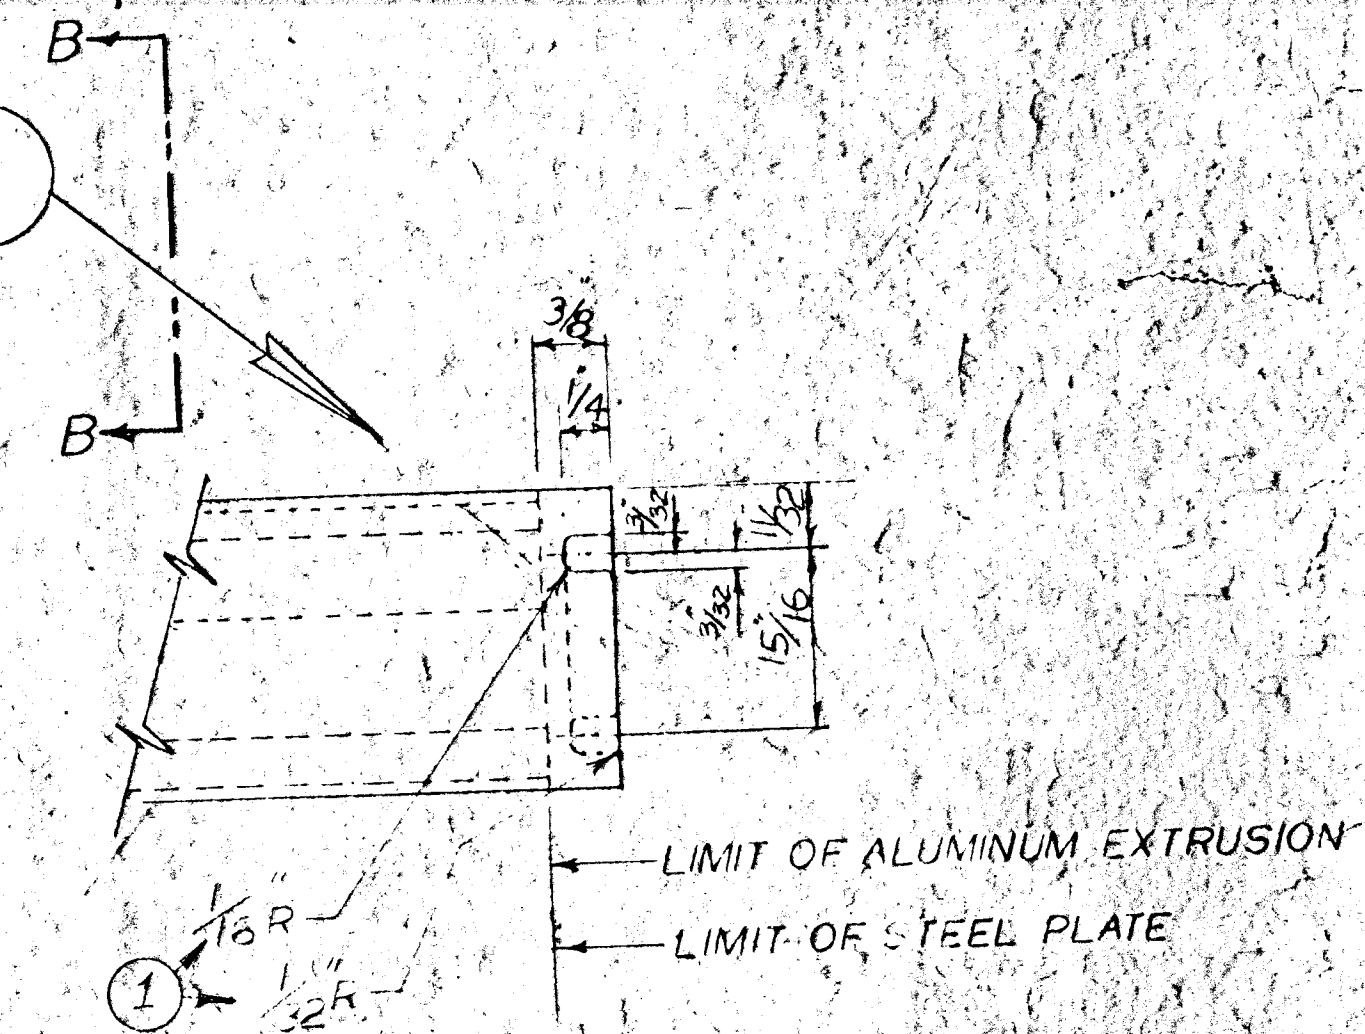
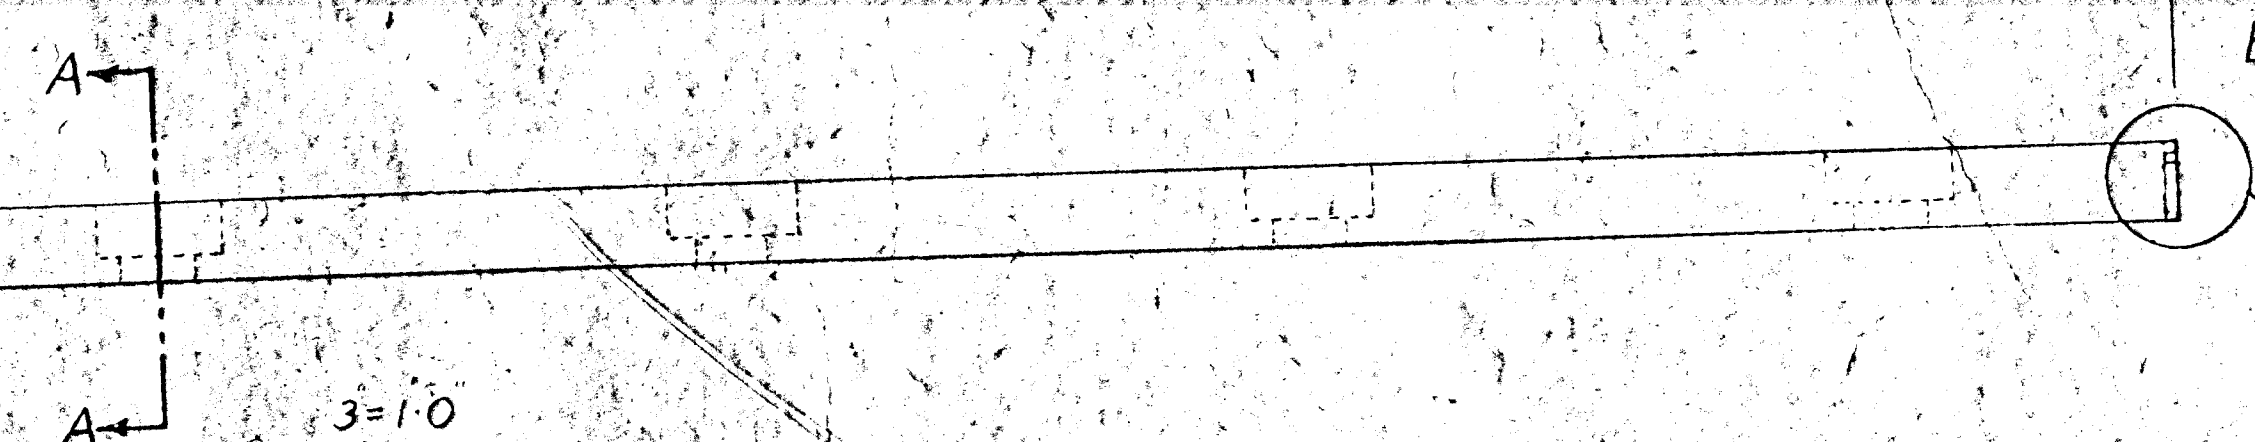


MATERIAL: ALUMINUM 6061-T6
LENGTH: 71 1/4
SEE WABO DWG. B-995
FULL

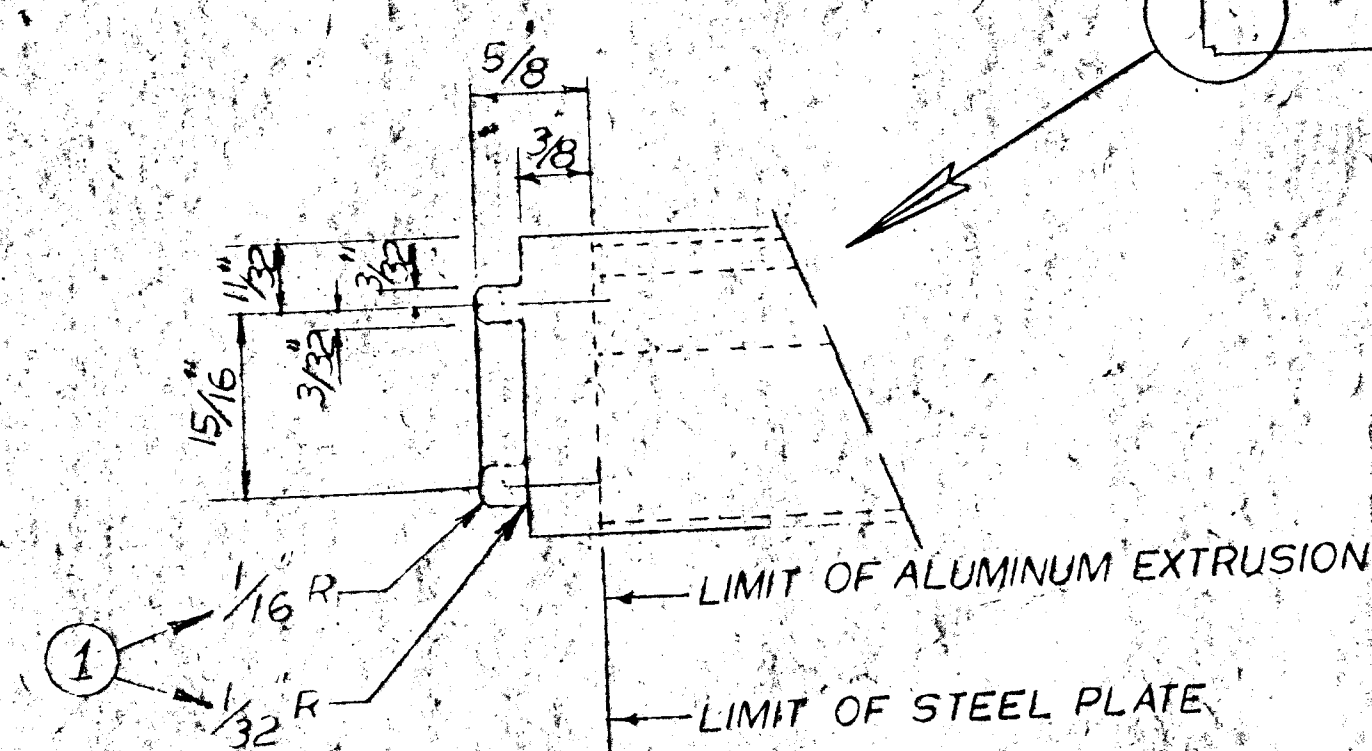

REVISIONS			NAME	
NO.	DATE	DESCRIPTION		
1	1-14-73	RADIi ADDED TO T&G	V.K.	
2	1-14-73	RADIi ADDED TO T&G CORNERS	V.K.	
3	1-22-73	INCREASE X-SECTION, Vb	CH	
4	1-22-73	CORRECT DIM. IN SEC. A-A	CH	
5	1-22-73	INCREASE DIM. FROM 1/2" TO 3/4"	R.K.	
6	1-22-73	FLANGED LENGTH OF STEEL ANGLE	J.M.A.	

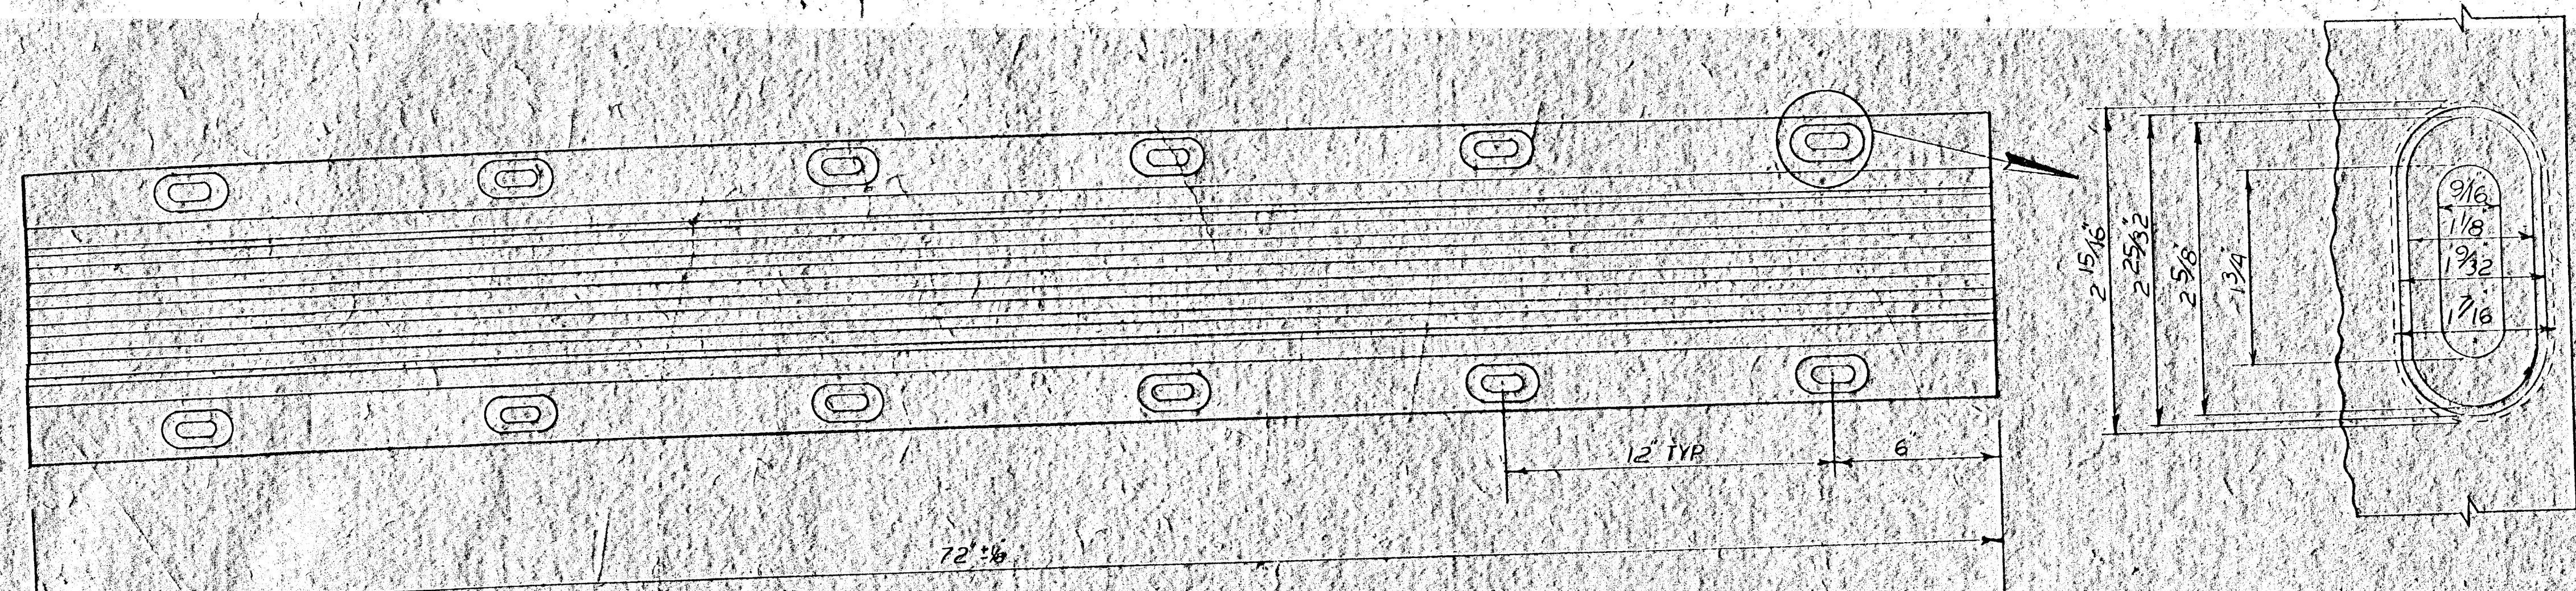

1230 Niagara St. Buffalo, N.Y. 14213

SCALE:	DRAWN BY: W.W.
DATE: 11-8-73	REVISED:
WABOFLEX SR 2A	
DRAWING NUMBER: A-994-4	