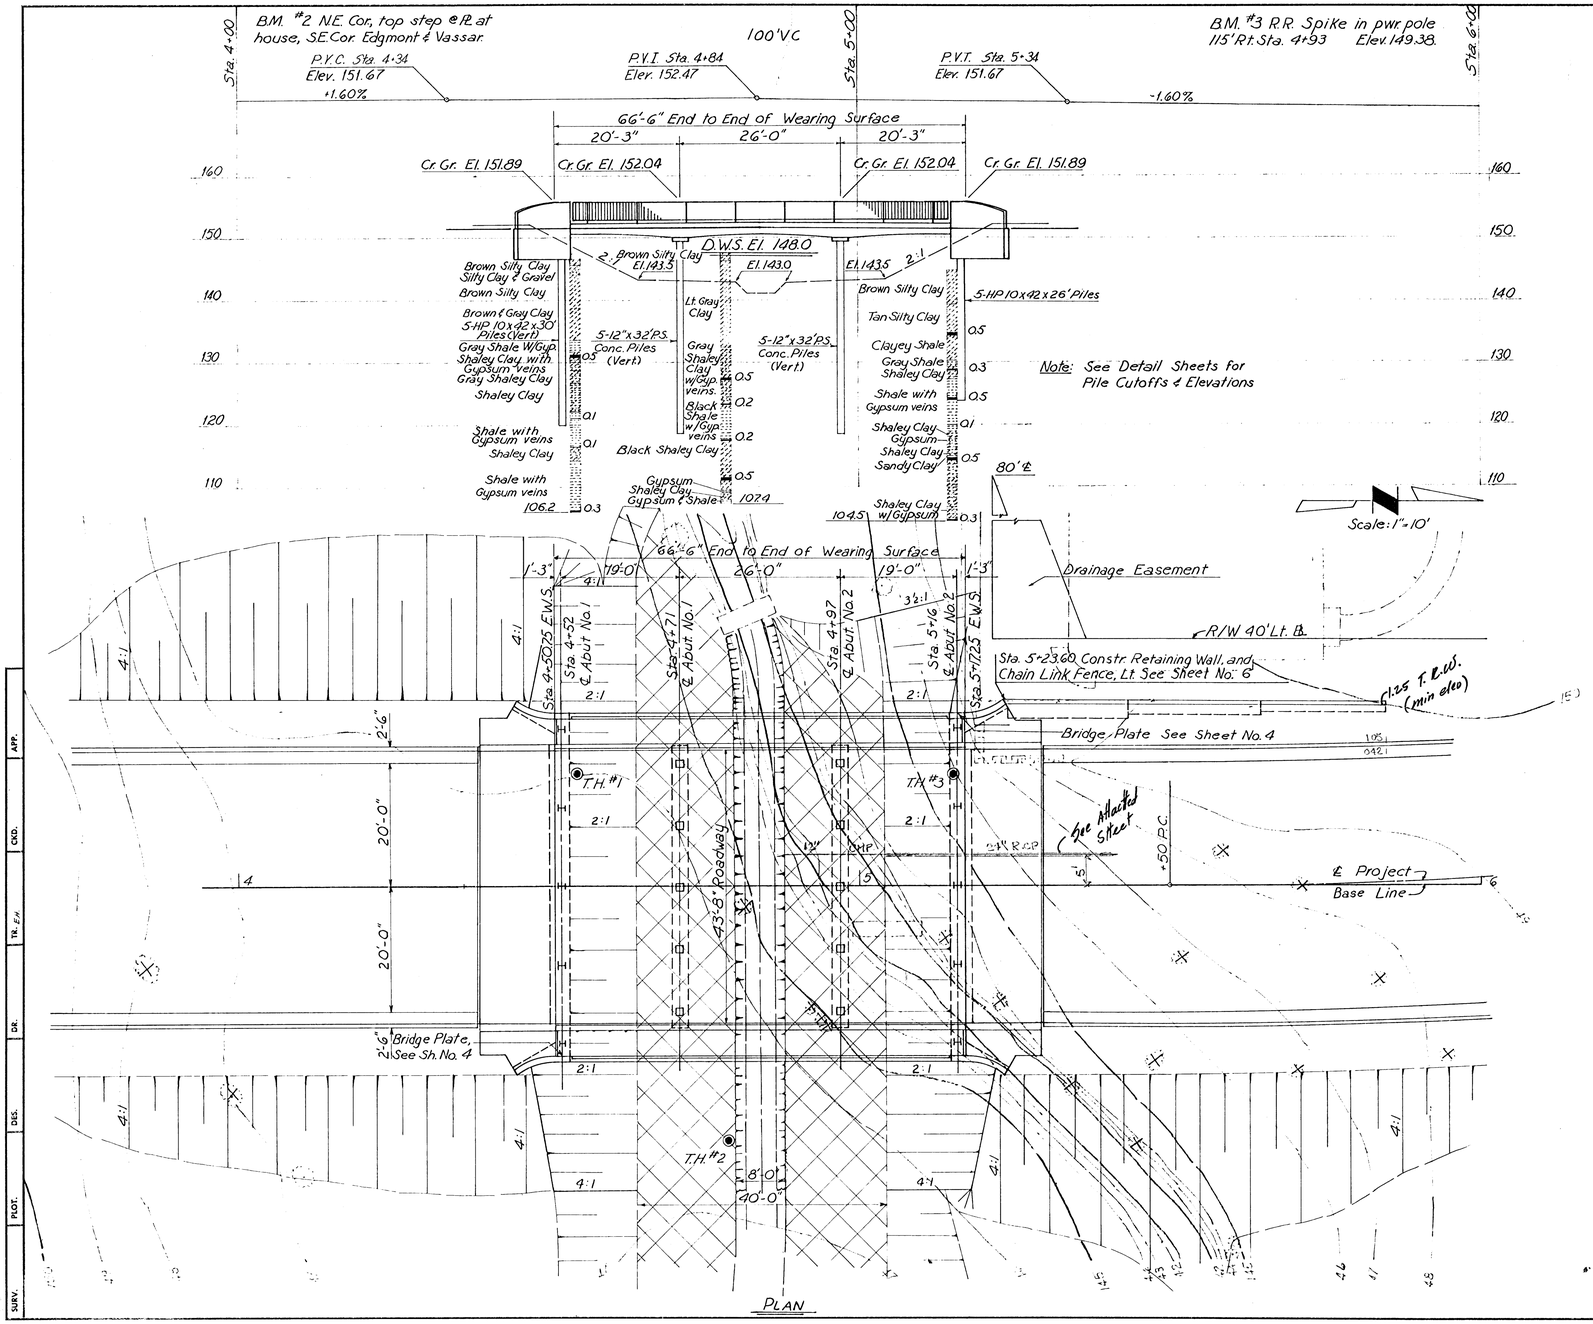

PLAN

DESIGN LOADING: HS20-44 A.A.S.H.T.O. - SPEC. (1973 EDITION)

DRAINAGE DATA

DRAINAGE AREA	510 ACRES
DESIGN DISCHARGE	1,000 C.F.S.
WATERWAY PROVIDED:	
BELOW D.W.S.	242 SQ.FT.
TOTAL	348 SQ.FT.

SEE SHEET NO. 1 FOR GENERAL NOTES AND SUMMARY OF QUANTITIES.

CITY OF WICHITA, KANSAS
R. W. LINN, P.E., CITY ENGINEER

VASSAR STREET BRIDGE
OVER SLEEPY HOLLOW CREEK

CONSTRUCTION LAYOUT

DFS DELAMATER, FREUND & SCHERER, P.A.
ENGINEERS & ARCHITECTS
WICHITA, KANSAS

SCALE | DATE December, 1975 | DWG. NO. 79-R-3

APP. CKD. TR. EN. DR. DES. PLOT. SURV.