


BENCHMARKS:
 BM #1: BENT 60d NAIL IN LIGHT POLE, 55' SSW OF THE E1/4 COR., SEC. 13, TWP. 26-S, R-1-W. ELEV. = 1336.54 NGVD29

BM #2: RAILROAD SPIKE IN E. FACE OF N. "H" POLE, 60± S. OF N. LINE, S1/2, NE1/4, SEC. 13, TWP. 26-S, R-1-W. ELEV. = 1335.93 NGVD29

BM #3: "□" CUT ON TOP OF NE COR. OF WATER VAULT, 437± E. & 54± N. OF S1/4 COR., SEC. 13, TWP. 26-S, R-1-W. ELEV. = 1334.81 NGVD29


Scale: 1" = 40' Horizontal
 1" = 5' Vertical
 • = Iron

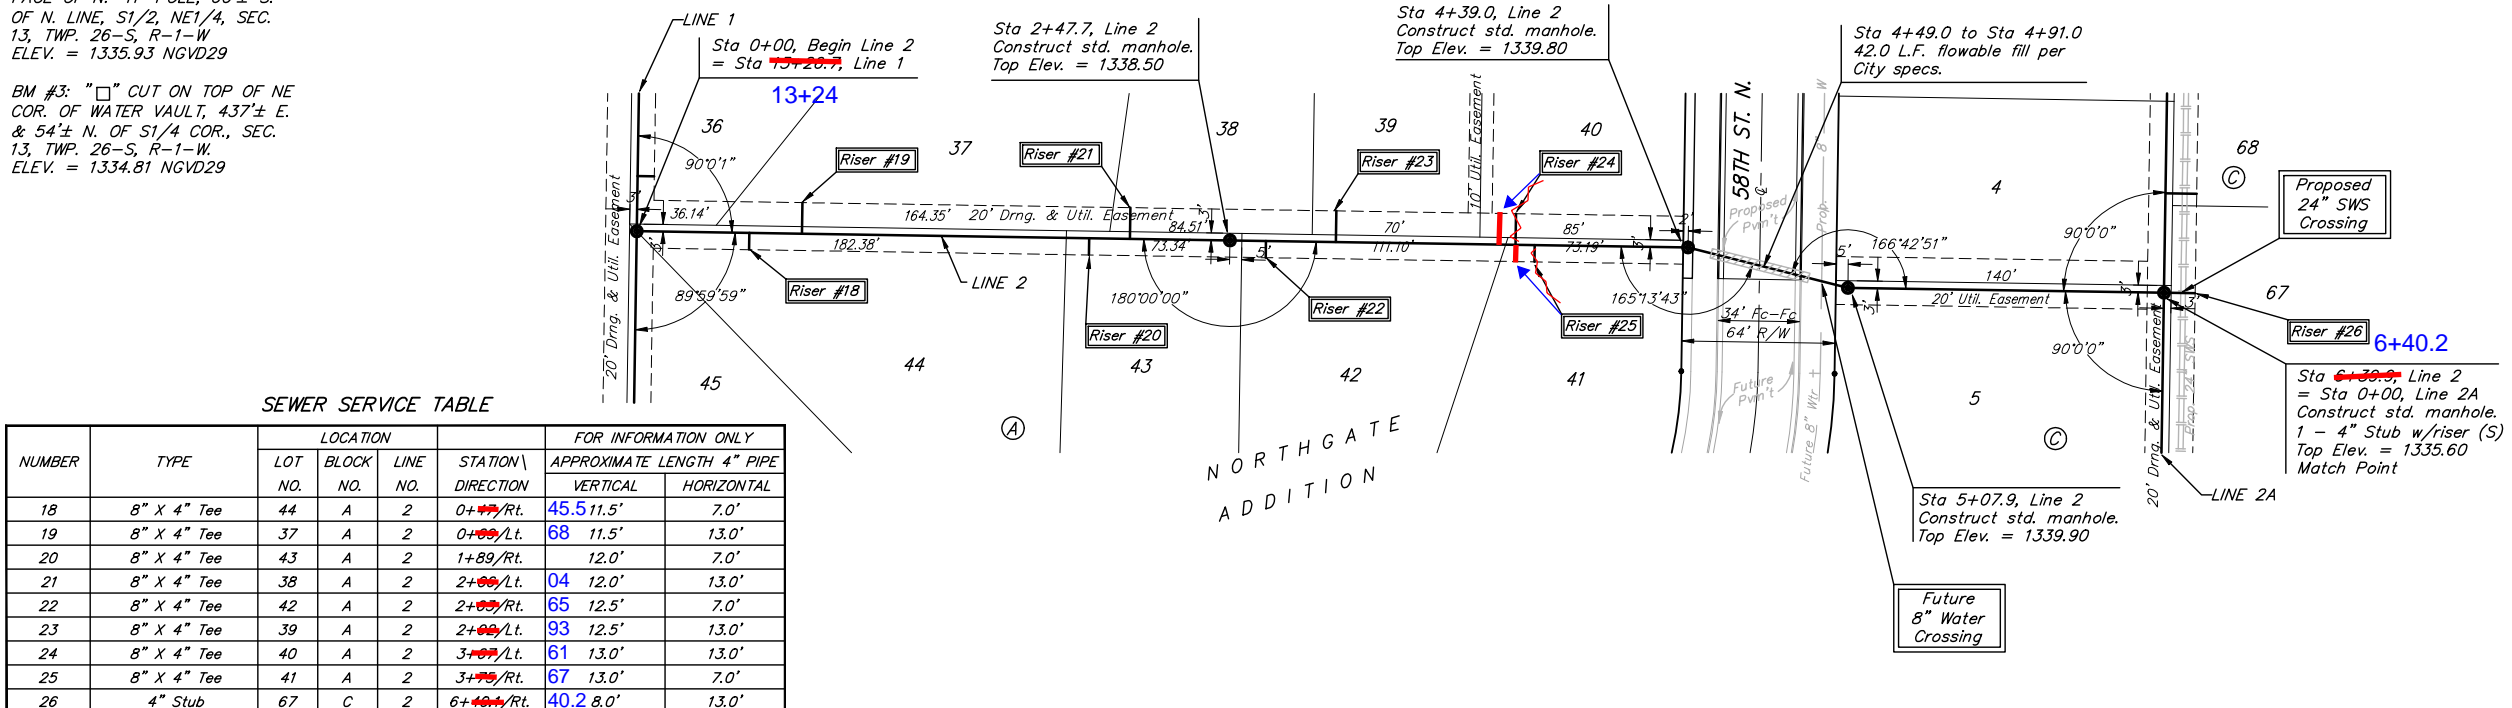

SEWER SERVICE TABLE

NUMBER	TYPE	LOCATION			FOR INFORMATION ONLY	
		LOT NO.	BLOCK NO.	LINE NO.	STATION\ DIRECTION	APPROXIMATE LENGTH 4" PIPE VERTICAL HORIZONTAL
18	8" X 4" Tee	44	A	2	0+00/Rt.	45.5 11.5' 7.0'
19	8" X 4" Tee	37	A	2	0+00/Lt.	68 11.5' 13.0'
20	8" X 4" Tee	43	A	2	1+89/Rt.	12.0' 7.0'
21	8" X 4" Tee	38	A	2	2+00/Lt.	04 12.0' 13.0'
22	8" X 4" Tee	42	A	2	2+00/Rt.	65 12.5' 7.0'
23	8" X 4" Tee	39	A	2	2+00/Lt.	93 12.5' 13.0'
24	8" X 4" Tee	40	A	2	3+00/Lt.	61 13.0' 13.0'
25	8" X 4" Tee	41	A	2	3+00/Rt.	67 13.0' 7.0'
26	4" Stub	67	C	2	6+40.2/Rt.	40.2 8.0' 13.0'

NOTE: Vertical Riser Pipe shall be extended to 2' minimum above ground water elevation and 4' maximum below proposed ground elevation.

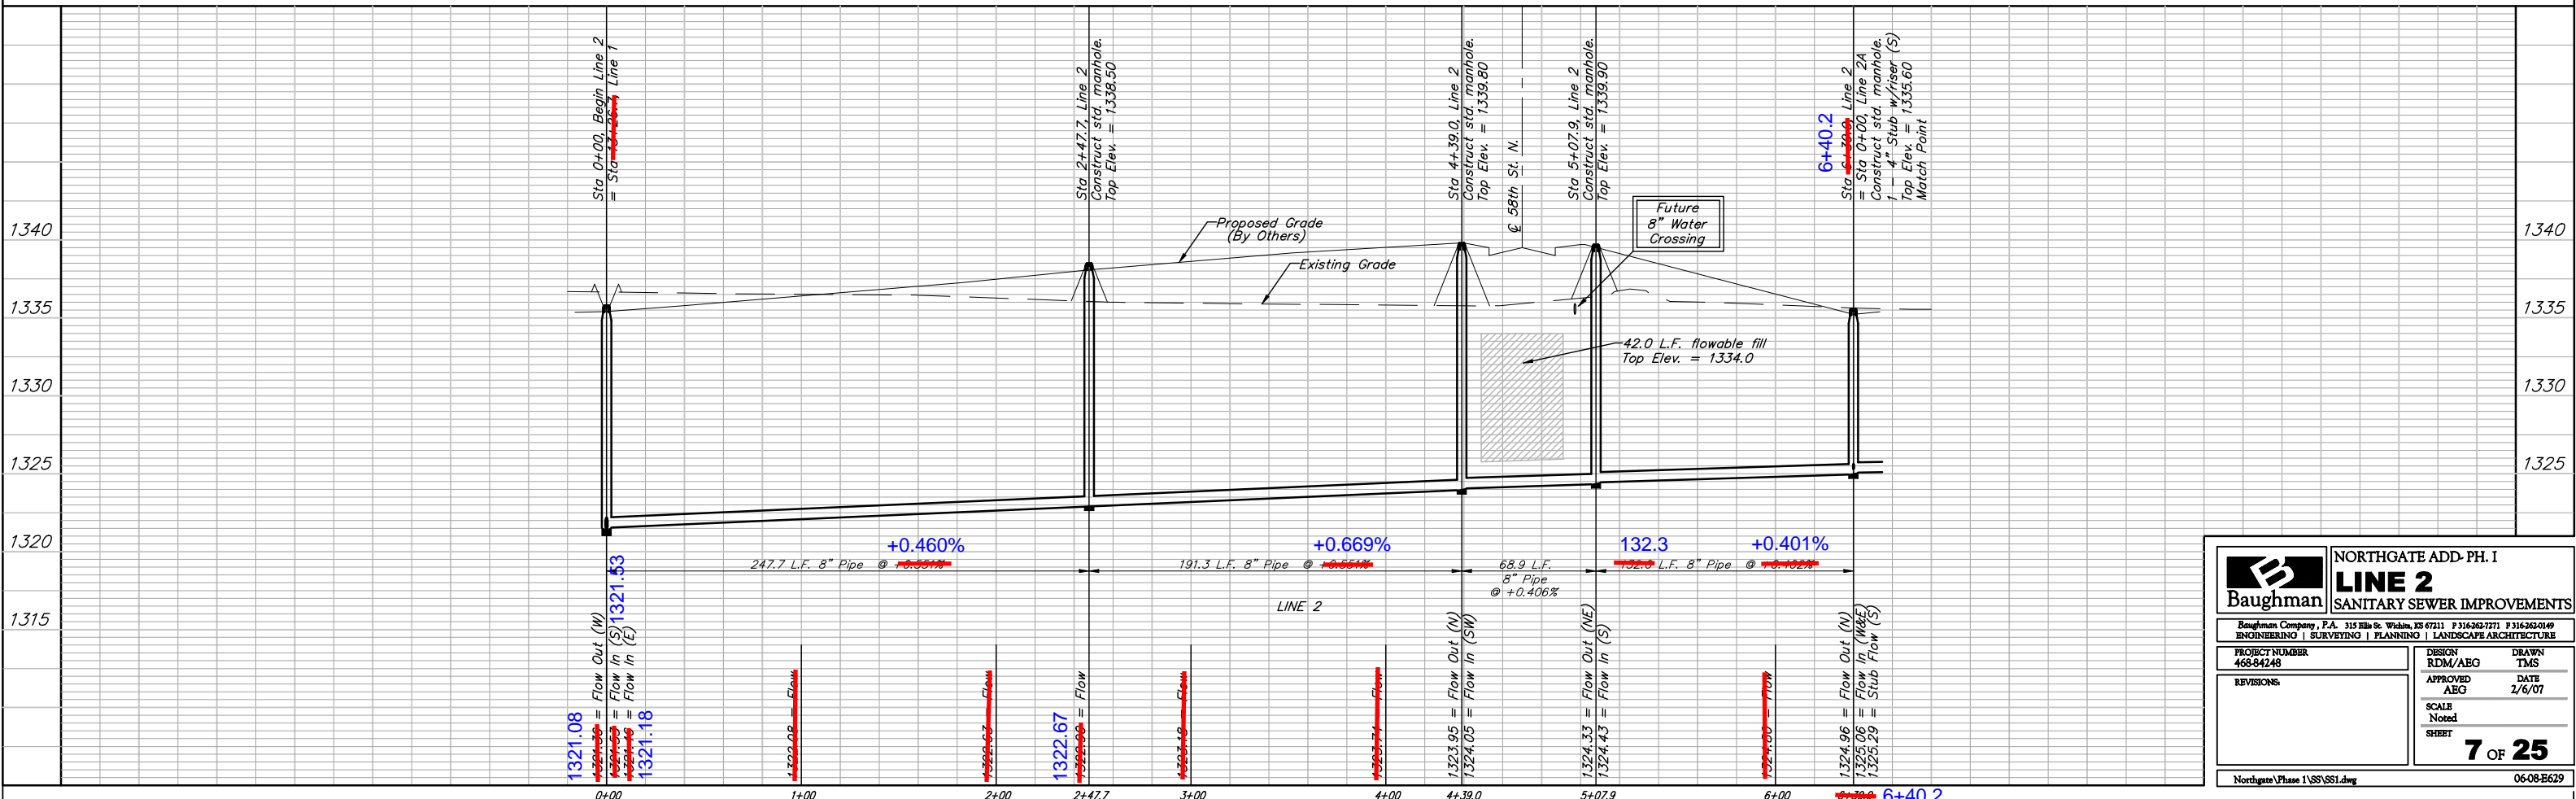

Baughman

ENGINEERING | SURVEYING | PLANNING | LANDSCAPE ARCHITECTURE

PROJECT NUMBER: 468-84248

DESIGN: RDM/ABG
 APPROVED: ABG
 SCALE: Noted
 SHEET: 7 OF 25

NORTHGATE ADD. PH. I

LINE 2

SANITARY SEWER IMPROVEMENTS

DATE: 2/6/07

Northgate Phase 1\SS\SS1.dwg