

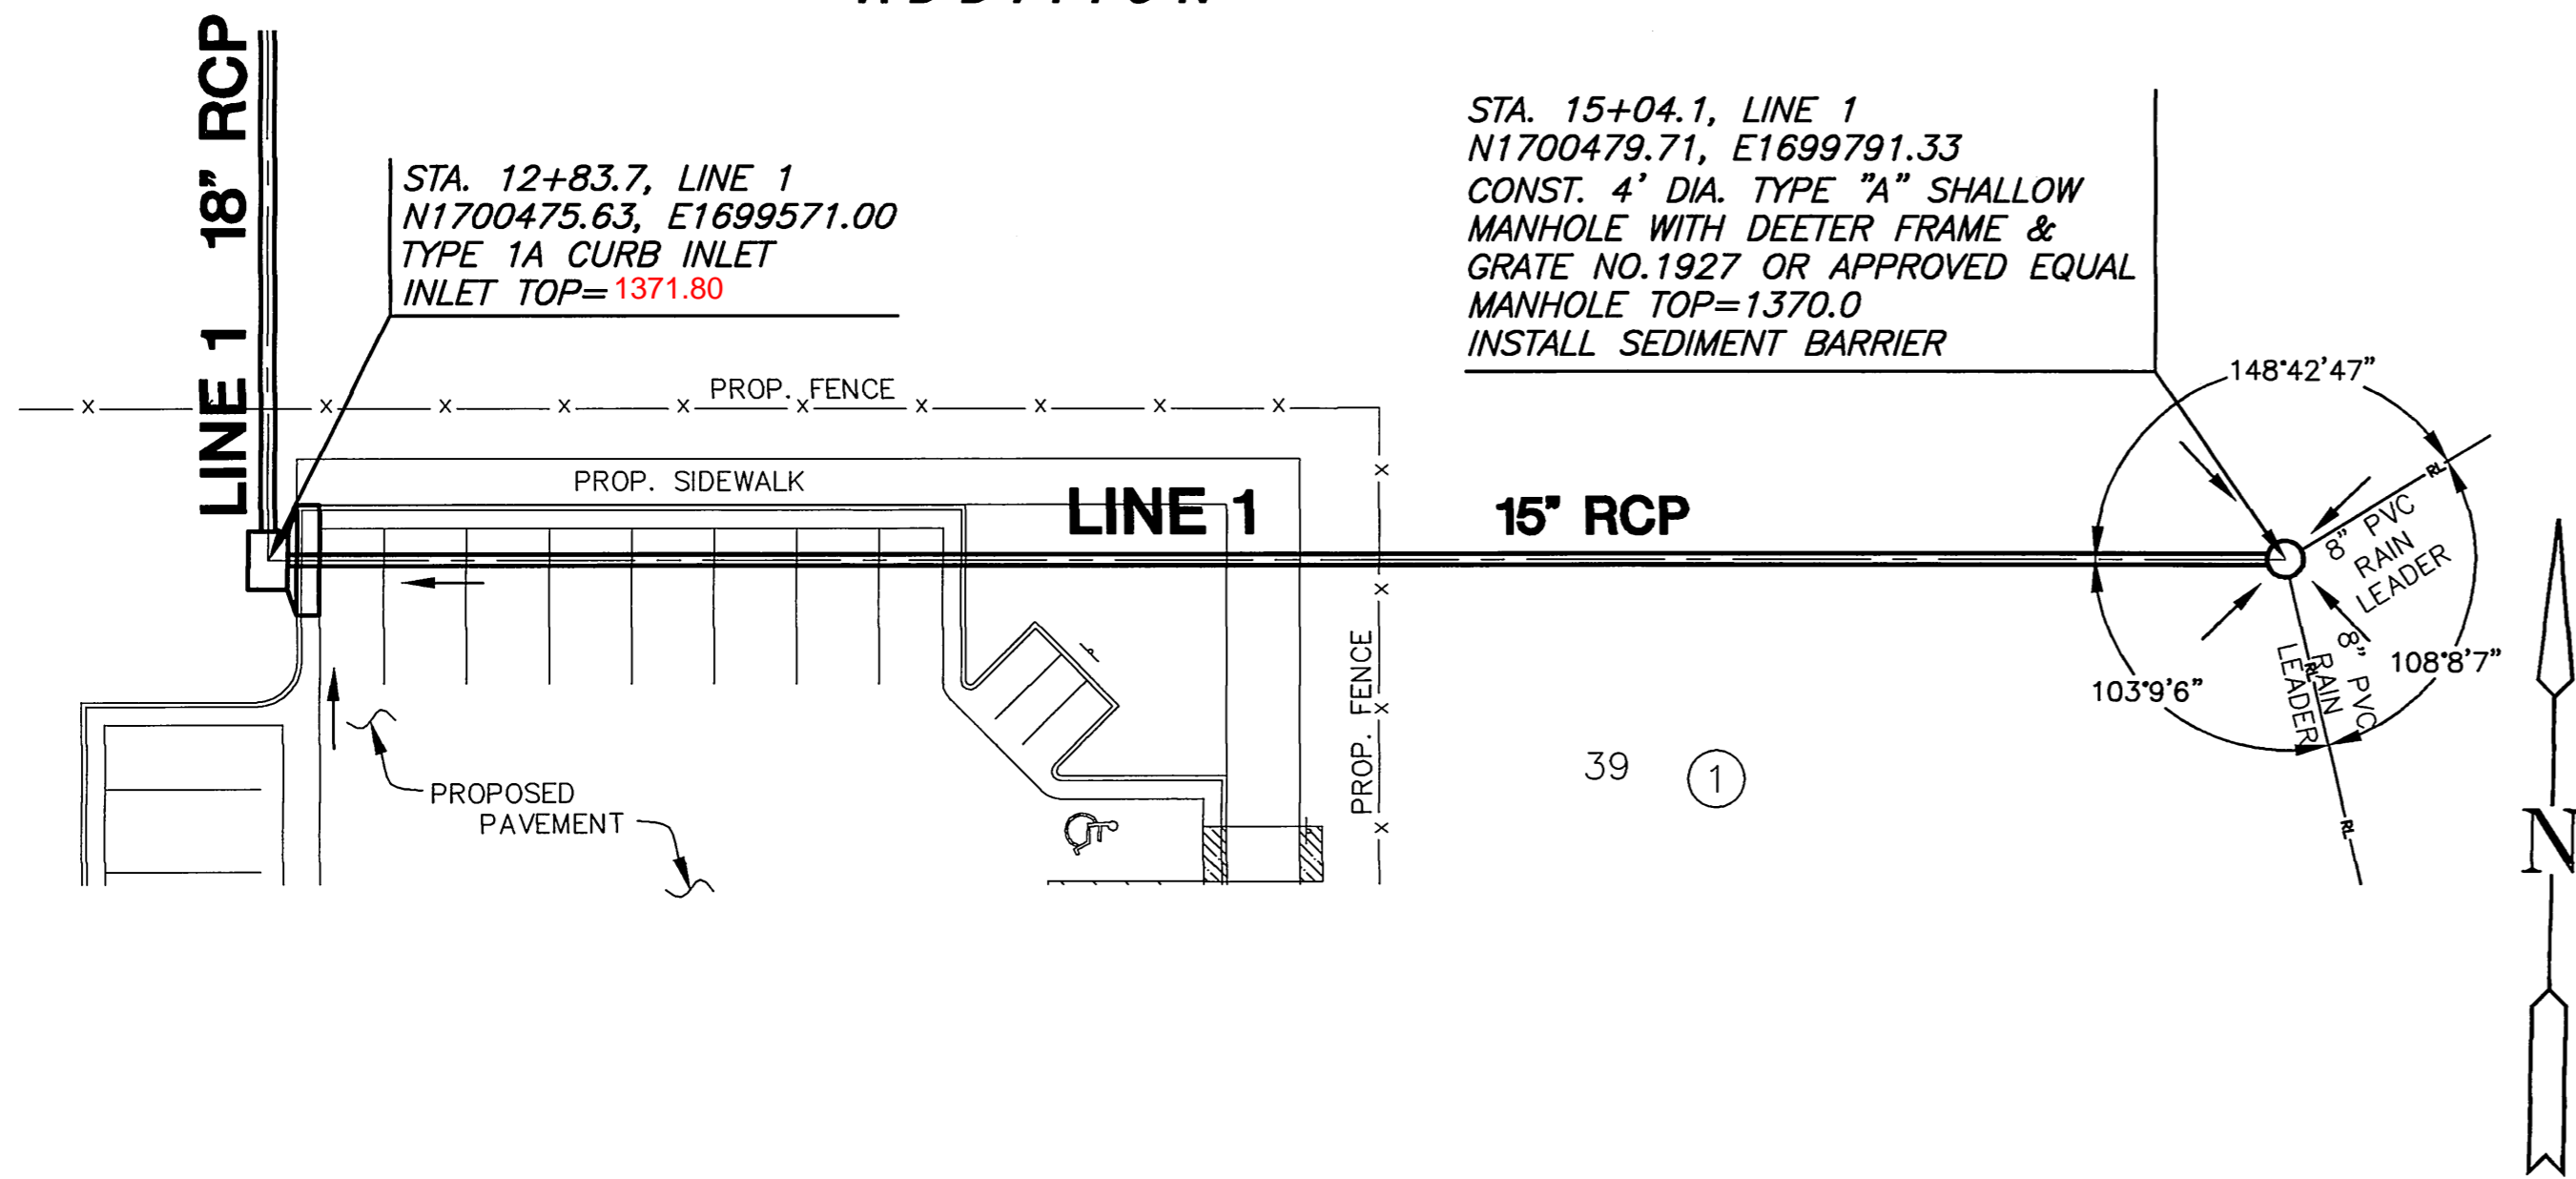




**MONARCH LANDING
ADDITION**

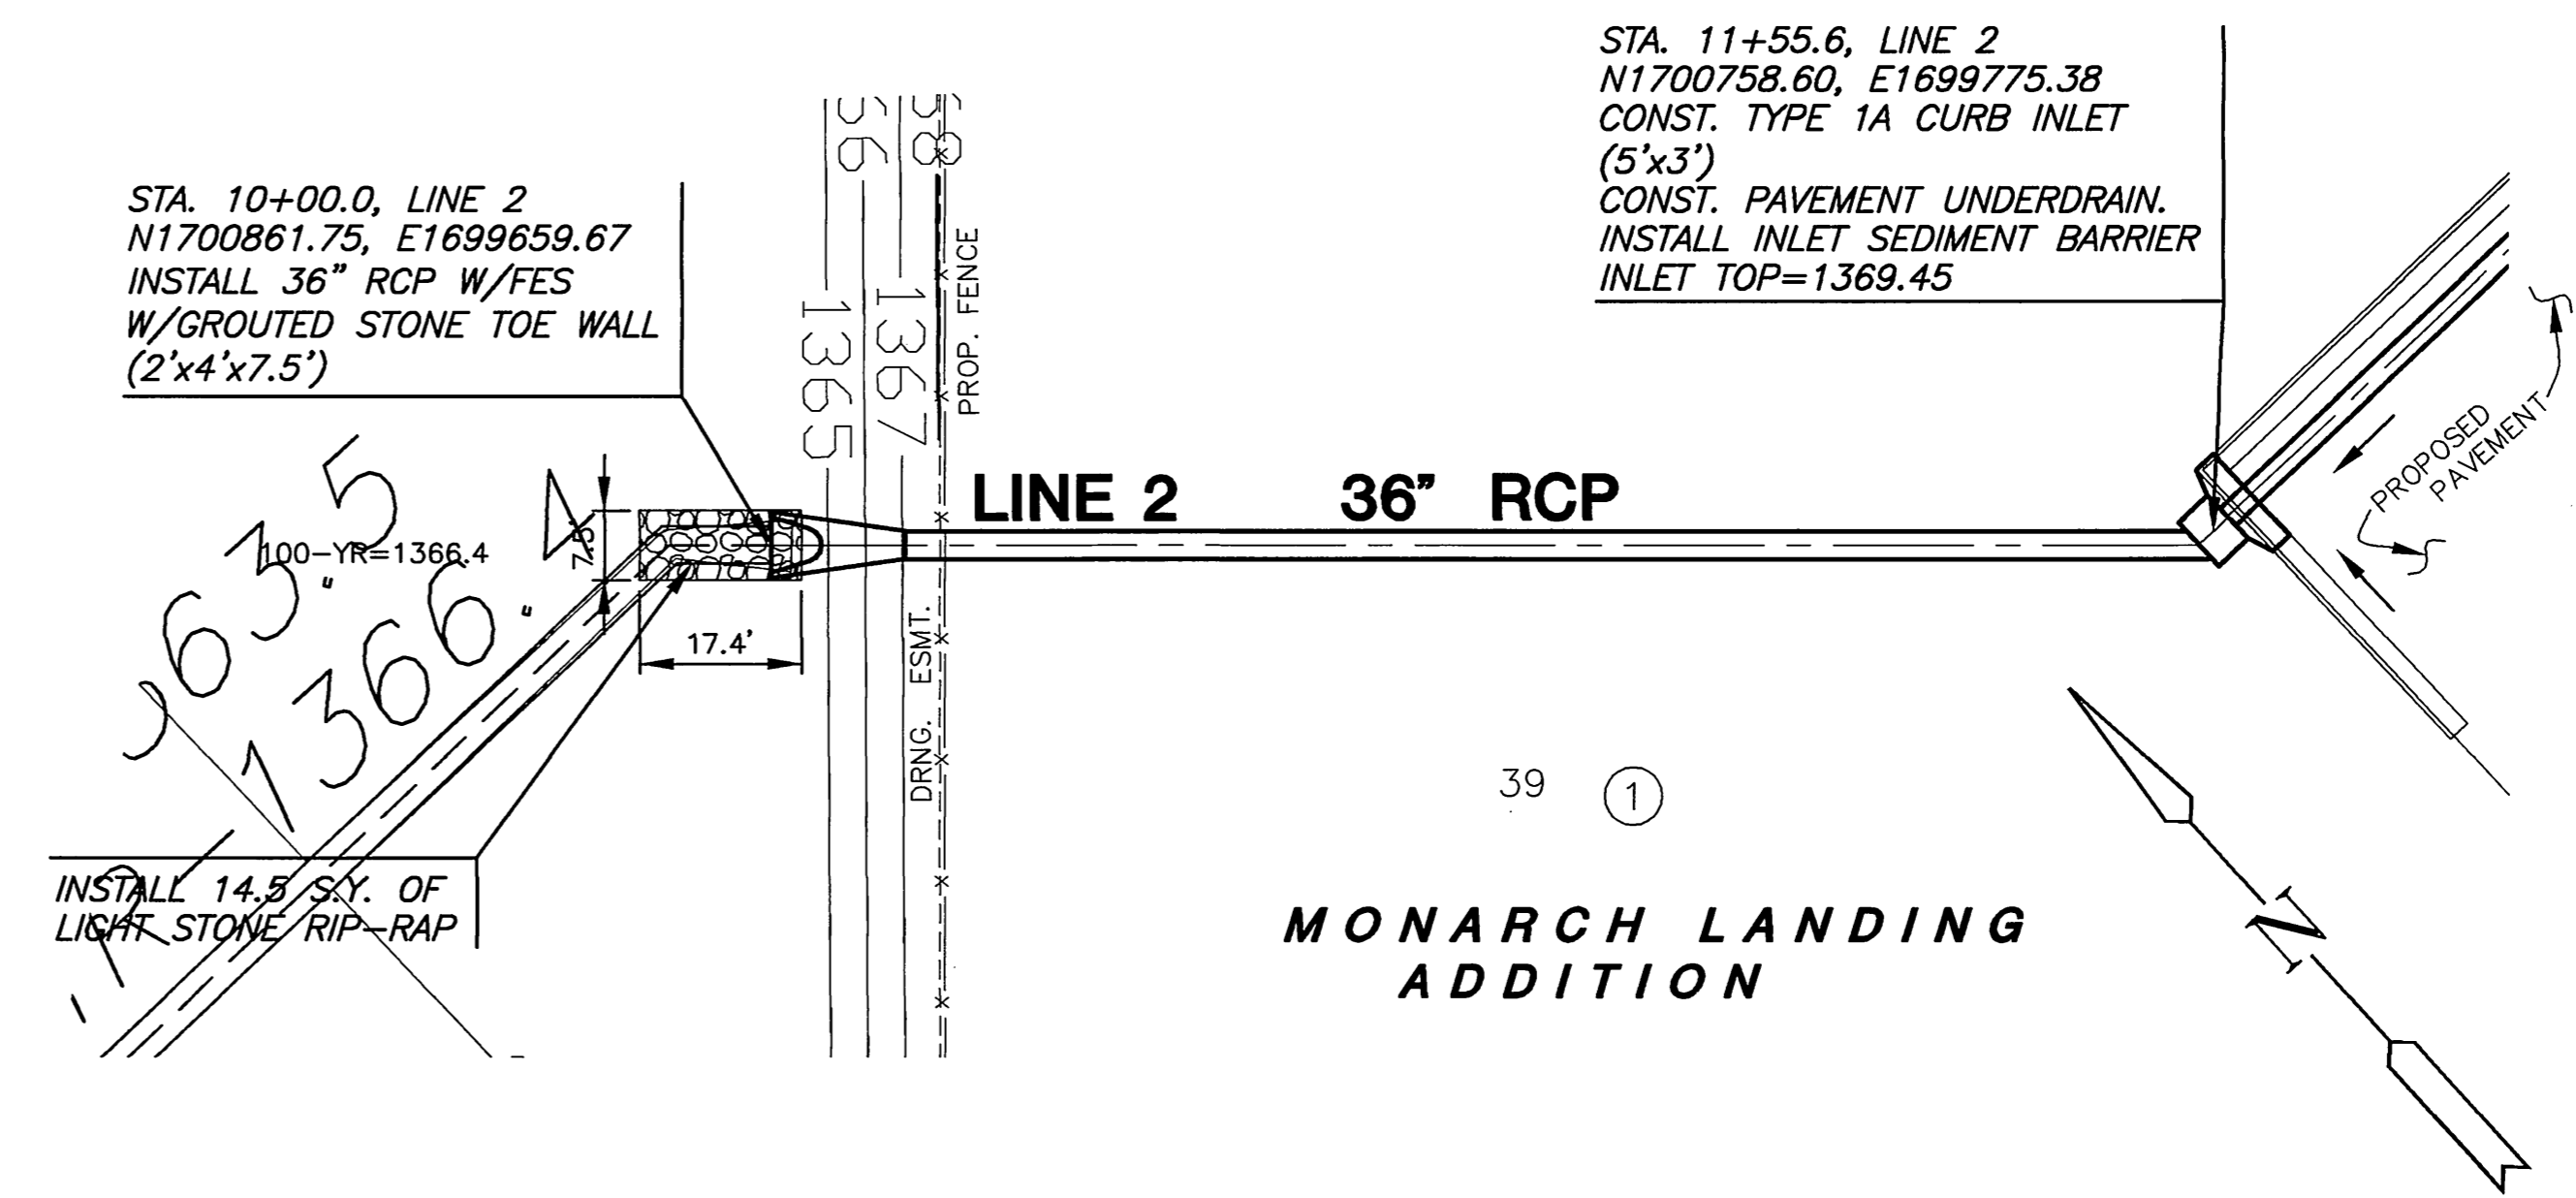

PLAN LINE 1

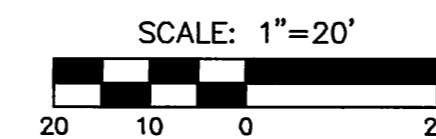


PLAN LINE 2

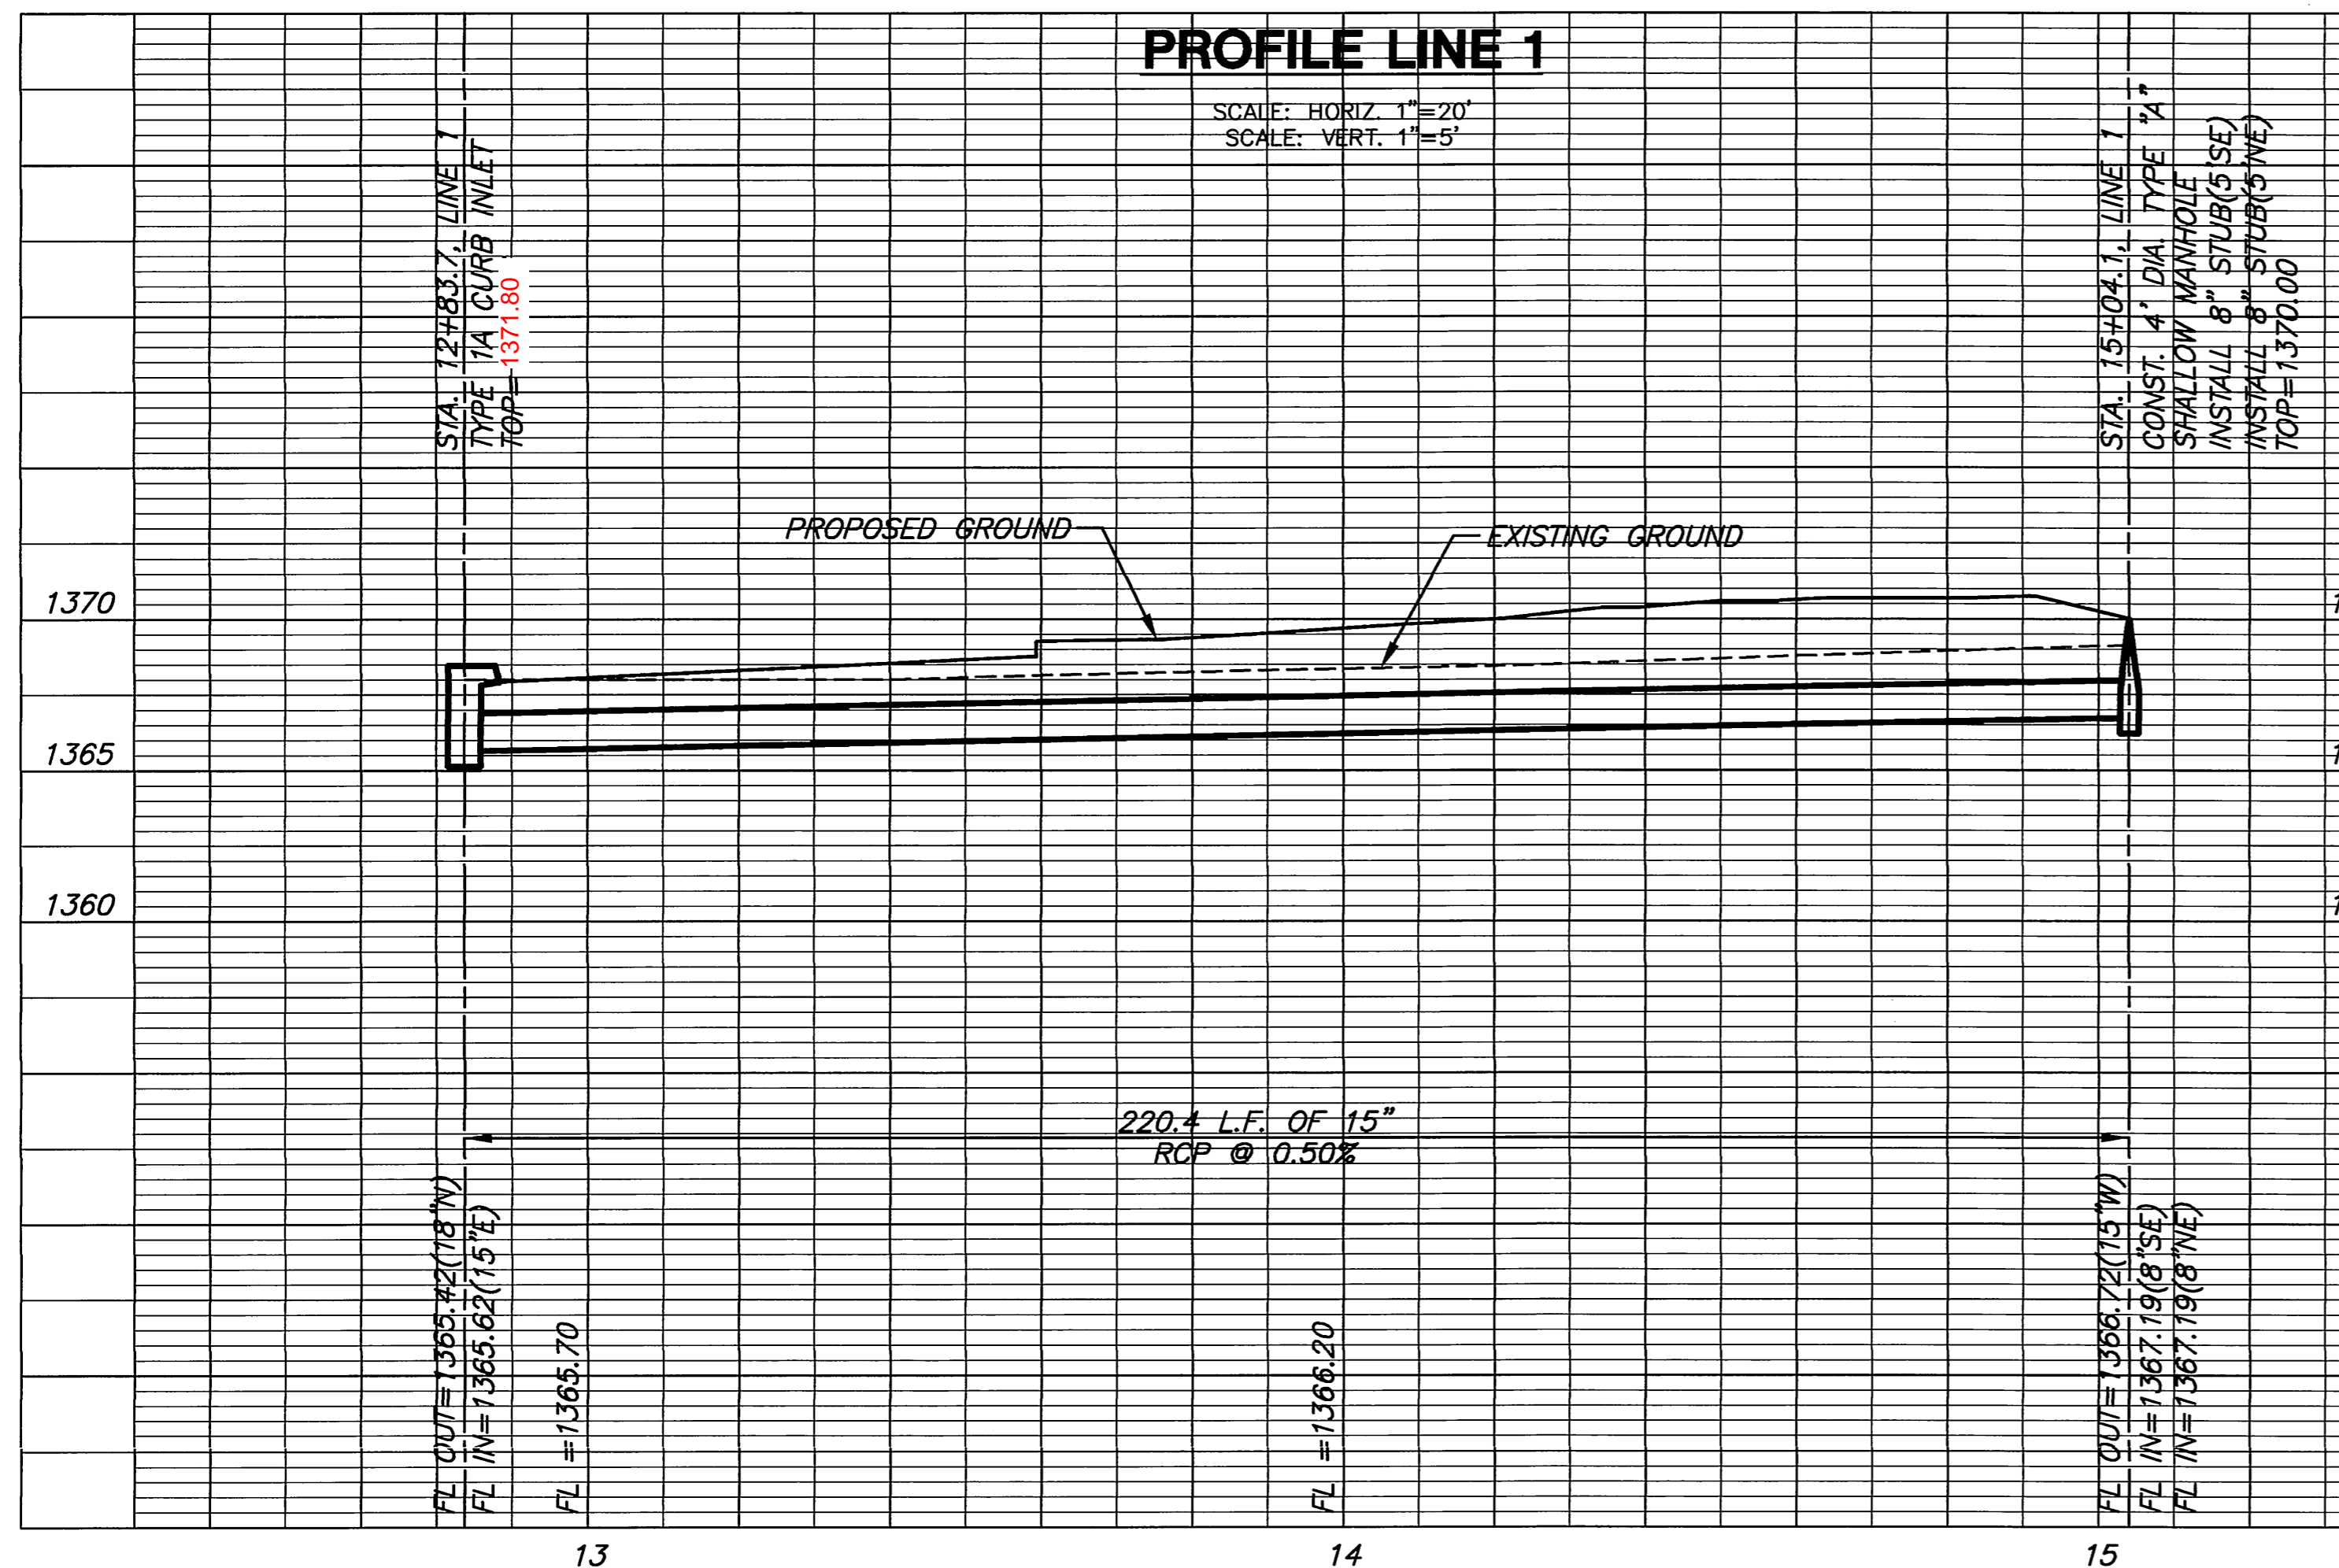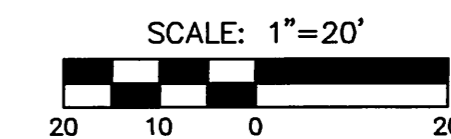

PROFILE LINE 1

SCALE: HORIZ. 1"=20'
SCALE: VERT. 1"=5'

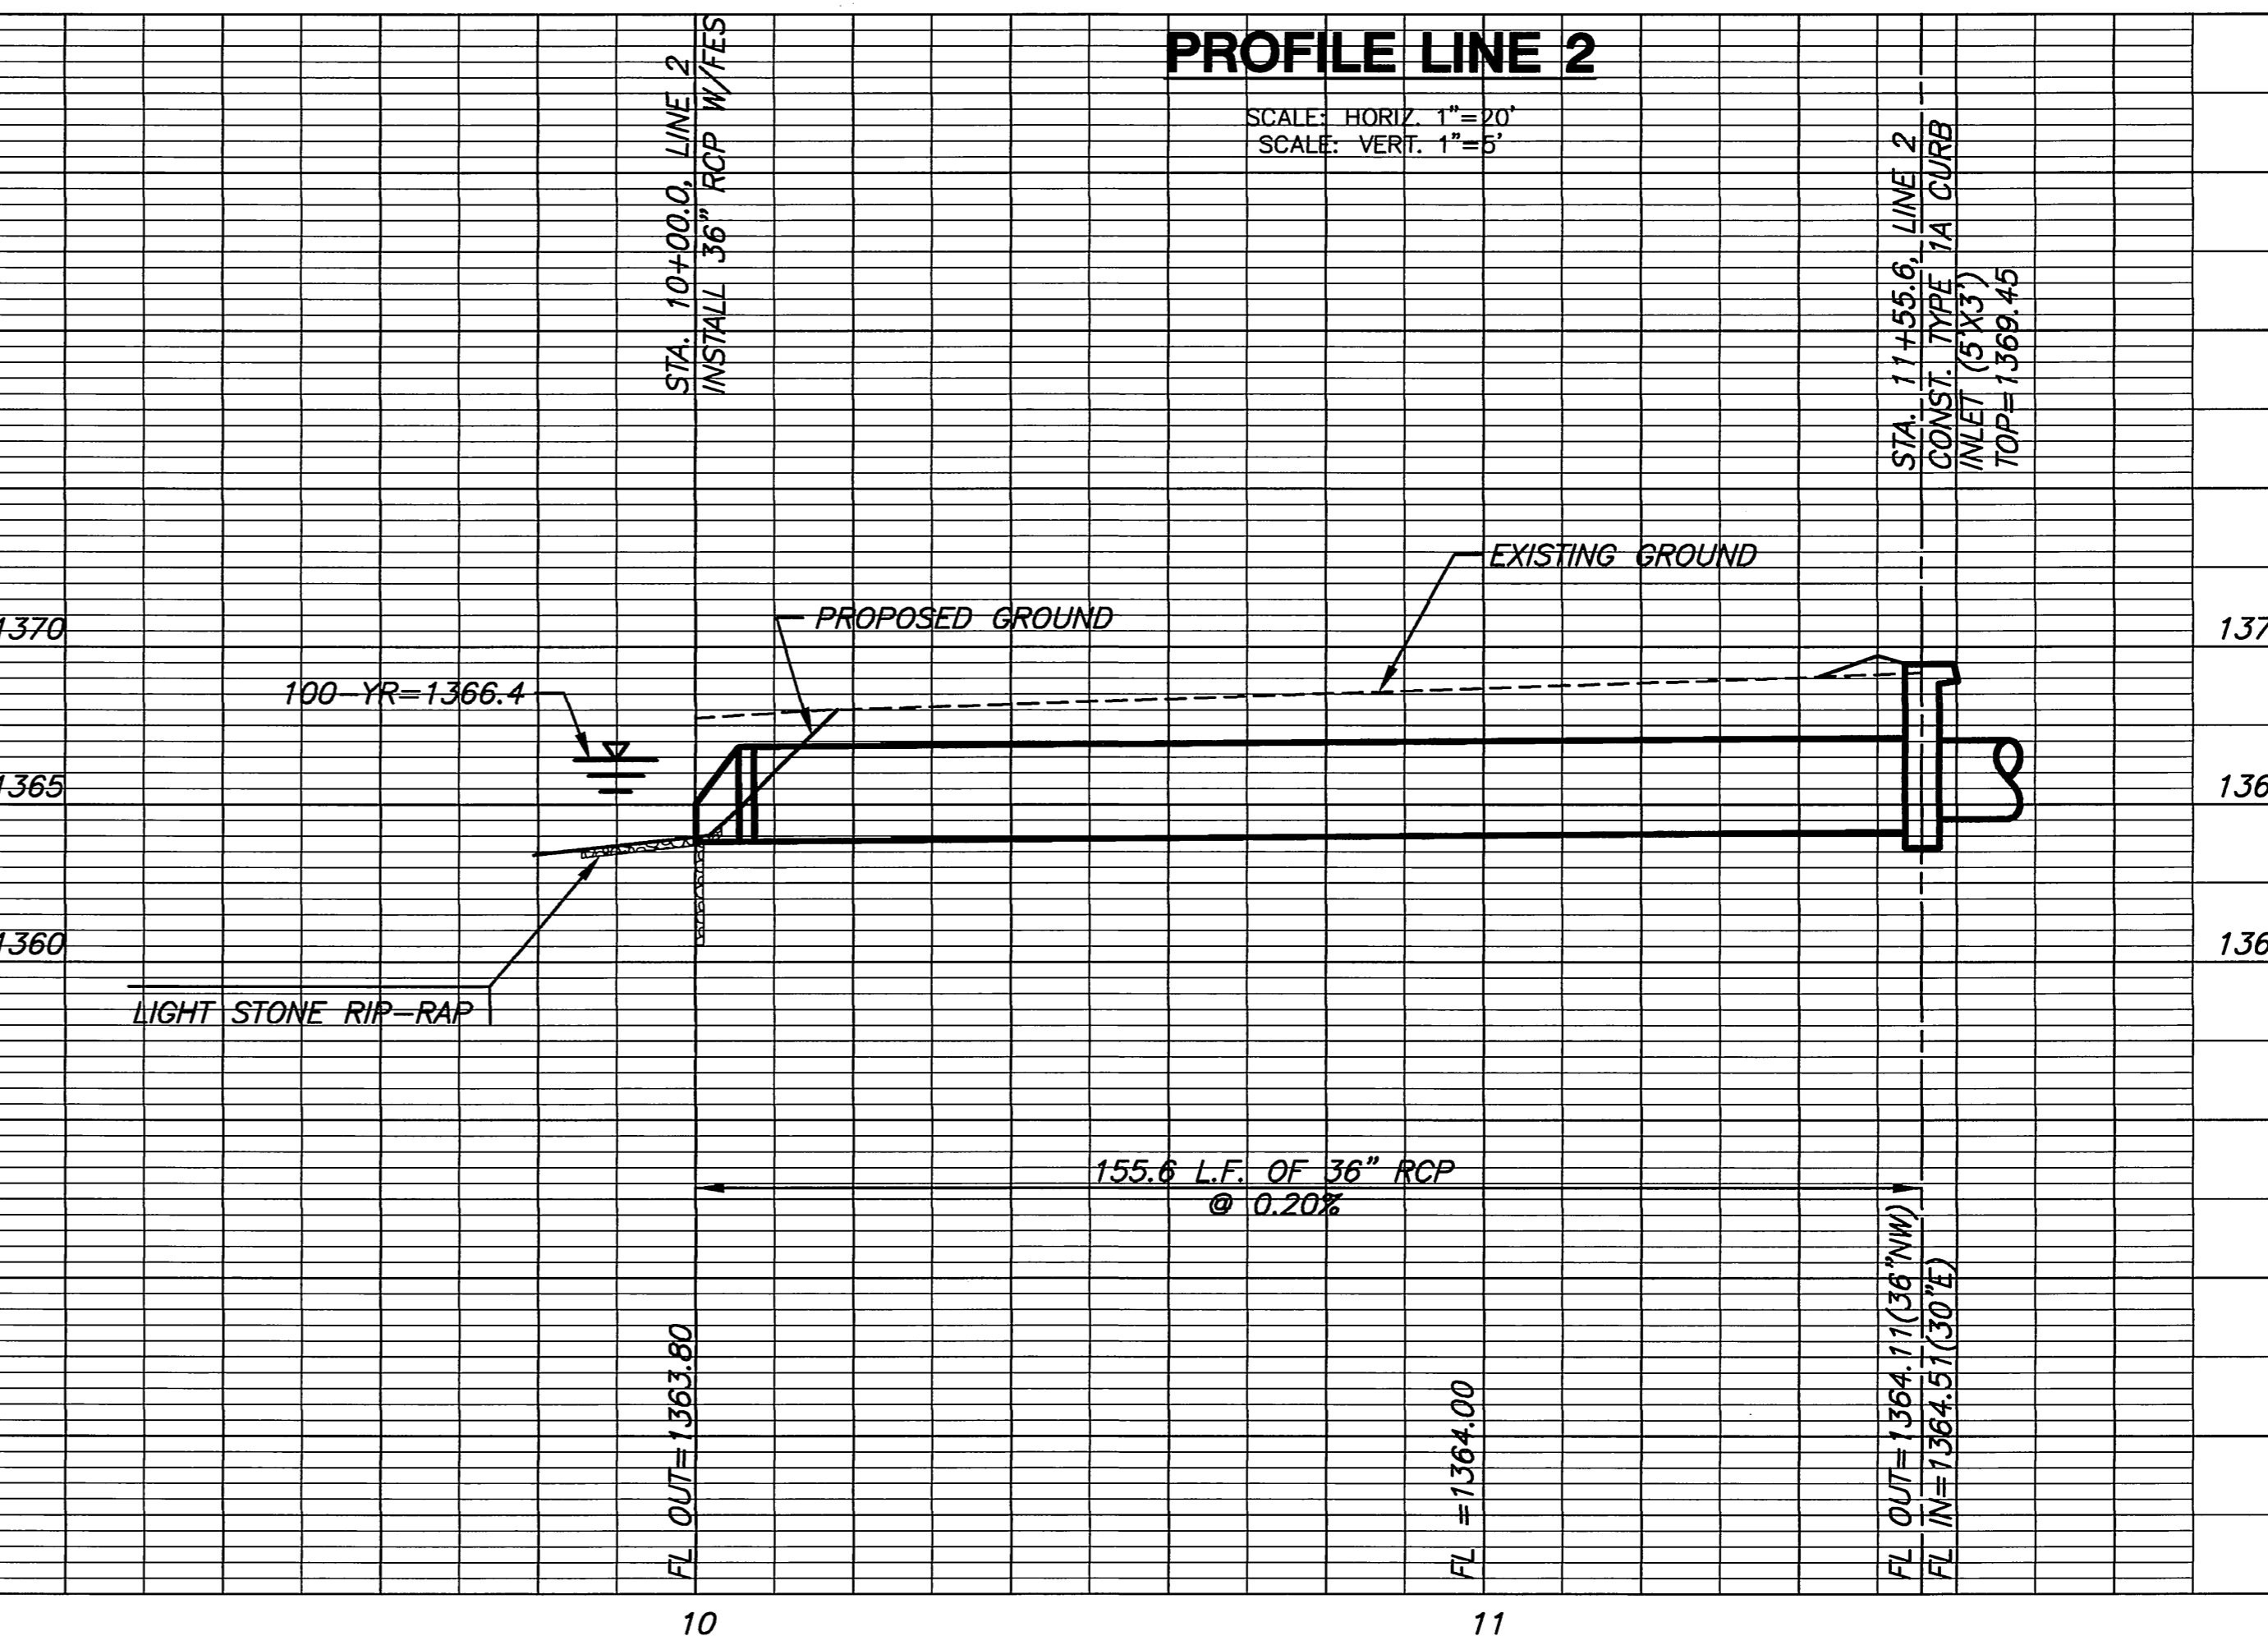


PROFILE LINE 2

SCALE: HORIZ. 1"=20'
SCALE: VERT. 1"=5'

PLOTTED: Monday, March 19, 2007 @ 12:03PM

MKEC
ENGINEERING
CONSULTANTS, INC.
411 N. WEBB ROAD
WICHITA, K.S. 67206
316-684-9600

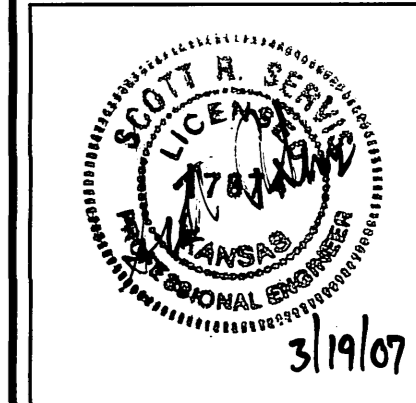

STORM WATER SEWER PLANS
ANDOVER ELEMENTARY SCHOOL #2
LOT 39, BLOCK 1 MONARCH LANDING ADDITION

LINES 1 & 2
SHEET TITLE
06544
PROJECT NUMBER

DESIGN BY: **SRS**
DRAWN BY: **MK**
CHECKED BY: **MAB**

ISSUED: **MARCH 2007**
REVISED:

SHEET NO.
2 of 5