


SEWER SERVICE TABLE

NUMBER	TYPE	LOCATION			FOR INFORMATION ONLY		
		LOT NO.	BLOCK NO.	LINE NO.	STATION \ DIRECTION	APPROXIMATE LENGTH 4" PIPE	VERTICAL
41	8" X 4" Tee Saddle	42	1	3	10+58/L 69	22'	18' 11"
42	8" X 4" Tee Saddle	43	1	3	11+58/L 59	22'	18' 12"
43	8" X 4" Tee Saddle	44	1	3	12+58/L 50	21'	18' 12"
44	4" MH Riser	59	1	3	18+79/L 19+05	15'	18' 11"
45	8" X 4" Tee Saddle	60	1	3	19+37/L 38	15'	18' 10.85"
46	8" X 4" Tee Saddle	UNPLATTED			20+37/L 41	15'	18' 11"

NOTE: Vertical Riser Pipe shall be extended to 2' minimum above ground water elevation and 4' maximum below proposed ground elevation.

NOTE: ALL BACKFILL FOR SHALL BE SAND FLUSHED AND VIBRATED.

SCALE 1" = 40' HORIZ.
1" = 5' VERT.
IRON = ●

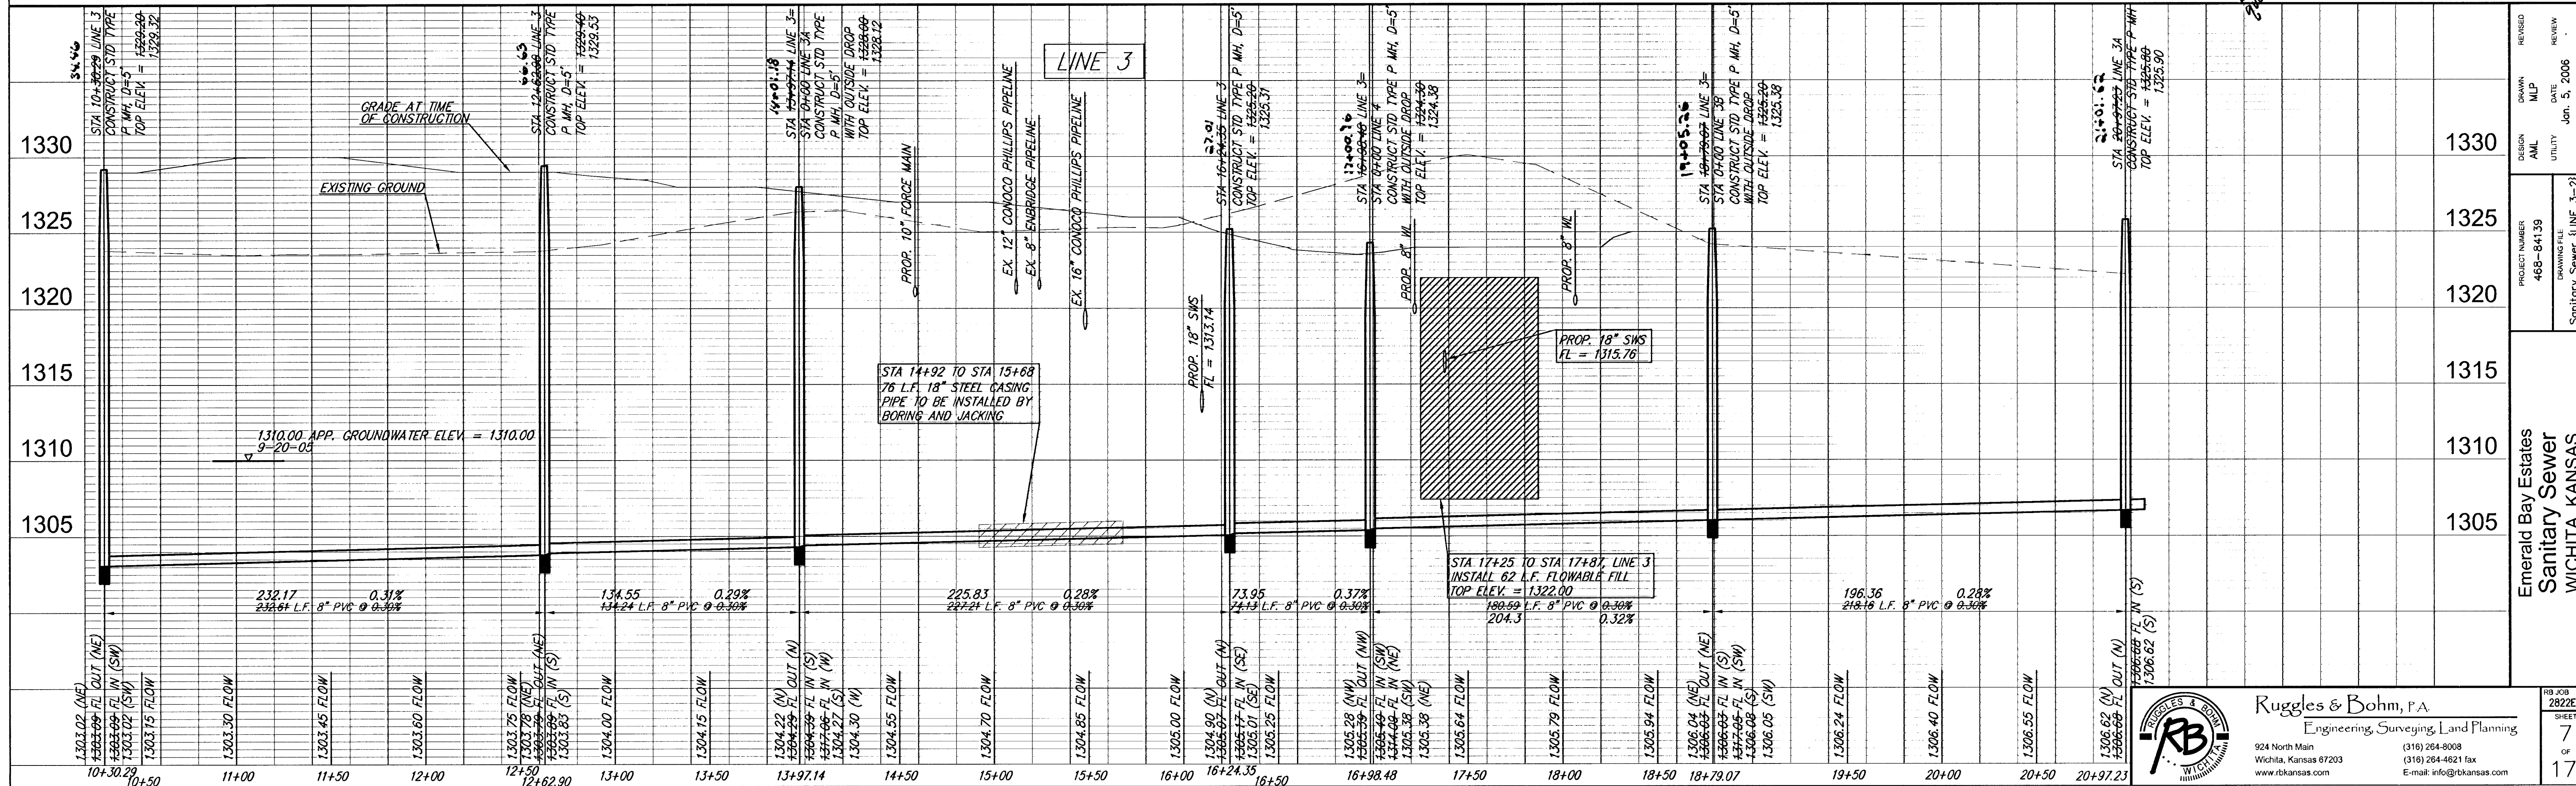

Ruggles & Bohm, P.A.
Engineering, Surveying, Land Planning

924 North Main
Wichita, Kansas 67203
www.rbkansas.com

(316) 264-8008
(316) 264-4621 fax
E-mail: info@rbkansas.com

PROJECT NUMBER: 468-84139
DRAWING FILE: Sanitary Sewer (LINE 3-2)

DESIGN: AML
MPL
UTILITY

DATE: Jun. 5, 2006
REVIEW

RB JOB: 2822E
SHEET: 7
OF: 17