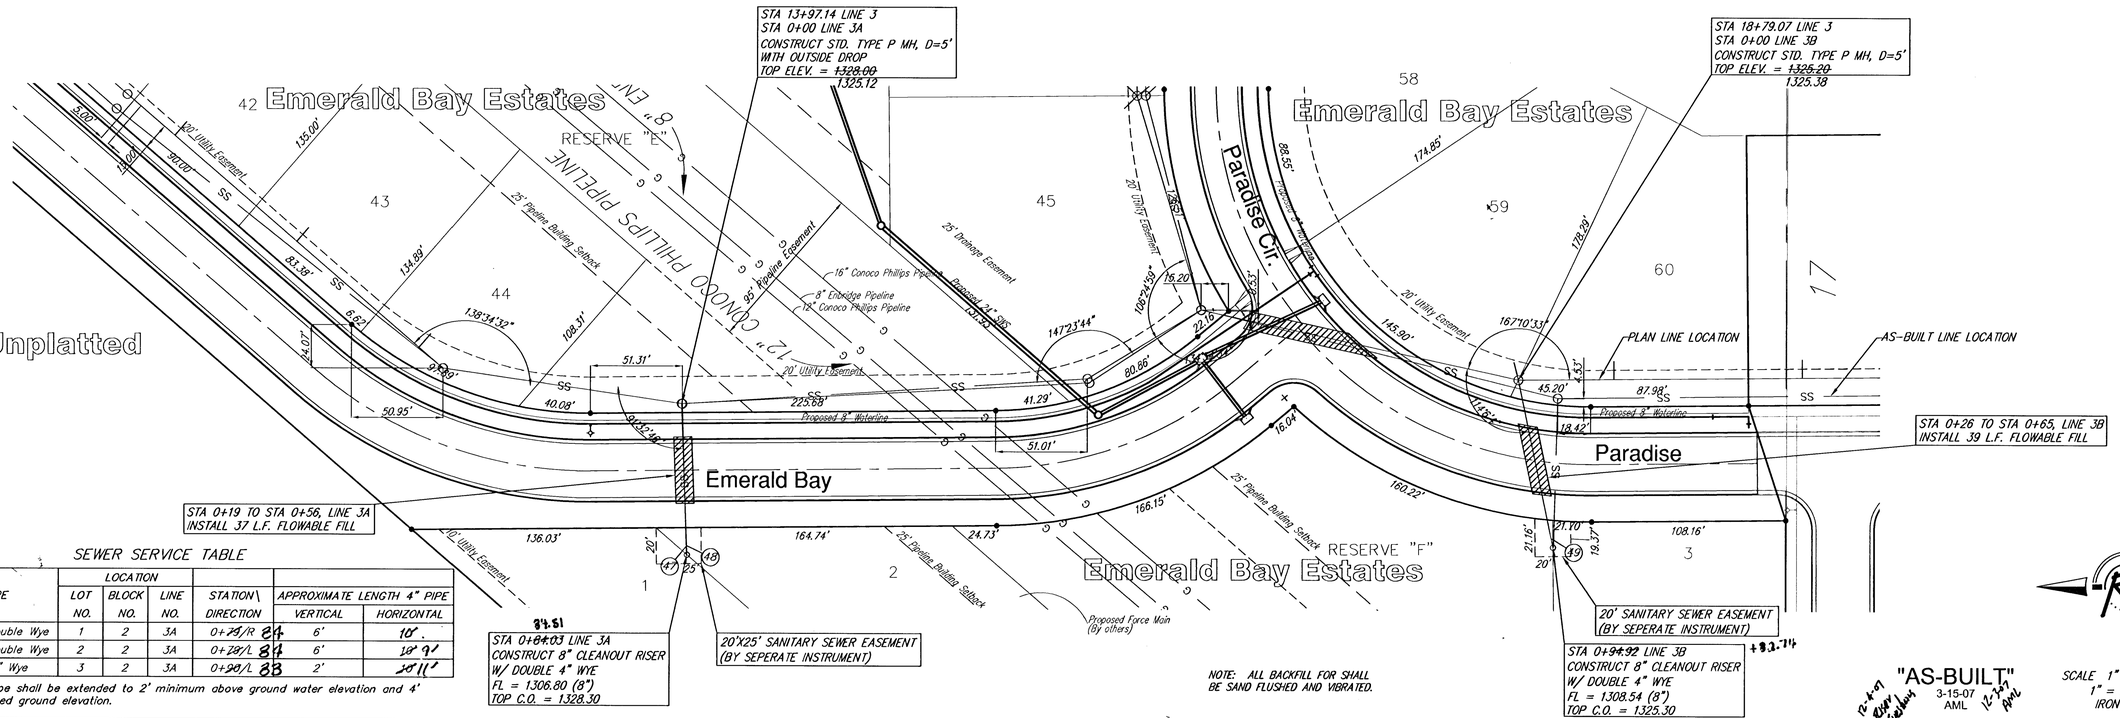

SEWER SERVICE TABLE

NUMBER	TYPE	LOCATION			STATION\ DIRECTION	APPROXIMATE LENGTH 4" PIPE	
		LOT NO.	BLOCK NO.	LINE NO.		VERTICAL	HORIZONTAL
47	8" X 4" Double Wye	1	2	3A	0+~~75~~/R 84	6'	10'.
48	8" X 4" Double Wye	2	2	3A	0+~~28~~/L 84	6'	18' 9'
49	8" X 4" Wye	3	2	3A	0+90/L 88	2'	20' 11'

NOTE: Vertical Riser Pipe shall be extended to 2' minimum above ground water elevation and 4' maximum below proposed ground elevation.

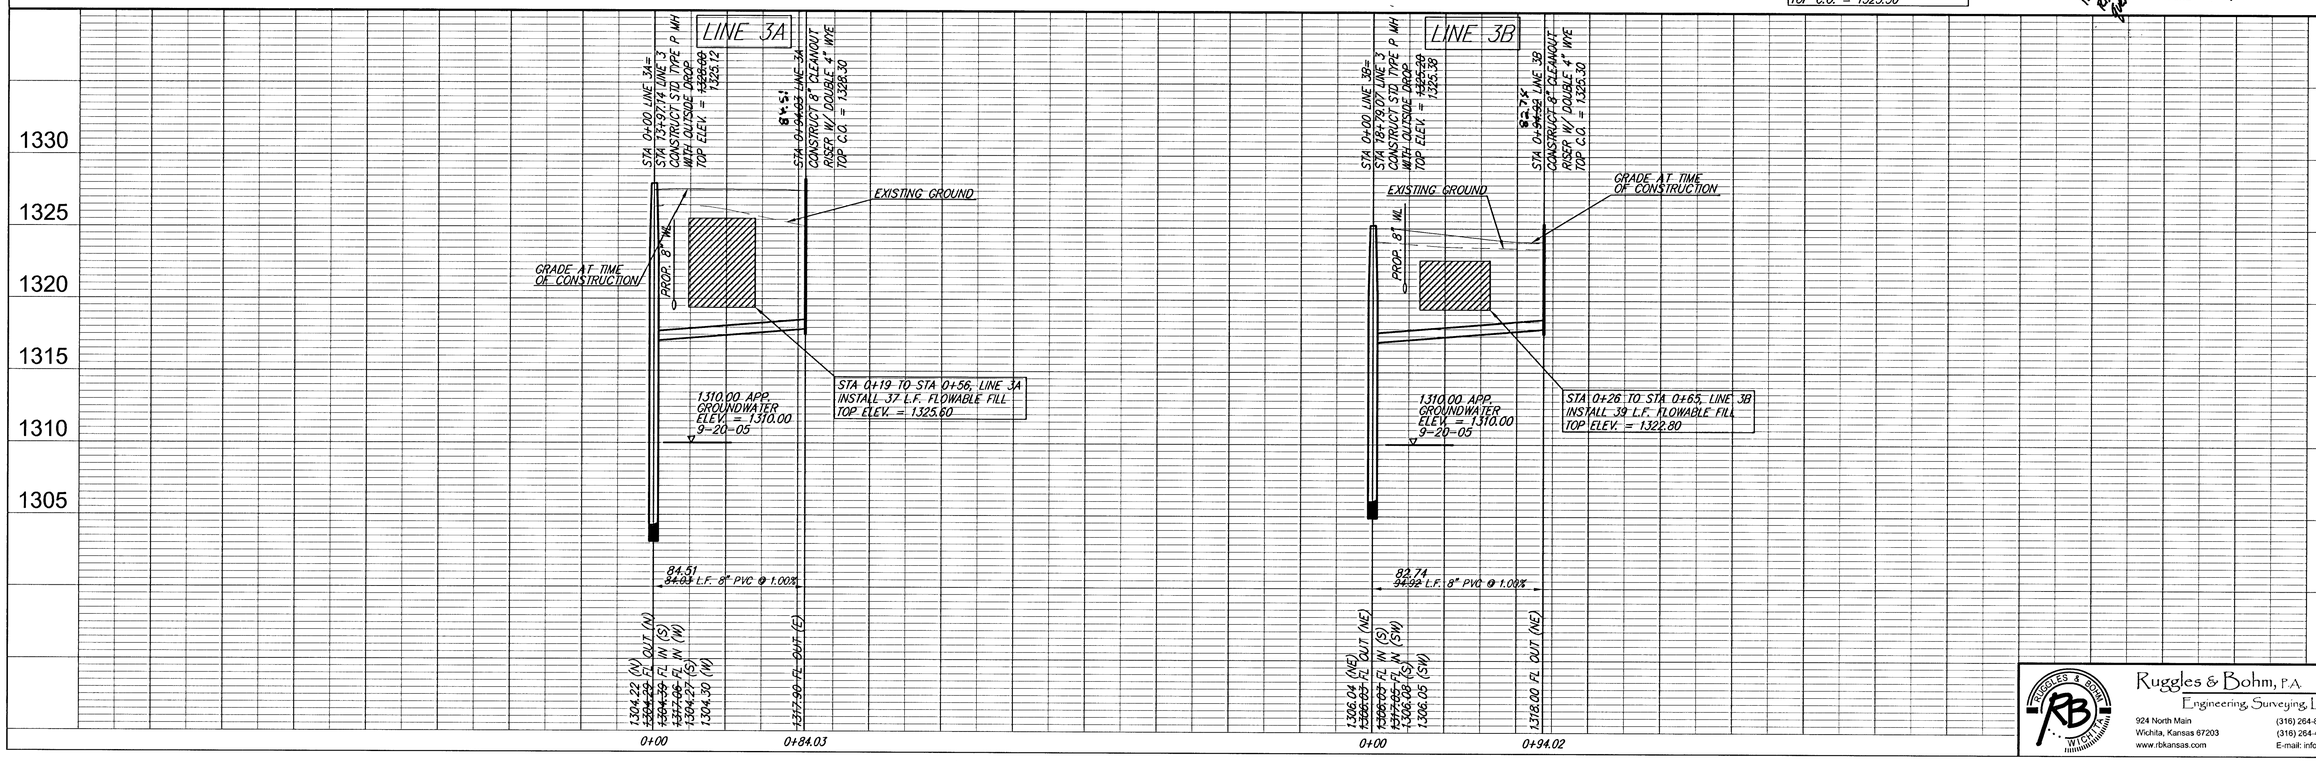

Emerald Bay Estates
Sanitary Sewer
WICHITA, KANSAS

DESIGN AML	DRAWN MLP
UTILITY	DATE Jan. 5, 2006
PROJECT NUMBER 468-84139	DRAWING FILE Sanitary Sewer {LINE 3A-B}
REVISED	REVIEW

Ruggles & Bohm, P.A.
Engineering, Surveying, Land Planning
924 North Main
Wichita, Kansas 67203
www.rbkansas.com
(316) 264-8008
(316) 264-4621 fax
E-mail: info@rbkansas.com

RB JOB 2822E