
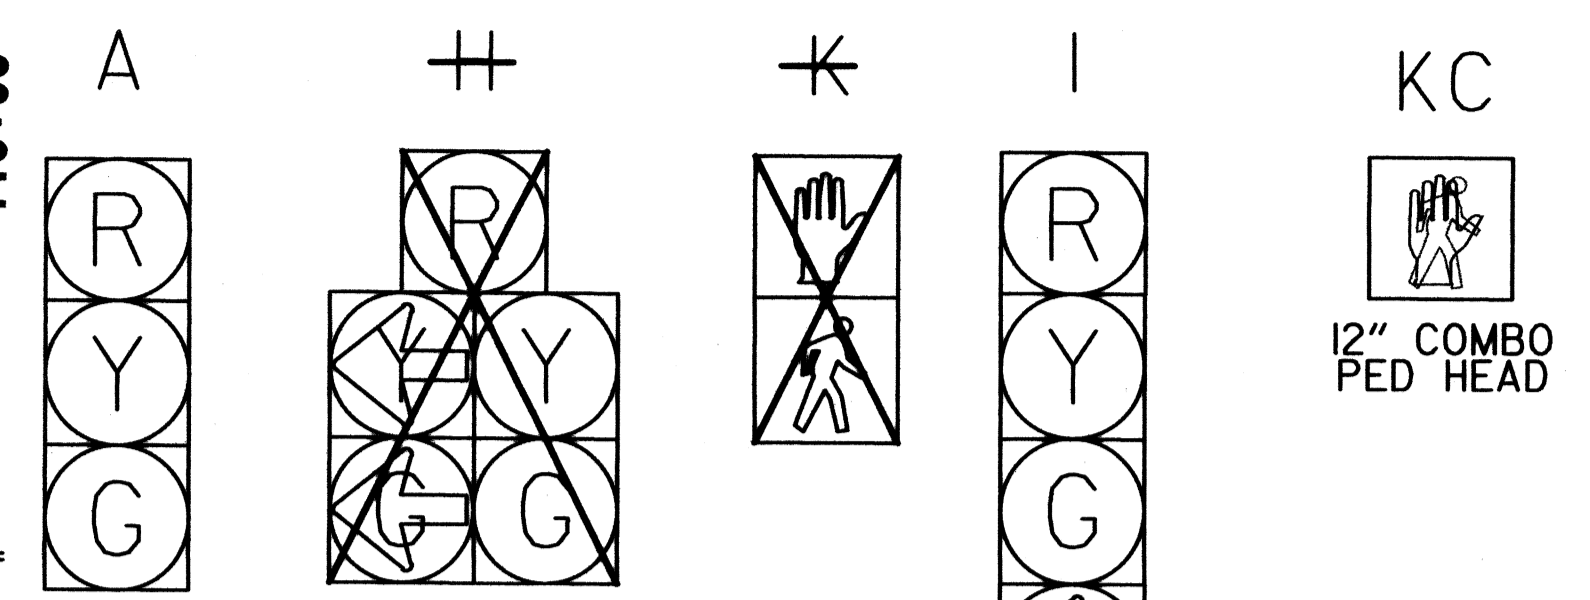


| REVISIONS | | |
|-----------|------------------|----------|
| NO. | DESCRIPTION | DATE |
| 1 | REVISED SIDEWALK | 01/30/07 |

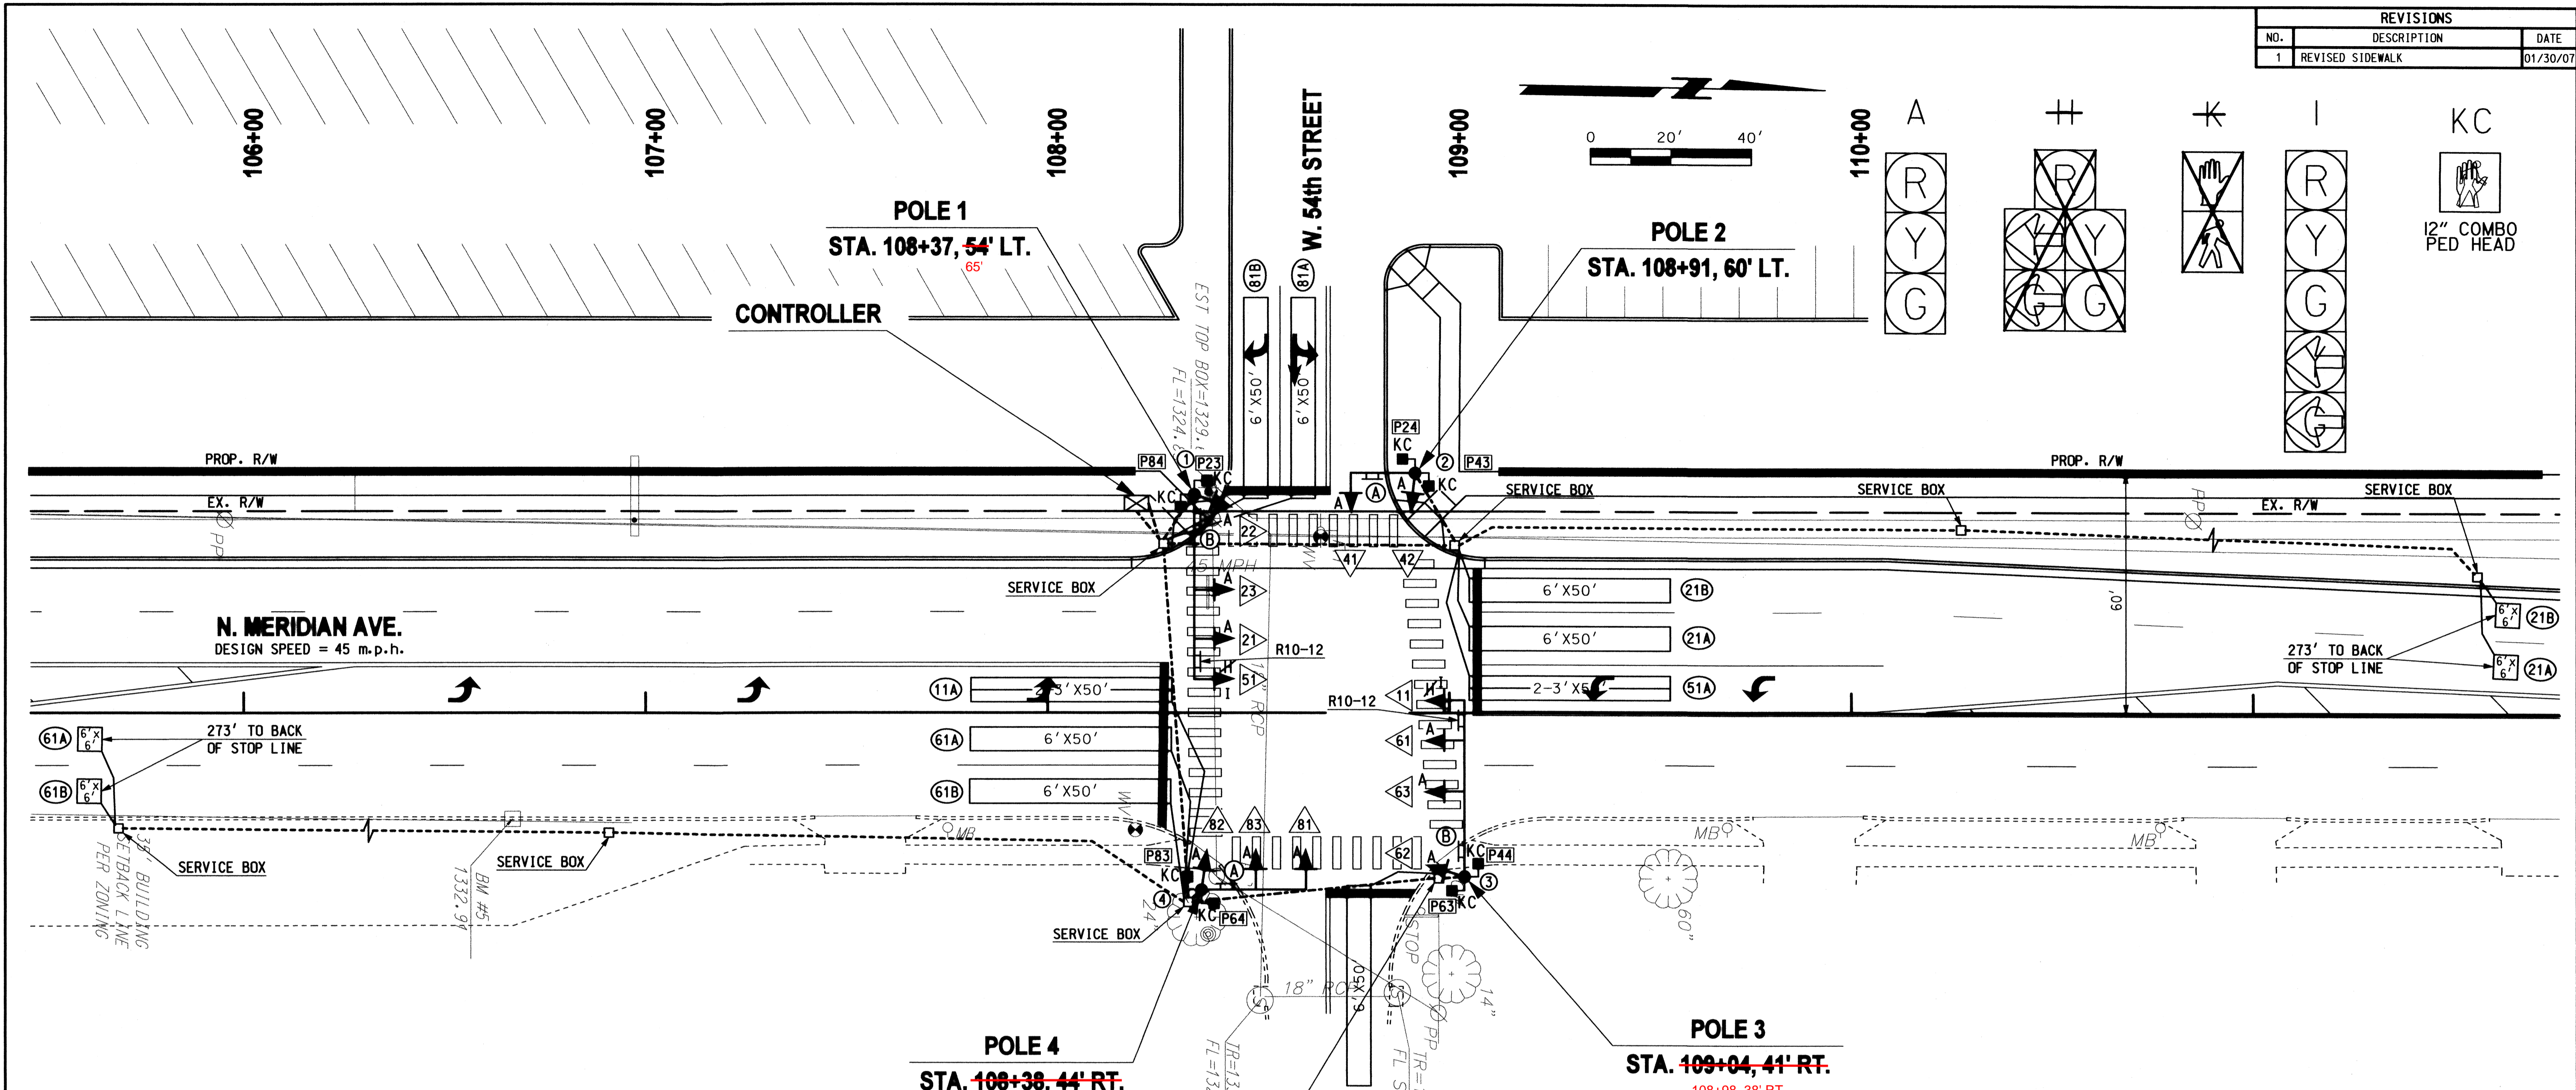

CAUTION
CONTRACTOR TO VERIFY UTILITY
LOCATIONS PRIOR TO DIGGING

CONTRACTOR SHALL INSTALL TRAFFIC SIGNAL
AS PER CITY OF WICHITA SPECIFICATIONS
AND MAY INSTALL VIDEO DETECTION IN LEIU
OF LOOPS.

| LEGEND | |
|--------|------------------------------------|
| VD-3 | VIDEO DETECTION CAMERA NO. |
| 22 | VIDEO DETECTION NUMBER |
| A | SIGN LETTER |
| 4 | SERVICE BOX NUMBER |
| □ | SERVICE BOX |
| ⊗ | CONTROLLER |
| ⊠ | WALK AND DON'T WALK |
| ⊡ | SIGNAL HEAD WITH BACKPLATE |
| ⊢ | SIGNAL HEAD, NO BACKPLATE |
| ⊣ | LUMINAIRE WITH MAST ARM |
| ⊤ | OPTICAL DETECTOR |
| ⊥ | VIDEO CAMERA |
| ⊦ | STREET NAME SIGN |
| ⊧ | MAST ARM WITH POLE |
| ⊨ | SIGNAL HEAD NO. |
| ⊩ | MAST ARM & POLE WITH ABOVE SYMBOLS |
| ⊪ | VIDEO DETECTOR ZONE |

TRAFFIC ENGINEERING CONSULTANTS
 Todd E. Butler, P.E. # 18710
 C.A. # E-1150, RENEWAL 12-31-06
 DATE: 3-26-07

| | | |
|--------|-----|----------|
| Design | RWR | 12/13/06 |
| Drawn | GDB | 12/13/06 |

SIGNAL PLAN
54th STREET & MERIDIAN AVE.

Project No. 178PPP (607879) Sheet No. T6

03/23/07 F:\CAD\17-5653\SIG_REV2.dgn