FHWA REGION NO.	STATE	PROJECT NO.	YEAR	SHEET NO.	TOTAL SHEETS
7	KANSAS	54-87 K-6657-01	2002	4	1122

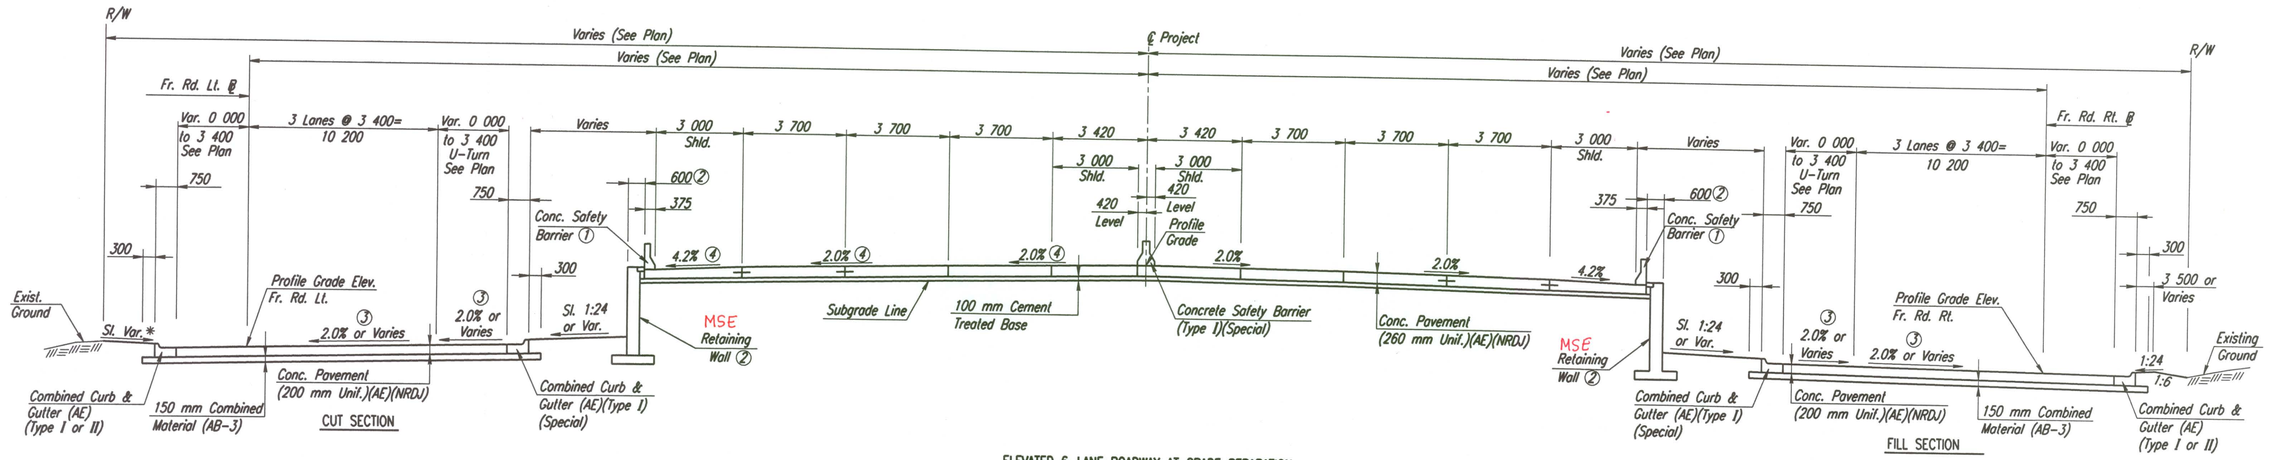

ELEVATED 6-LANE ROADWAY AT GRADE SEPARATION

TANGENT ROADWAY

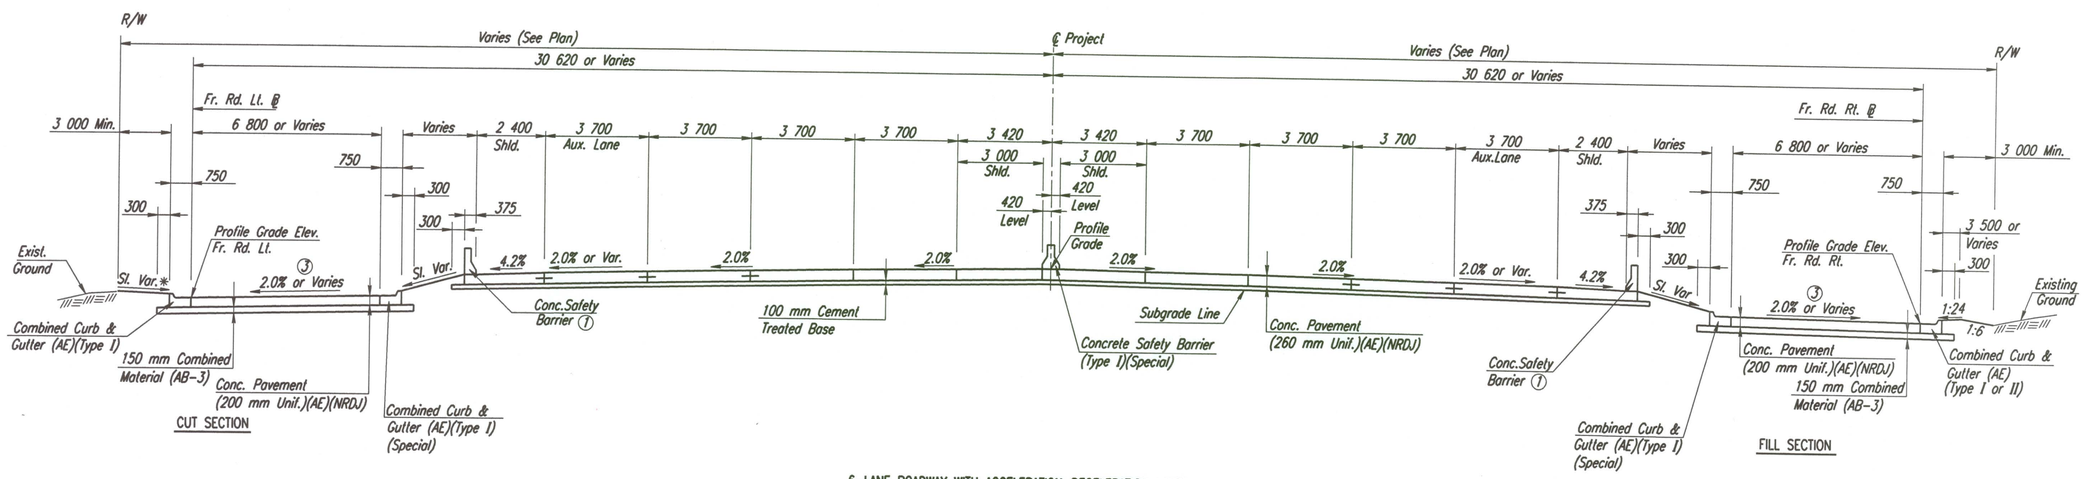

6-LANE ROADWAY WITH ACCELERATION-DECELERATION LANES

TANGENT ROADWAY

* See Cross-Sections

① See Paving Plans for Type of Barrier.

② See Plan Sheets for location of retaining walls.

③ See Paving Plans for Lane Cross-Slope variations.

④ See Kellogg Cross-Slope transition diagrams for Sta. 17+085 to Sta. 17+500.

No.	Revisions	By	Date
1			

CITY OF WICHITA

KELLOGG TYPICAL SECTIONS

SEDGWICK COUNTY

Professional Engineering Consultants, P.A.
303 S. TOPEKA • WICHITA, KANSAS 67202
316-262-2691 • FAX 316-262-3003

Designed by	RCH	Checked by	WDH		
Drawn by	JGP	Date	April, 2002	Job No.	97362

DATE	BY	
	REFERENCES NOTED	
	REFERENCES CHECKED	

DSNR: WDH OPER: JGP SCALE: 1:100 9:32:13 LAST REV: 1-4-2002 BY: svb
I:/1997/97362/TYPSECT/PROPTYP.DGN 9-13-1999