



FHWA REGION NO.	STATE	PROJECT NO.	YEAR	SHEET NO.	TOTAL SHEETS
7	KANSAS	54-87 K6657-01	2002	5	1122

DATE	
BY	
REFERENCES NOTED	
REFERENCES CHECKED	

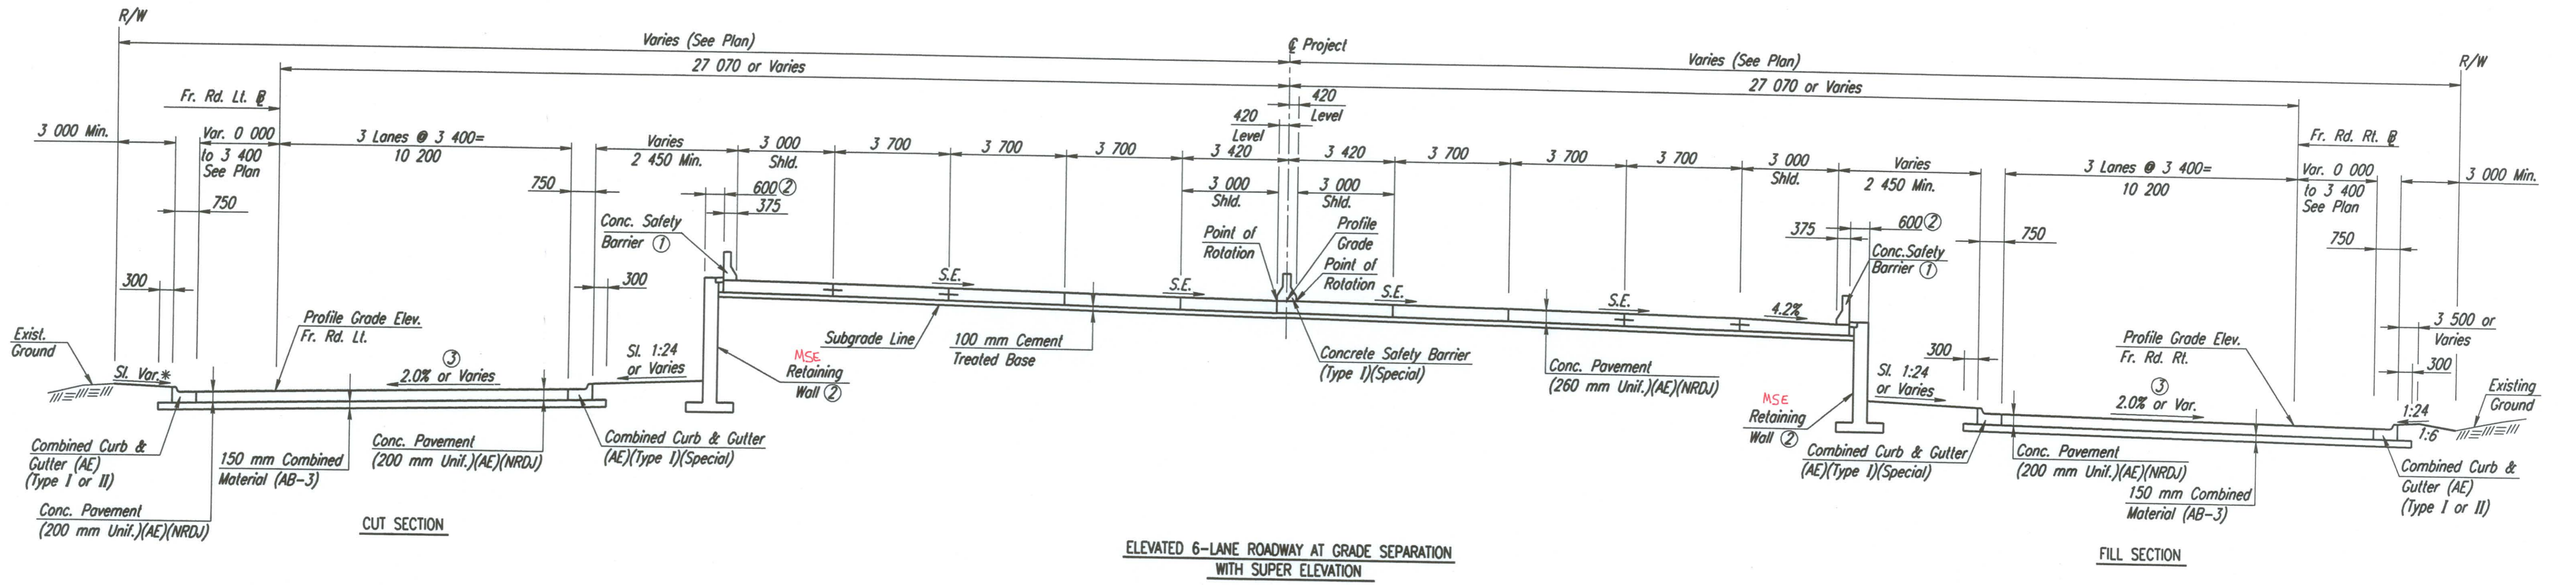

ELEVATED 6-LANE ROADWAY AT GRADE SEPARATION WITH SUPER ELEVATION

FILL SECTION

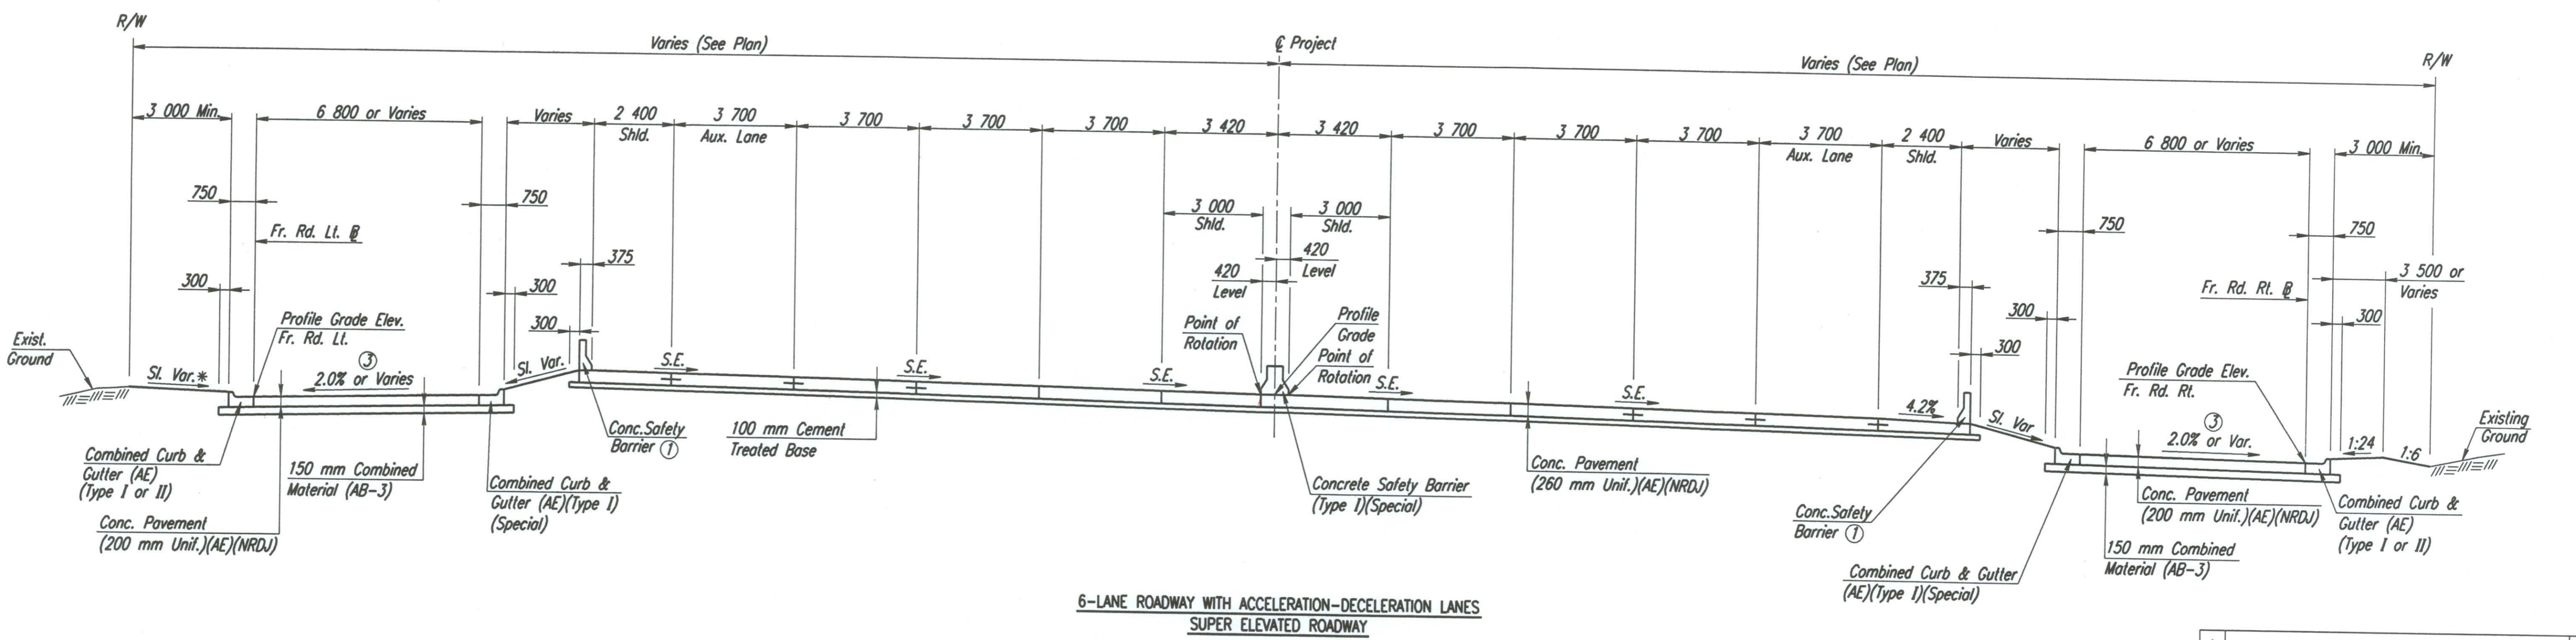

6-LANE ROADWAY WITH ACCELERATION-DECELERATION LANES SUPER ELEVATED ROADWAY

- * See Cross-Sections
- ① See Paving Plans for Type of Barrier.
- ② See Plan Sheets for location of retaining walls.
- ③ See Paving Plans for Lane Cross-Slope variations.

DSNR: WDH OPER: JGP SCALE: 1:100
 I: 1997/97362/TYPSECT/PROPTYP.DGN 9-13-1999 9:32:13 LAST REV: 1-4-2002 BY: svb

No.	Revisions	By	Date

CITY OF WICHITA

KELLOGG TYPICAL SECTIONS

SEDGWICK COUNTY

Professional Engineering Consultants, P.A.
 303 S. TOPEKA • WICHITA, KANSAS 67202
 316-262-2691 • FAX 316-262-3003

Designed by	RCH	Checked by	WDH
Drawn by	JGP	Date	April, 2002
		Job No.	97362