

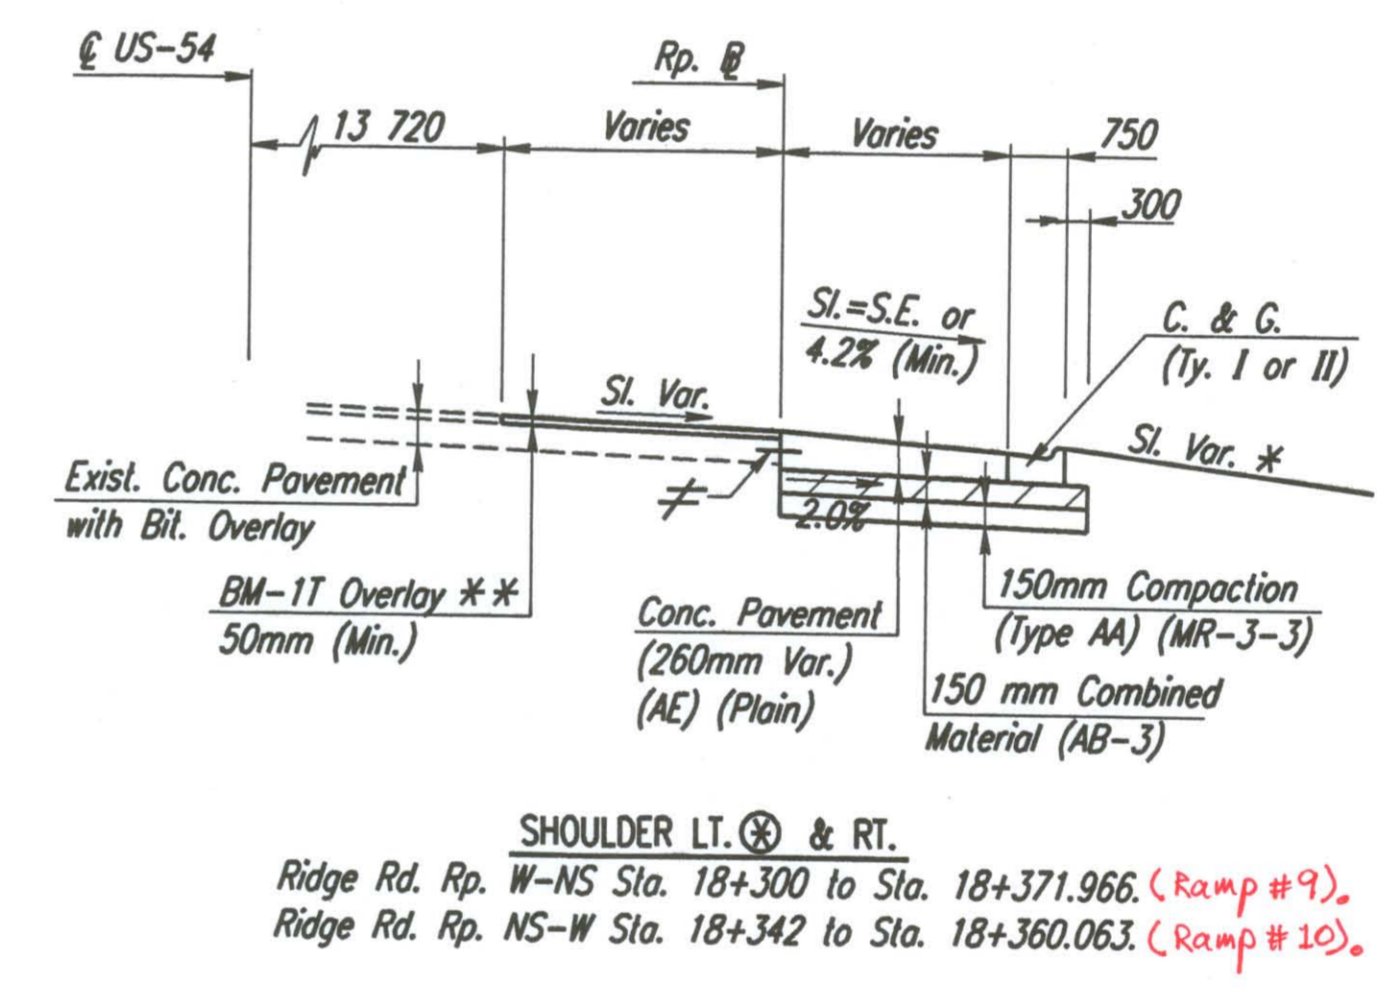


- ⊗ Typical Section mirrored for shoulder Lt.
- * See x-sections for variations.
- ** Thickness varies. Milling required to provide 50mm (Min.) overlay.
- ≠ #16 x 600mm tie bars @ 900mm ctrs. (Typ.) (Subsidiary)
- ① See Paving Plan for top of pavement elevations & cross-slope transition diagrams.
- ② Ramp W-NS varies from 0.6m± @ Sta. 18+255 to 0.0m @ Sta. 18+290±. Ramp NS-W varies from 3.71m± @ Sta. 18+255 to 0.0m @ Sta. 18+360.063.

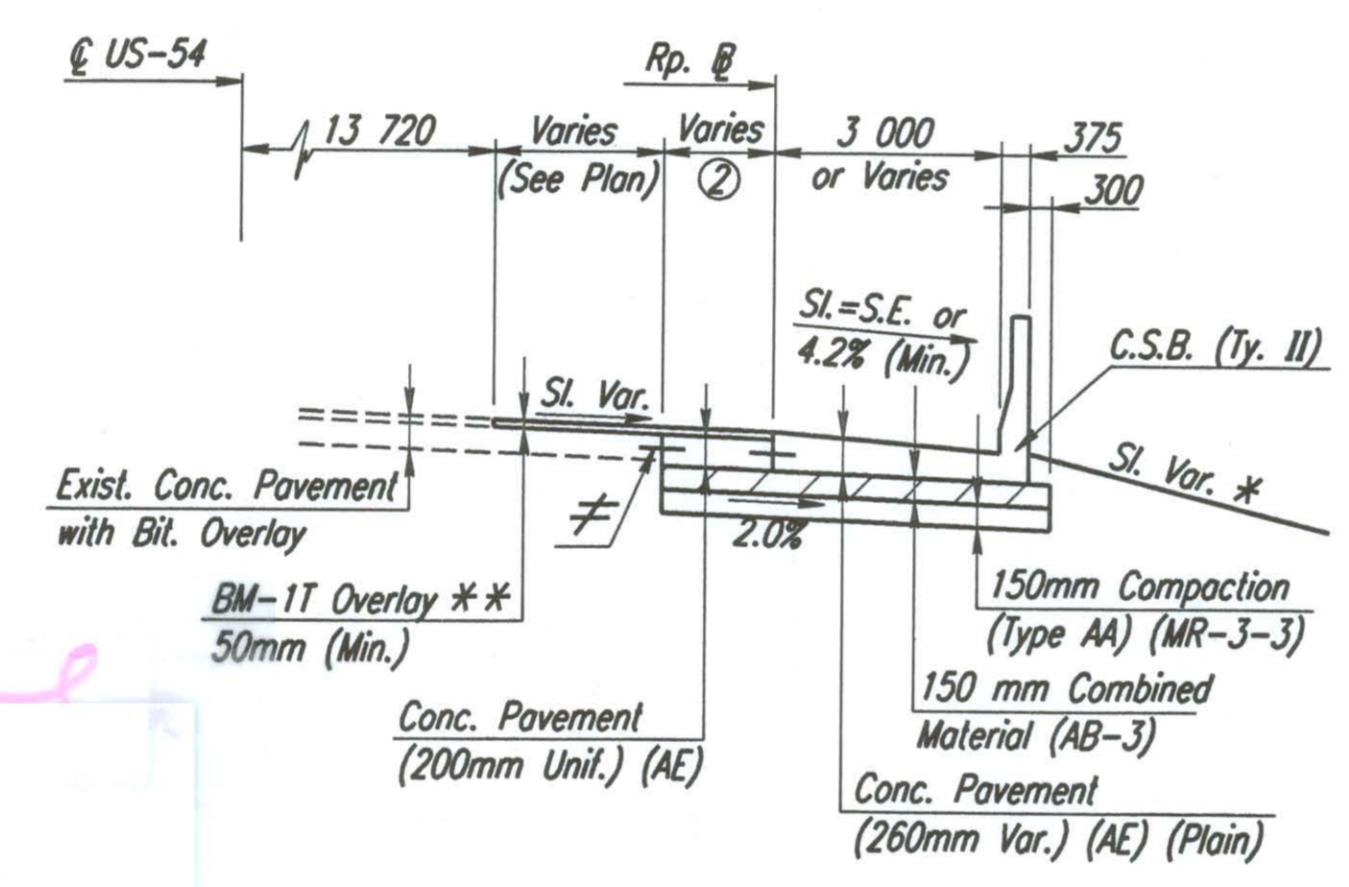

FREEWAY LANE I. D. SYSTEM

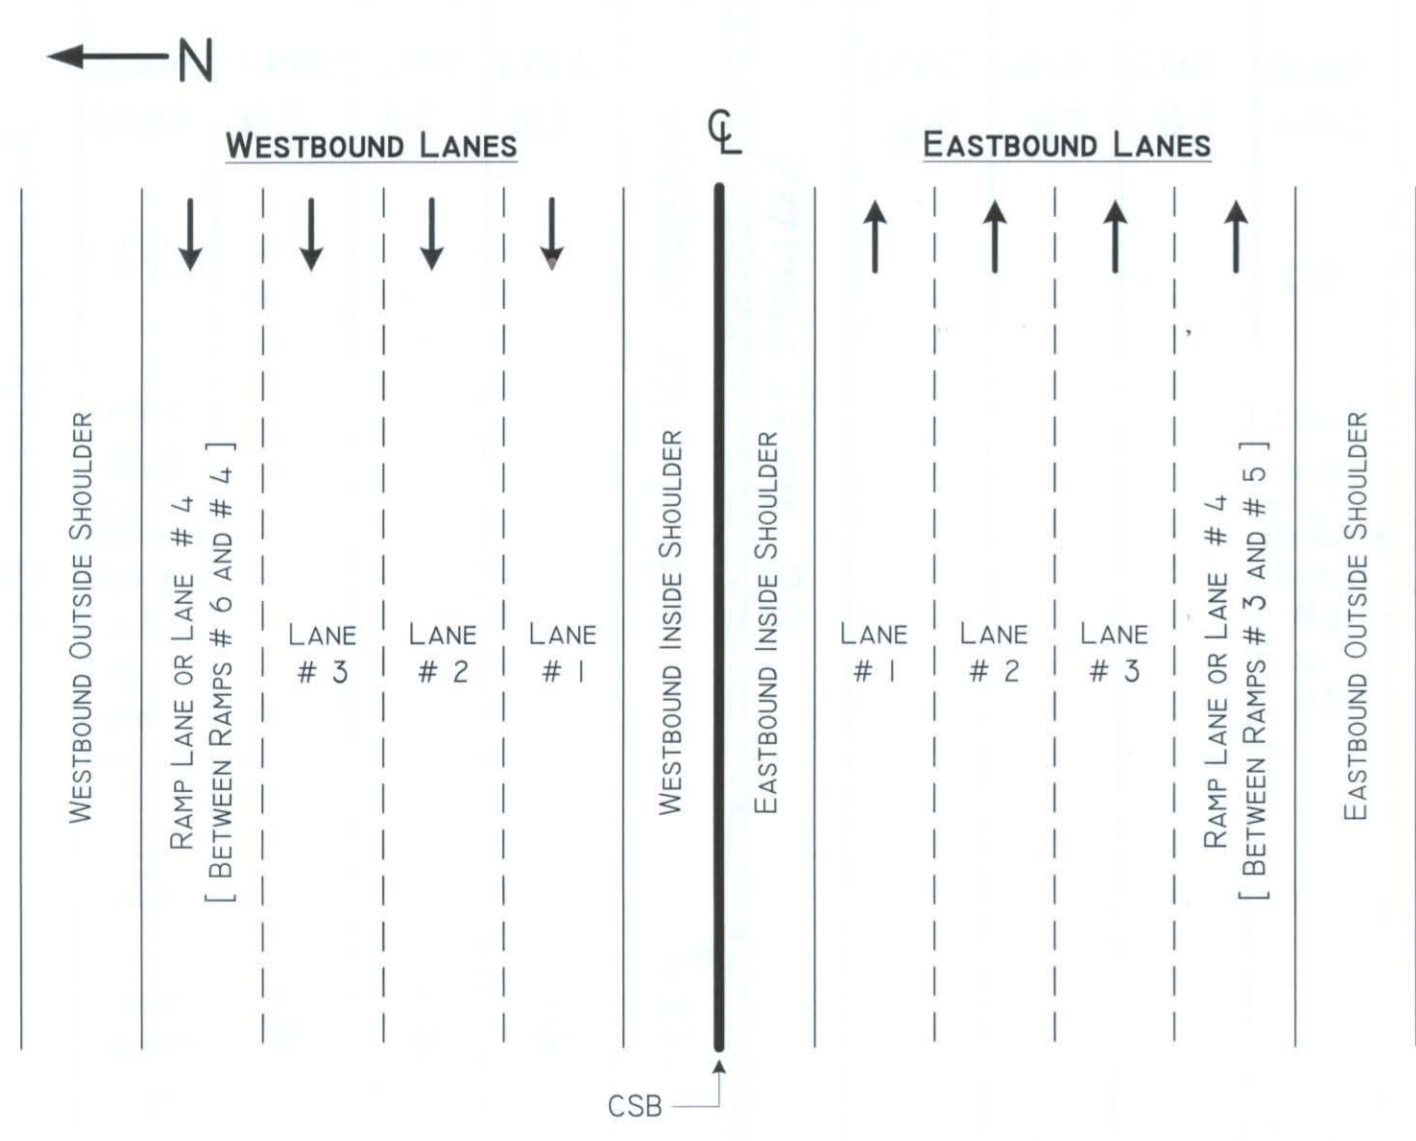

FIELD RAMP #	PLAN RAMP I.D.	RAMP LOCATION - RAMP STA to STA	SIDE	KELLOGG (US - 54 / 400) RAMP DESCRIPTION
1	Ramp W - NS	14 + 935.0 to 15 + 400.6	RT	EB off-ramp to Maize Road
2	Ramp NS - W	15 + 080.0 to 15 + 444.8	LT	WB on-ramp from Maize Road
3	Ramp NS - E	16 + 008.4 to 16 + 300.0	RT	EB on-ramp from Maize Road
4	Ramp E - NS	16 + 072.3 to 16 + 450.0	LT	WB off-ramp to Maize Road
5	Ramp W - NS	16 + 559.9 to 16 + 919.7	RT	EB off-ramp to Tyler Road
6	Ramp NS - W	16 + 747.9 to 17 + 085.8	LT	WB on-ramp from Tyler Road
7	Ramp NS - E	17 + 602.0 to 18 + 927.4	RT	EB on-ramp from Tyler Road
8	Ramp E - NS	17 + 584.1 to 17 + 962.4	LT	WB off-ramp to Tyler Road
9	Ramp W - NS	18 + 225.0 to 18 + 371.9	RT	EB off-ramp to Ridge Road / Airport Road
10	Ramp NS - W	18 + 235.0 to 18 + 360.0	LT	WB on-ramp from Ridge Road / Airport Rd
11	---	19 + 200	RT	EB on-ramp from Ridge Road / Airport Rd
12	---	19 + 225 to 19 + 580	LT	WB off-ramp to Ridge Road / Airport Road

DATE	
BY	
REFERENCES NOTED	
REFERENCES CHECKED	

DSNR: WDH OPER: JGP SCALE: 1:100
 1/1997/97362/TYPSECT/MISCTYP-DGN(2) 10-15-2001 6:46:24 LAST REV: 12-20-01 BY: JGP

No.	Revisions	By	Date
CITY OF WICHITA KELLOGG TYPICAL SECTIONS PAVEMENT WIDENING SEDGWICK COUNTY			
Professional Engineering Consultants, P.A. <small>303 S. TOPEKA • WICHITA, KANSAS 67202 316-262-2691 • FAX 316-262-3003</small>			
Designed by	WDH	Checked by	WDH
Drawn by	JGP	Date	Apr 11, 2002 Job No. 97362