FHWA REGION NO.	STATE	PROJECT NO.	YEAR	SHEET NO.	TOTAL SHEETS
7	KANSAS	54-87 K-6657-01	2002	61	1122

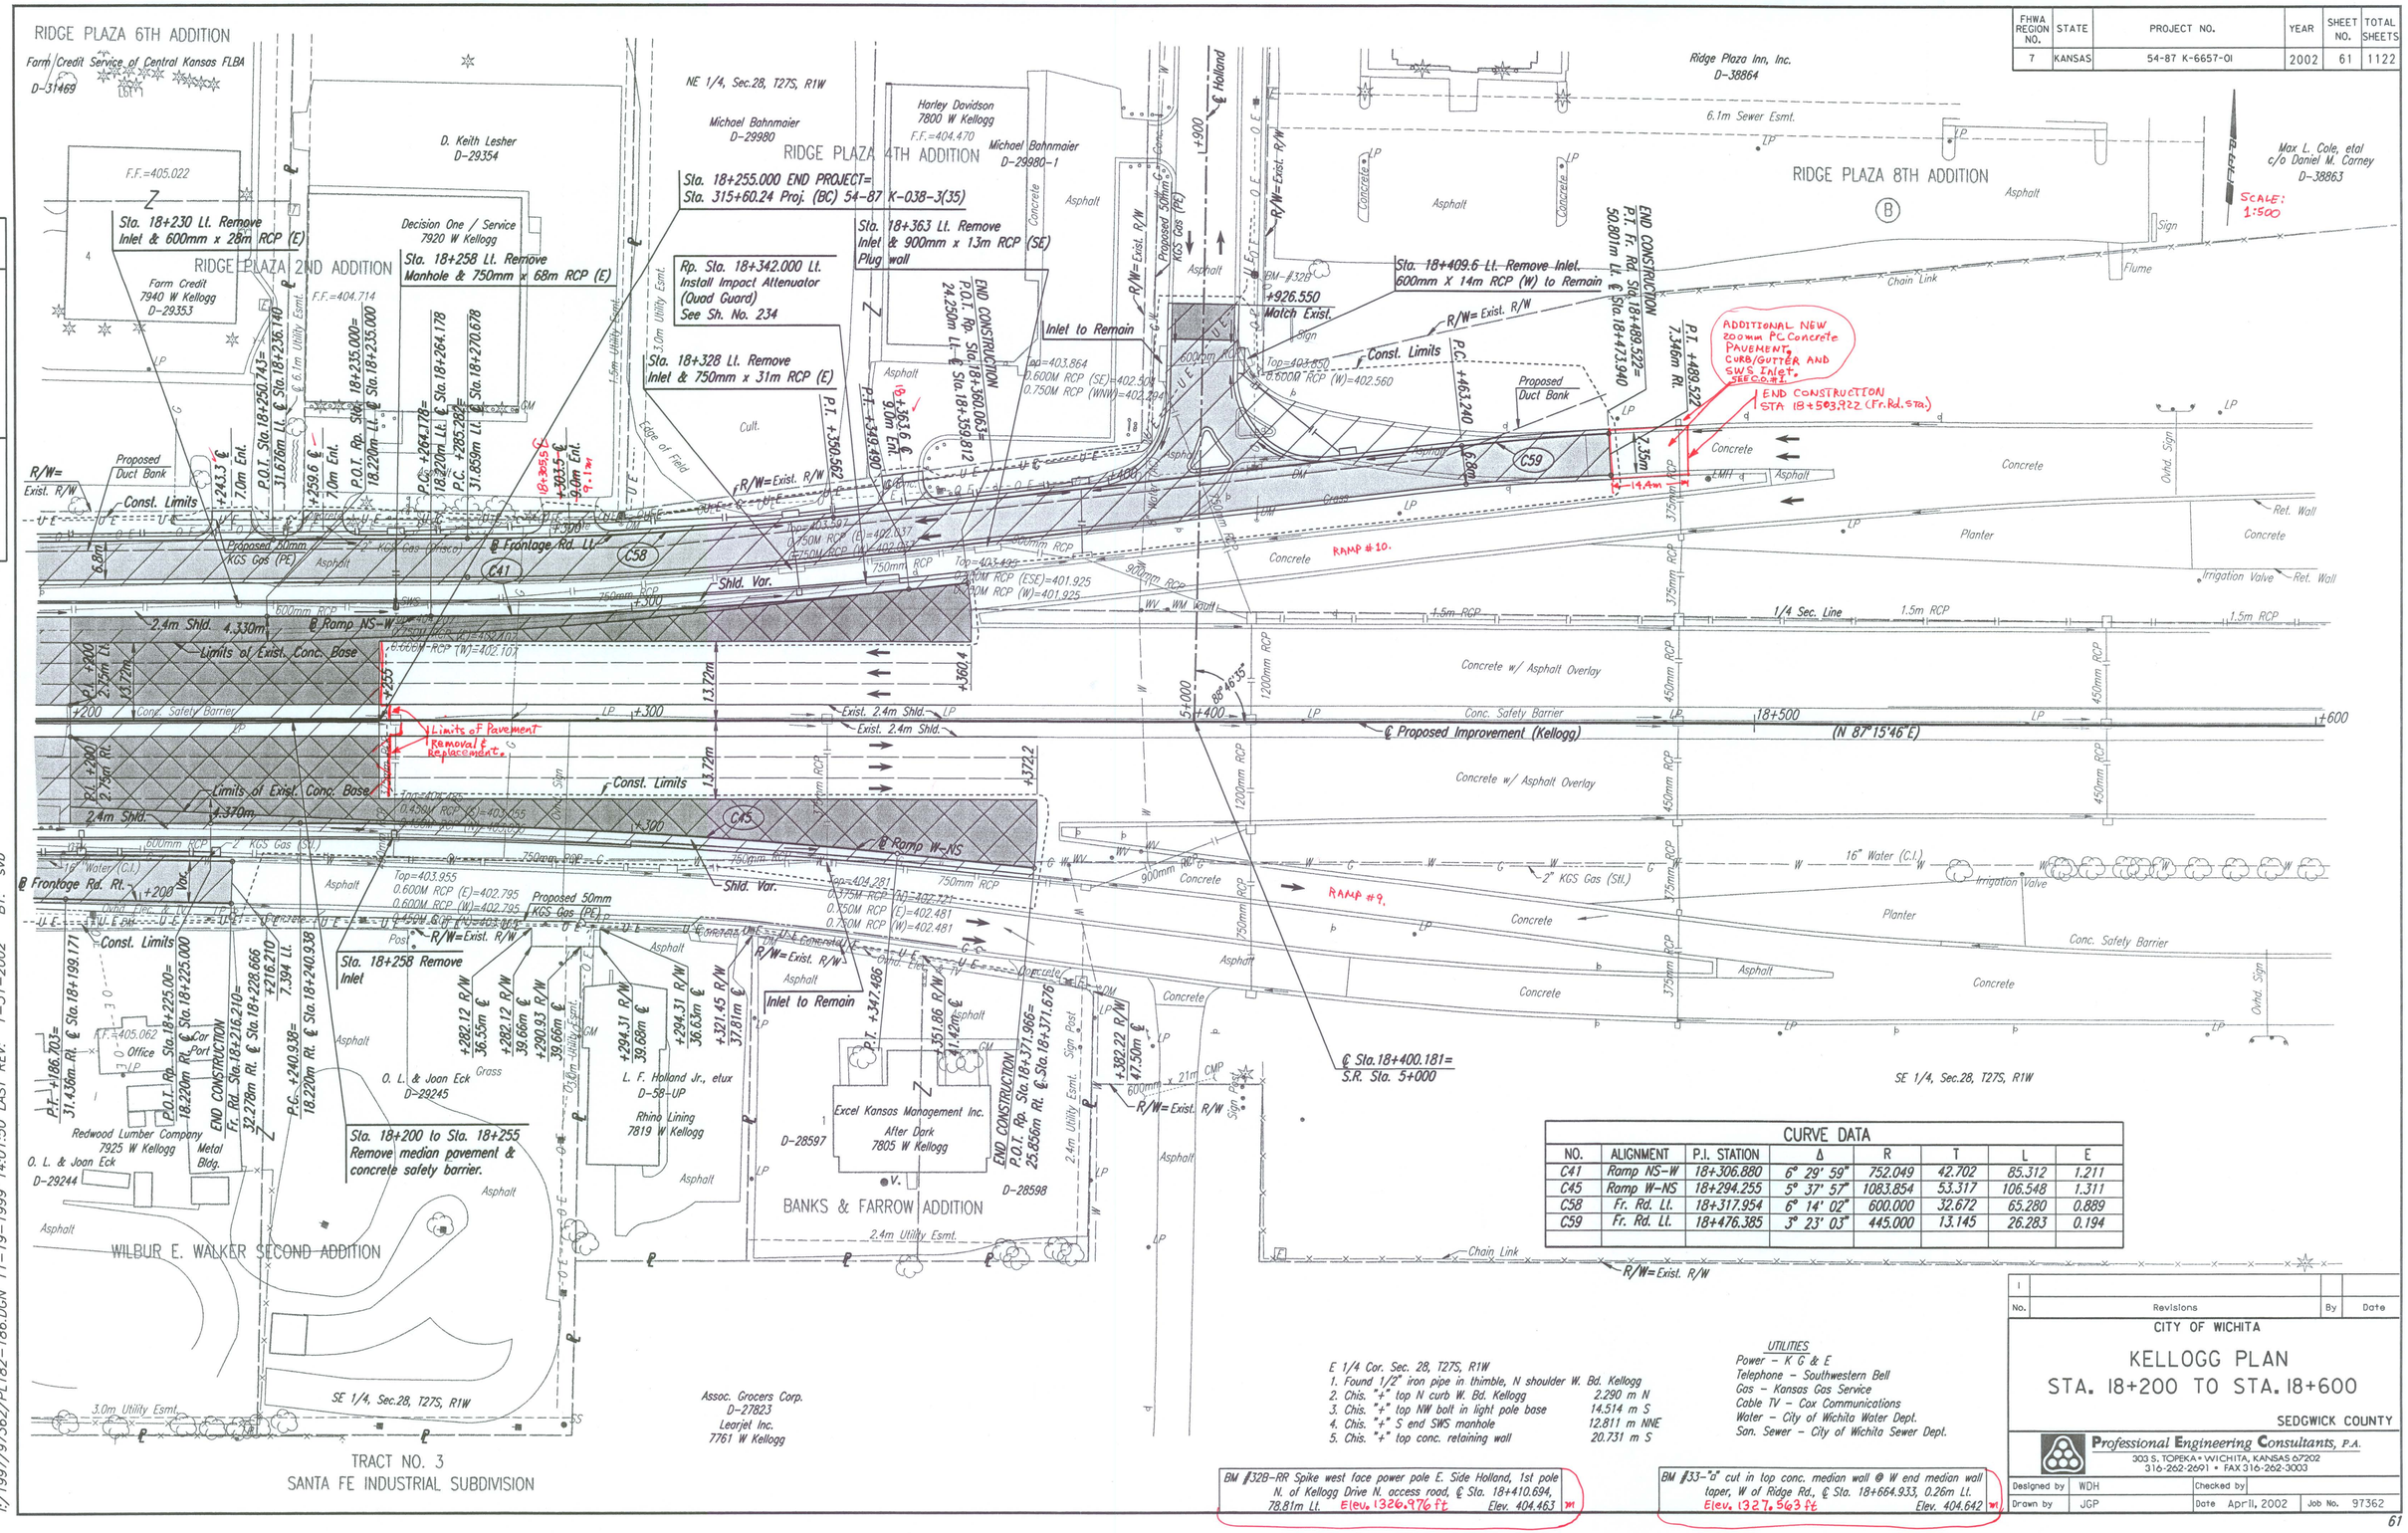

CURVE DATA							
NO.	ALIGNMENT	P.I. STATION	Δ	R	T	L	E
C41	Ramp NS-W	18+306.880	6° 29' 59"	752.049	42.702	85.312	1.211
C45	Ramp W-NS	18+294.255	5° 37' 57"	1083.854	53.317	106.548	1.311
C58	Fr. Rd. Lt.	18+317.954	6° 14' 02"	600.000	32.672	65.280	0.889
C59	Fr. Rd. Lt.	18+476.385	3° 23' 03"	445.000	13.145	26.283	0.194

E 1/4 Cor. Sec. 28, T27S, R1W
1. Found 1/2" iron pipe in thimble, N shoulder W. Bd. Kellogg
2. Chis. "+" top N curb W. Bd. Kellogg 2.290 m N
3. Chis. "+" top NW bolt in light pole base 14.514 m S
4. Chis. "+" S end SWS manhole 12.811 m NNE
5. Chis. "+" top conc. retaining wall 20.731 m S

UTILITIES
Power – K G & E
Telephone – Southwestern Bell
Gas – Kansas Gas Service
Cable TV – Cox Communications
Water – City of Wichita Water Dept.
San. Sewer – City of Wichita Sewer Dept.

BM #32B–RR Spike west face power pole E. Side Holland, 1st pole N. of Kellogg Drive N. access road, ℄ Sta. 18+410.694, 78.81m Lt. Elev. 1326.976 ft Elev. 404.463

BM #33–"a" cut in top conc. median wall @ W end median wall taper, W of Ridge Rd., ℄ Sta. 18+664.933, 0.26m Lt. Elev. 1327.563 ft Elev. 404.642

No.	Revisions	By	Date
1			

CITY OF WICHITA

KELLOGG PLAN
STA. 18+200 TO STA. 18+600

SEDGWICK COUNTY

Professional Engineering Consultants, P.A.
303 S. TOPEKA • WICHITA, KANSAS 67202
316-262-2691 • FAX 316-262-3003

Designed by WDH | Checked by
Drawn by JGP | Date April, 2002 | Job No. 97362

DATE	BY	
		REFERENCES NOTED
		REFERENCES CHECKED

DSNR: WDH OPER: JGP SCALE: 1:500 BY: svb
I:/1997/97362/PL182-186.DGN 11-19-1999 14:01:50 LAST REV: 1-31-2002