

**CONCRETE PAVEMENT JOINT TYPES:**  
 A) CONTRACTION JOINT with #16 x 600mm DEFORMED TIE BARS & SAWN.  
 B) CONSTRUCTION JOINT with #16 x 600mm DEFORMED TIE BARS.  
 C) CONSTRUCTION JOINT: KEYWAY ONLY.  
 D) CONSTRUCTION JOINT with KEYWAY & #16 x 600mm DEFORMED TIE BARS.

**CONCRETE PAVEMENT JOINT TYPES:**  
 E) CONTRACTION JOINT with SMOOTH DOWEL BARS:  
 1) 200mm PCCP = 25mm x 450mm.  
 2) 260mm PCCP = 32mm x 450mm.  
 F) CONSTRUCTION JOINT: NON-TIED.  
 G) CONSTRUCTION JOINT along curb & gutter with #16 x 900mm EPOXY COATED DEFORMED TIE BARS.


**CONCRETE PAVEMENT JOINT TYPES:**  
 H) CONSTRUCTION JOINT with SMOOTH DOWEL BARS:  
 1) 200mm PCCP = 25mm x 450mm.  
 2) 260mm PCCP = 32mm x 450mm.  
 I) CONTRACTION JOINT (mainline outside shoulder only) with 2-#16 continuous epoxy deformed bars left uncut & SAWN.

**CONCRETE PAVEMENT JOINT TYPES:**  
 J) CONSTRUCTION JOINT (outside shoulder) with 2-#16 continuous epoxy deformed bars.  
 K) CONTRACTION JOINT (inside or outside shoulder) NON-TIED & SAWN.  
 L) EXPANSION JOINT (19mm).  
 M) CONSTRUCTION JOINT along curb/gutter with KEYWAY & #16 x 900mm TIE BARS.

NOTE: TIE BARS WERE OMITTED ACROSS ALL SIDE ROADS ALONG FRONTAGE ROAD PAVEMENT.

SCALE: 1:250

DATE	
BY	
REFERENCES NOTED	
REFERENCES CHECKED	

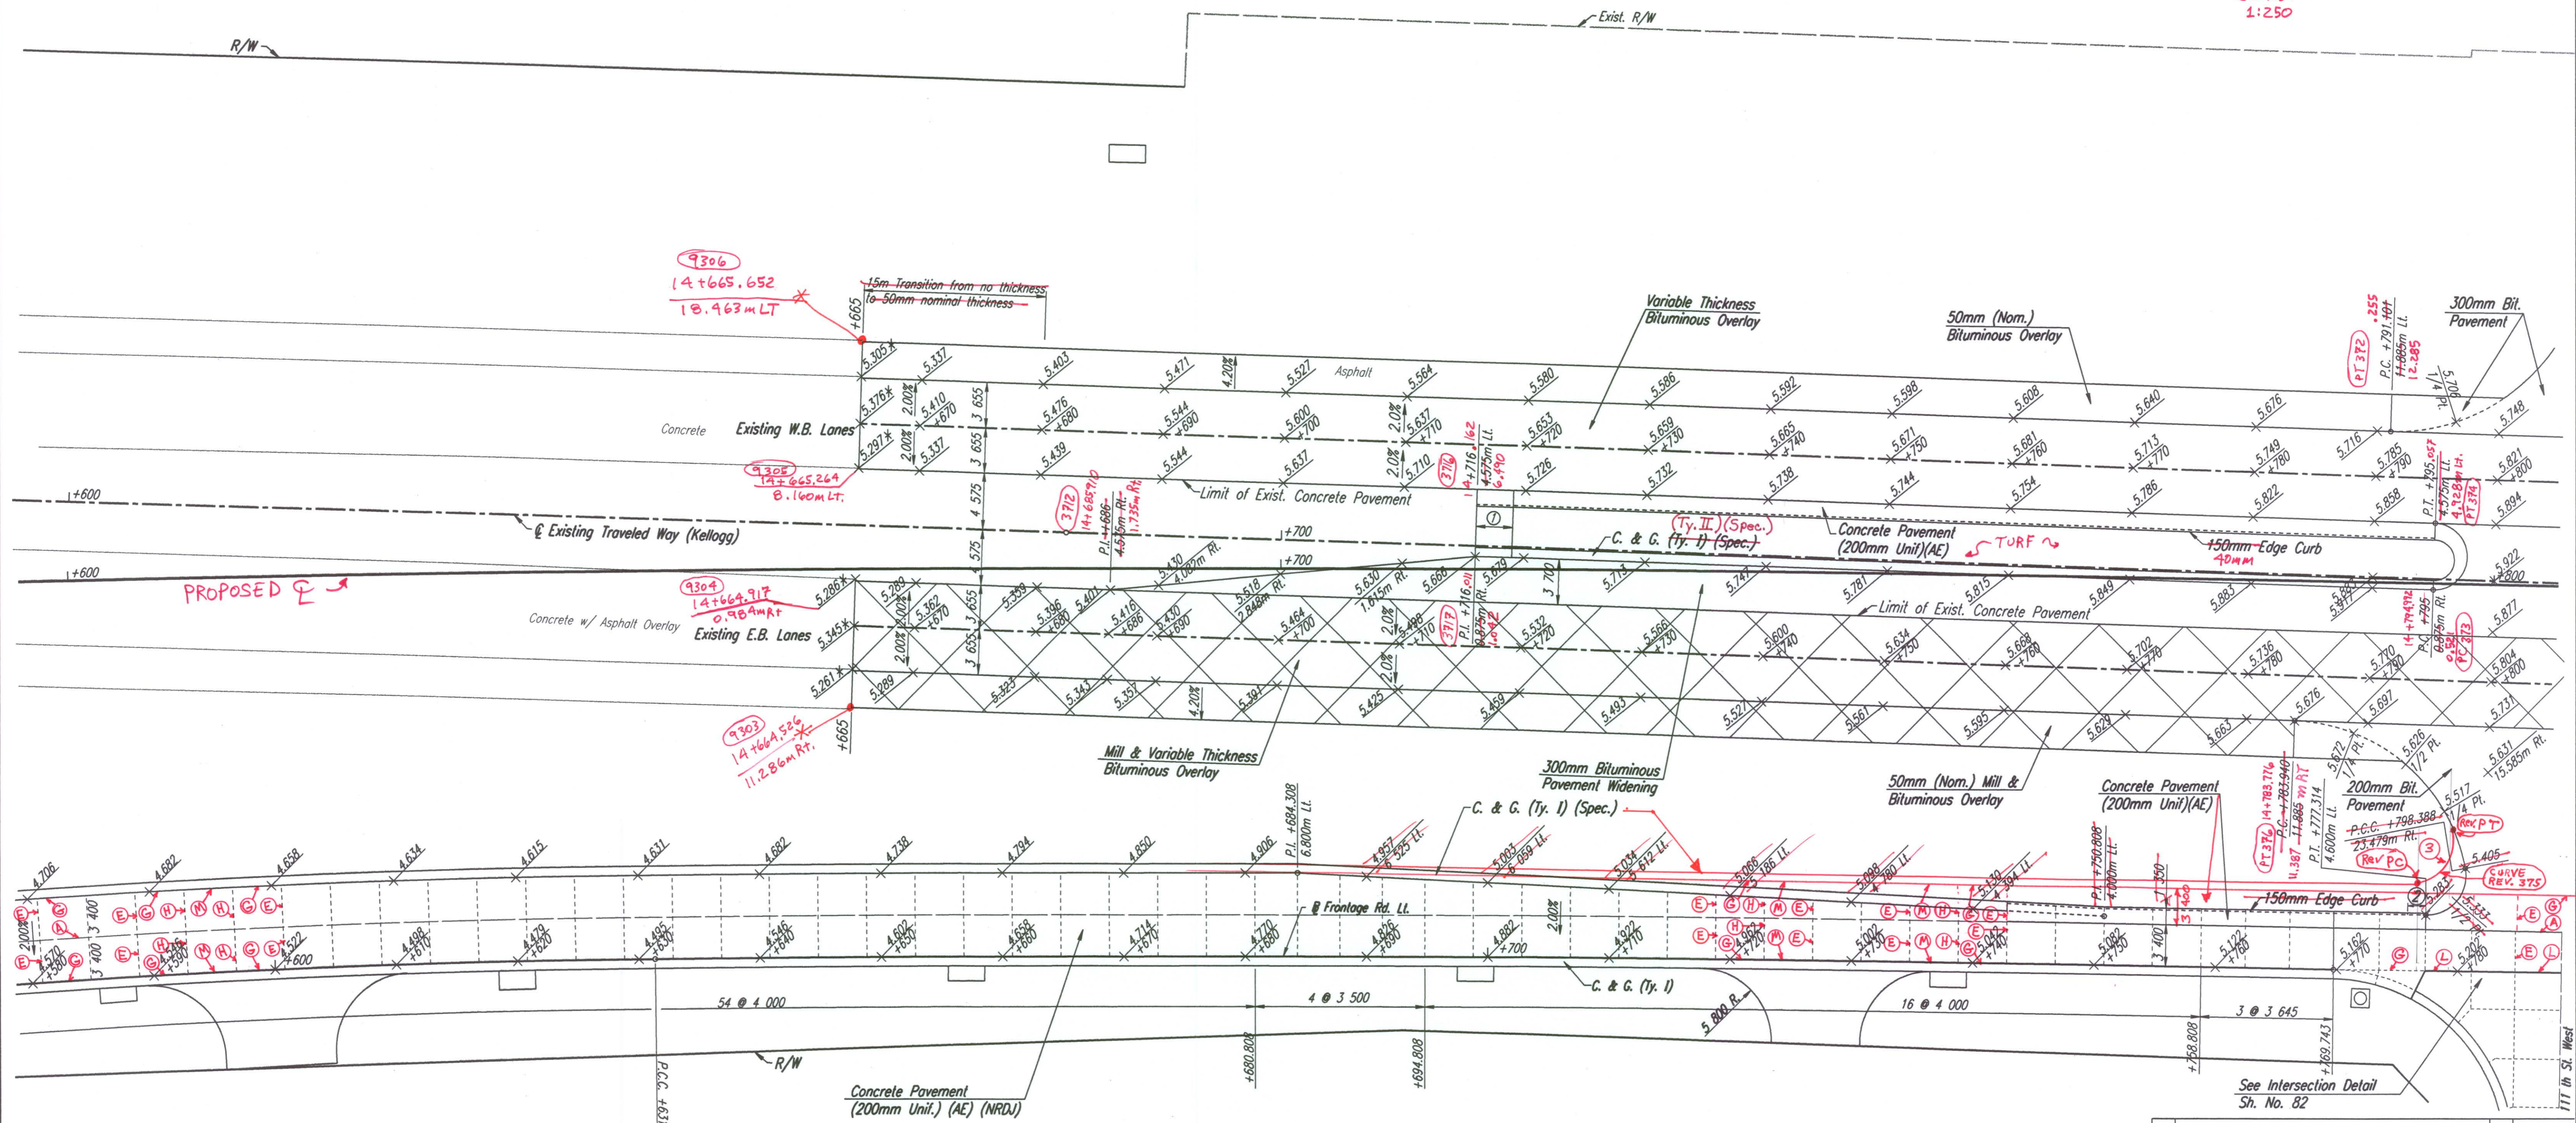

③ REVISIONS TO EB KELLOGG DRIVE (Fr. Rd. RT.):  
 REV. PC = Sta. 14 + 776.660 - 7.4m LT,  
 Sta. 14 + 779.374 - 11.616m LT, Fr. Rd. RT.  
 REV. PT = Sta. 14 + 797.053 - 19.954m RT, & Future Improvements

- \* Match Existing
- ① 3m transition from no height curb to full height curb. Type II Special Curb.
- ② 1.5m transition from full height curb to no curb.

Note: Prior to median construction, Contractor shall verify elevations in order to ensure positive drainage to the outside.

CITY OF WICHITA			
PAVING PLAN			
STA. 14+600 TO STA. 14+800			
SEDGWICK COUNTY			
Professional Engineering Consultants, P.A.			
303 S. TOPEKA • WICHITA, KANSAS 67202			
316-262-2691 • FAX 316-262-3003			
Designed by	WDH	Checked by	WDH
Drawn by	JGP	Date	Apr 11, 2002
		Job No.	97362

DSNR: WDH OPER: JGP SCALE: 1:250  
 i:/1997/97362/PAVING/PAV146.DGN 2-21-2001 6:50:18 LAST REV: 12-31-01 BY: JGP