


BY	DATE
REFERENCES NOTED	REFERENCES CHECKED

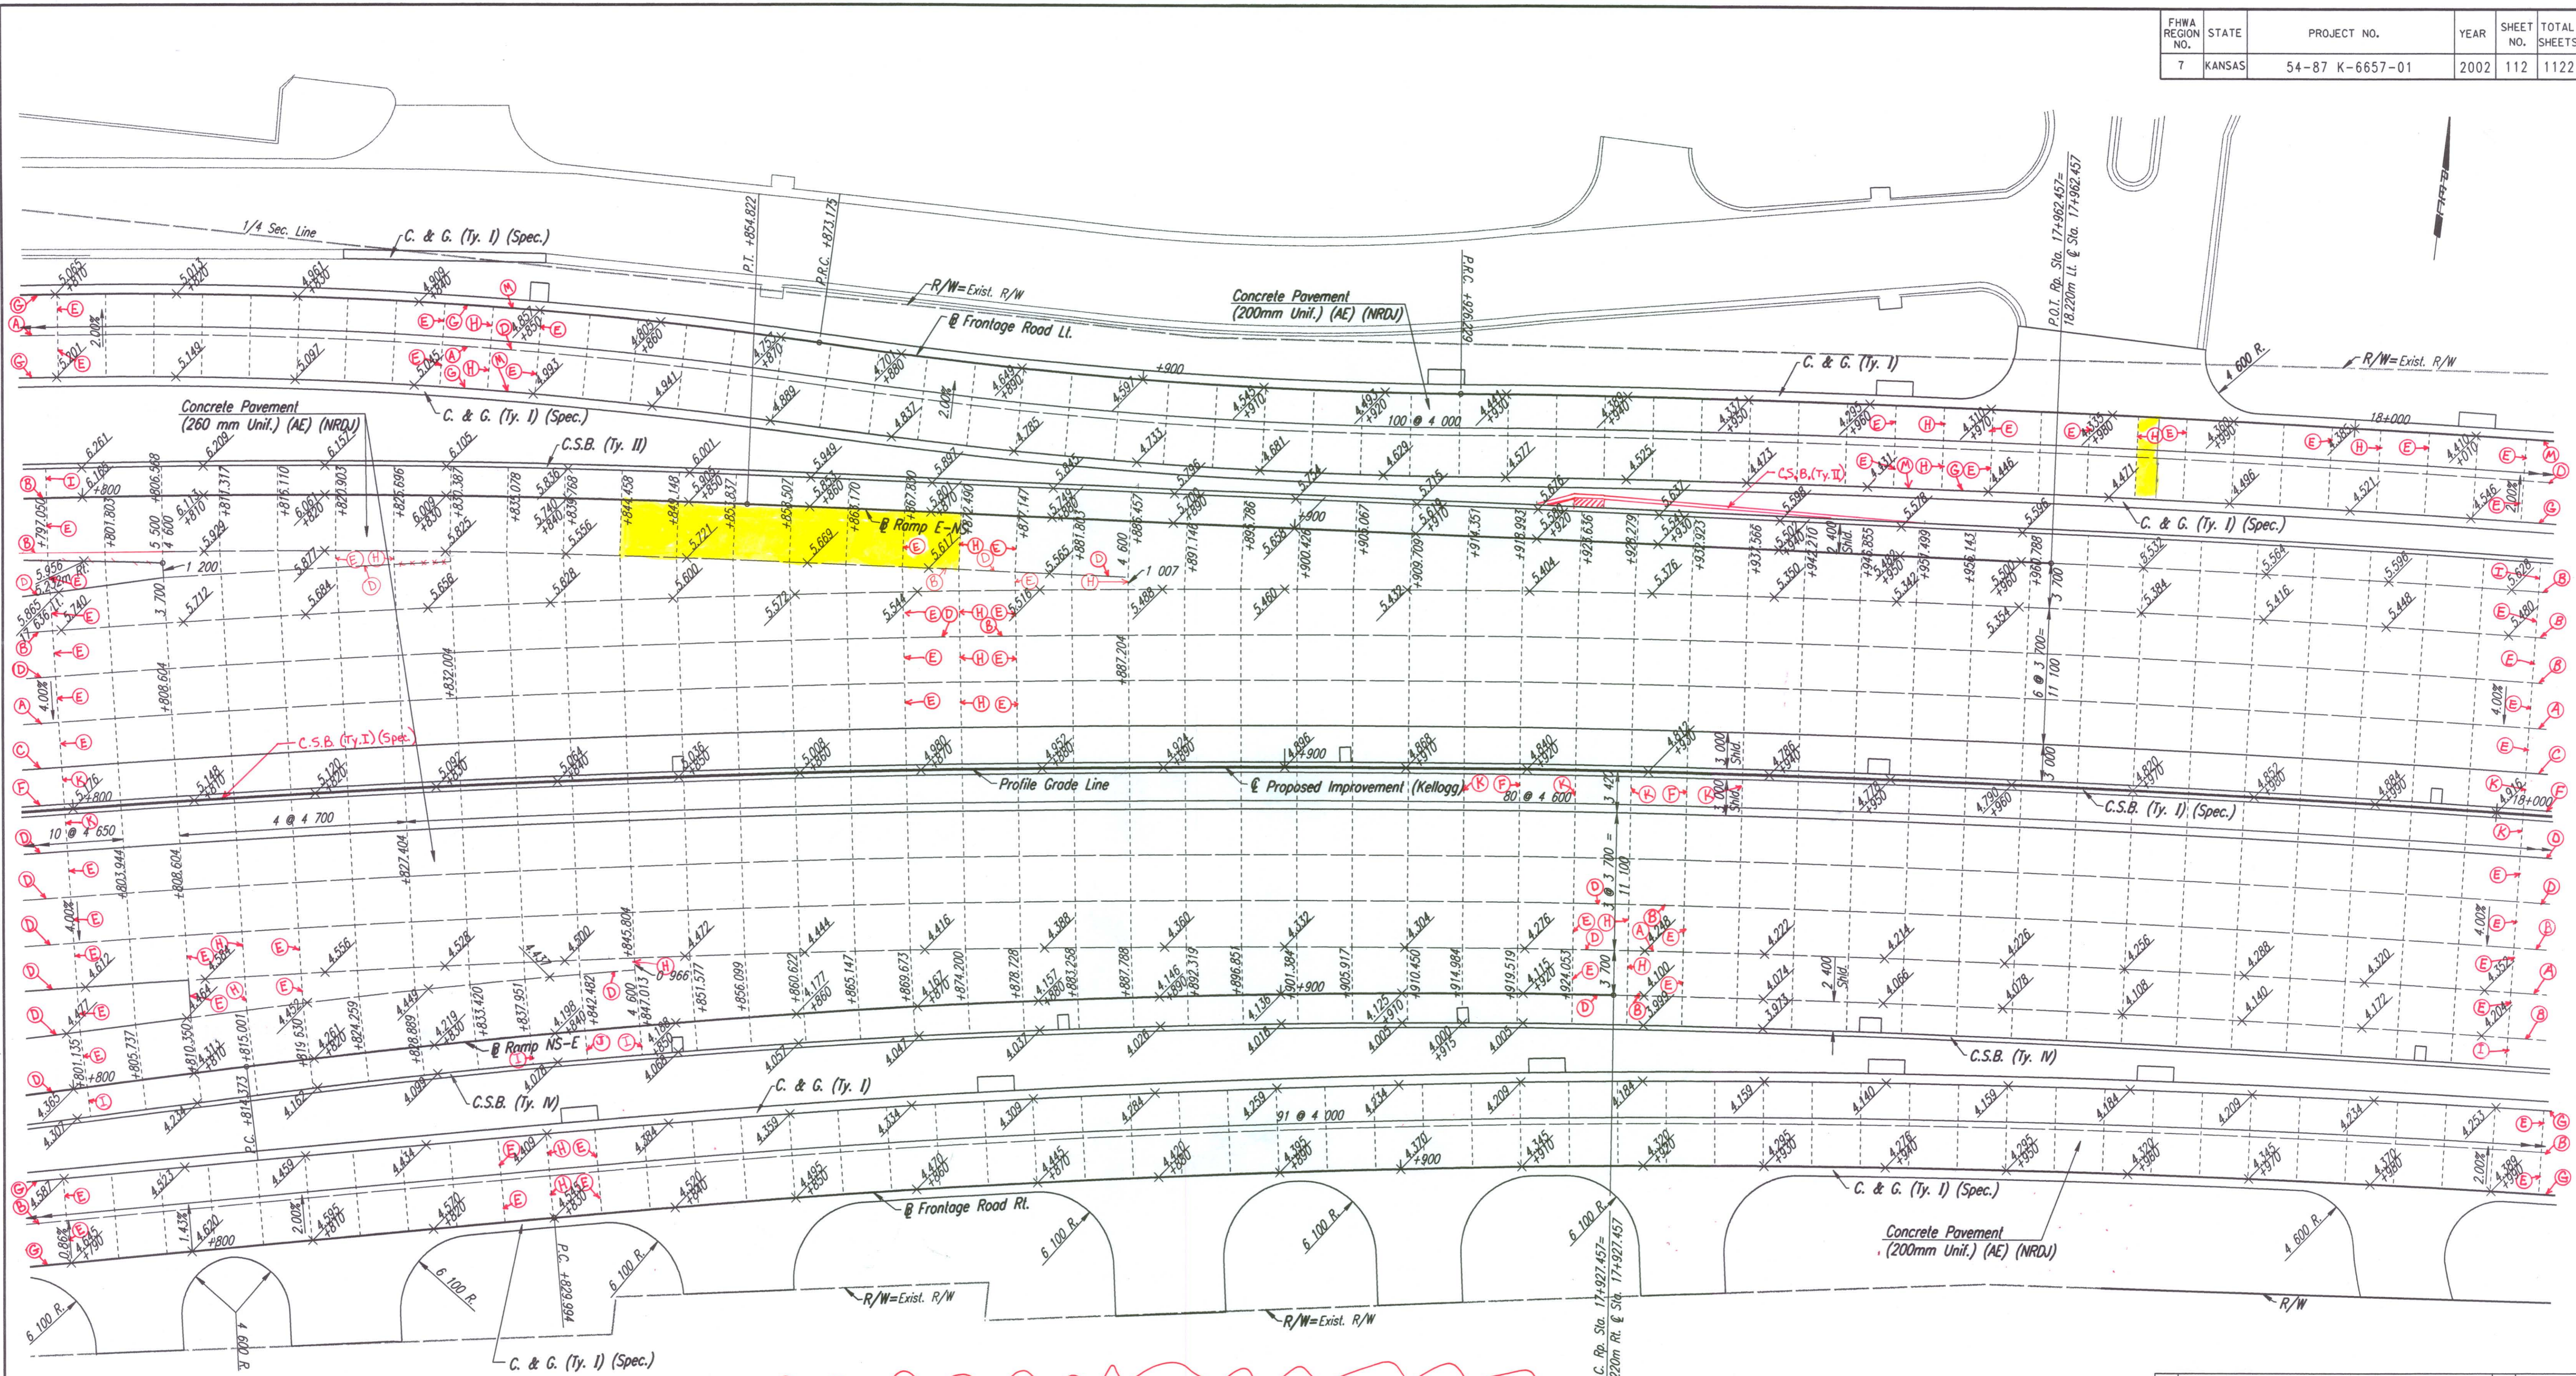

DSNR: WDH OPER: JGP SCALE: 1:250
 I:1997/97362/PAVING/PAV178.DGN 2-21-2001 13:06:01 LAST REV: 11-27-01 BY: JGP

- | | | | |
|--|---|---|--|
| <p>CONCRETE PAVEMENT JOINT TYPES:</p> <p>A) CONTRACTION JOINT with #16 x 600mm DEFORMED TIE BARS & SAWN.</p> <p>B) CONTRACTION JOINT with #16 x 600mm DEFORMED TIE BARS.</p> <p>C) CONTRACTION JOINT: KEYWAY ONLY.</p> <p>D) CONTRACTION JOINT with KEYWAY & #16 x 600mm DEFORMED TIE BARS.</p> | <p>CONCRETE PAVEMENT JOINT TYPES:</p> <p>E) CONTRACTION JOINT with SMOOTH DOWEL BARS:</p> <ol style="list-style-type: none"> 1) 200mm PCCP = 25mm x 450mm. 2) 260mm PCCP = 32mm x 450mm. <p>F) CONTRACTION JOINT: NON-TIED.</p> <p>G) CONTRACTION JOINT along curb & gutter with #16 x 900mm EPOXY COATED DEFORMED TIE BARS.</p> | <p>CONCRETE PAVEMENT JOINT TYPES:</p> <p>H) CONTRACTION JOINT with SMOOTH DOWEL BARS:</p> <ol style="list-style-type: none"> 1) 200mm PCCP = 25mm x 450mm. 2) 260mm PCCP = 32mm x 450mm. <p>I) CONTRACTION JOINT (mainline outside shoulder only) with 2-#16 continuous epoxy deformed bars left uncut & SAWN.</p> | <p>CONCRETE PAVEMENT JOINT TYPES:</p> <p>J) CONTRACTION JOINT (outside shoulder) with 2-#16 continuous epoxy deformed bars.</p> <p>K) CONTRACTION JOINT (inside or outside shoulder) NON-TIED & SAWN.</p> <p>L) EXPANSION JOINT (19mm).</p> <p>M) CONTRACTION JOINT along curb/gutter with KEYWAY & #16 x 900mm TIE BARS.</p> |
|--|---|---|--|

Removed + Replaced

NOTE: THE BARS WERE OMITTED ACROSS ALL SIDE ROADS ALONG FRONTAGE ROAD PAVEMENT.

No.	Revisions	By	Date

CITY OF WICHITA

PAVING PLAN

STA. 17+800 TO STA. 18+000

SEDGWICK COUNTY

Professional Engineering Consultants, P.A.

303 S. TOPEKA • WICHITA, KANSAS 67202
316-262-2691 • FAX 316-262-3003

Designed by	WDH	Checked by	WDH
Drawn by	JGP	Date	April, 2002
		Job No.	97362