


DATE	
BY	
REFERENCES NOTED	
REFERENCES CHECKED	

DSNR: JPS OPER: JGP SCALE: 1:500  
 I:/1997/97362/SWS/SWS182.DGN 11-22-1999 8:21:51 LAST REV: 2-5-2002 BY: svb

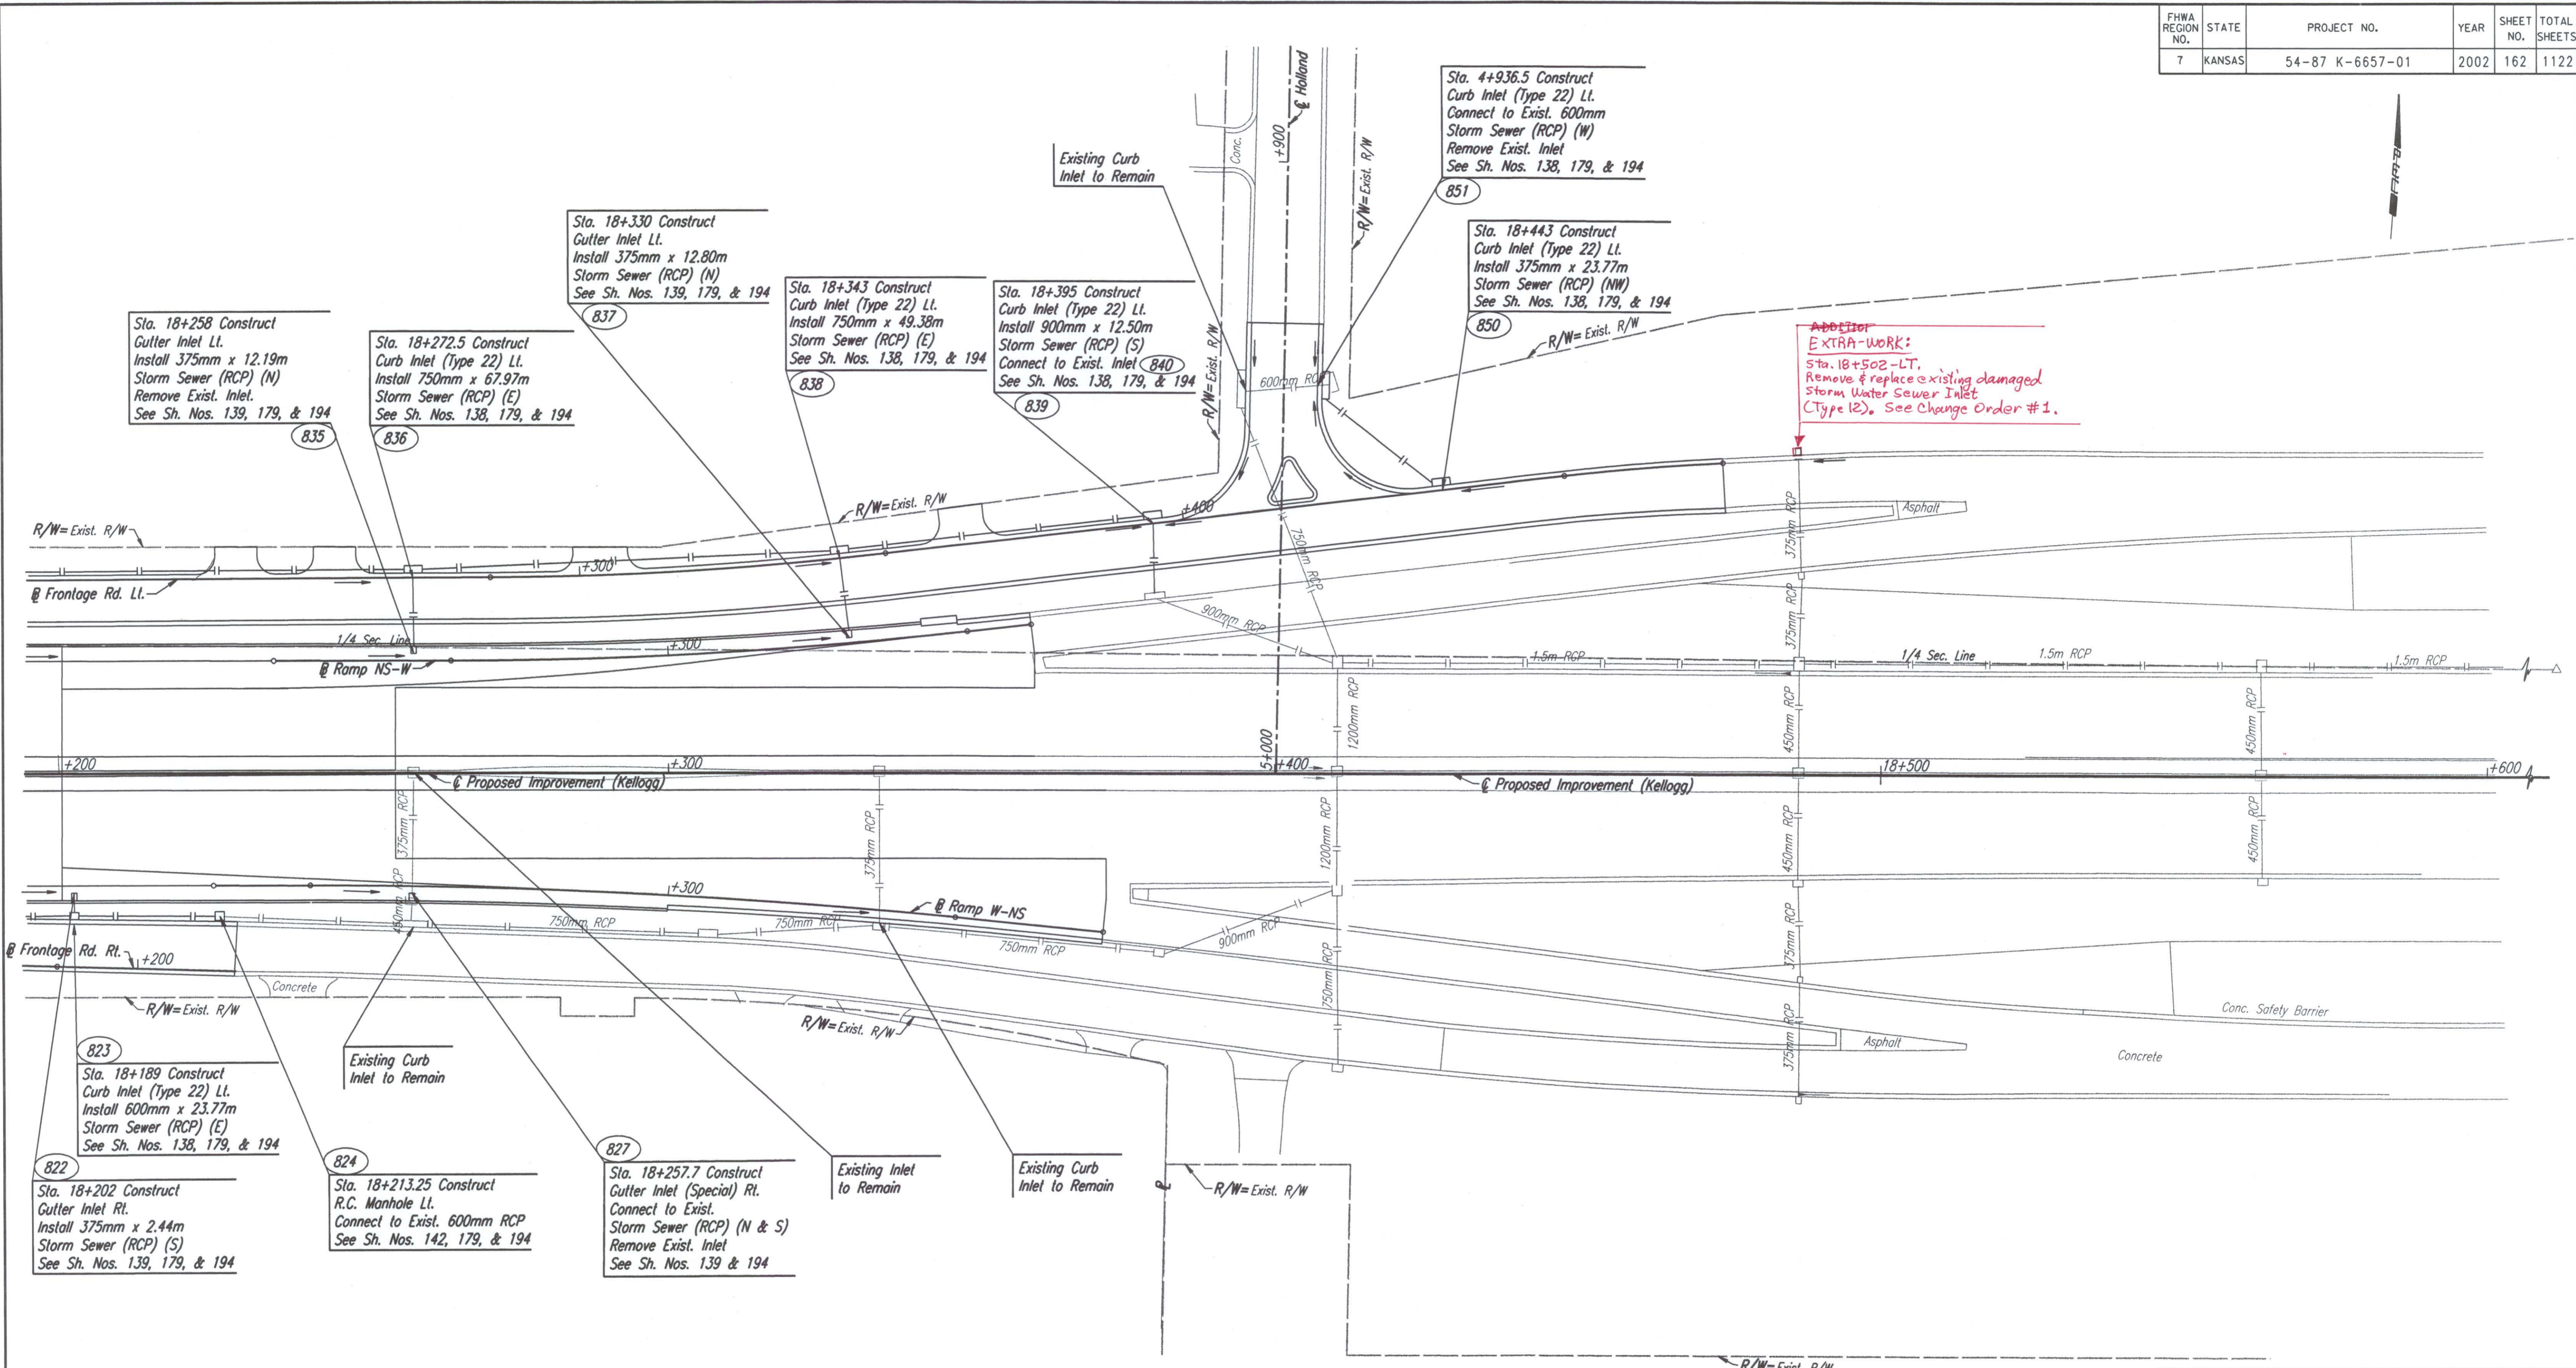

Sta. 18+258 Construct Gutter Inlet Lt. Install 375mm x 12.19m Storm Sewer (RCP) (N) Remove Exist. Inlet. See Sh. Nos. 139, 179, & 194

Sta. 18+272.5 Construct Curb Inlet (Type 22) Lt. Install 750mm x 67.97m Storm Sewer (RCP) (E) See Sh. Nos. 138, 179, & 194

Sta. 18+330 Construct Gutter Inlet Lt. Install 375mm x 12.80m Storm Sewer (RCP) (N) See Sh. Nos. 139, 179, & 194

Sta. 18+343 Construct Curb Inlet (Type 22) Lt. Install 750mm x 49.38m Storm Sewer (RCP) (E) See Sh. Nos. 138, 179, & 194

Sta. 18+395 Construct Curb Inlet (Type 22) Lt. Install 900mm x 12.50m Storm Sewer (RCP) (S) Connect to Exist. Inlet See Sh. Nos. 138, 179, & 194

Sta. 4+936.5 Construct Curb Inlet (Type 22) Lt. Connect to Exist. 600mm Storm Sewer (RCP) (W) Remove Exist. Inlet See Sh. Nos. 138, 179, & 194

Sta. 18+443 Construct Curb Inlet (Type 22) Lt. Install 375mm x 23.77m Storm Sewer (RCP) (NW) See Sh. Nos. 138, 179, & 194

**ADDITIONAL EXTRA-WORK:**  
 Sta. 18+502-LT, Remove & replace existing damaged storm water sewer inlet (Type 12). See Change Order #1.

Sta. 18+189 Construct Curb Inlet (Type 22) Lt. Install 600mm x 23.77m Storm Sewer (RCP) (E) See Sh. Nos. 138, 179, & 194

Sta. 18+202 Construct Gutter Inlet Rt. Install 375mm x 2.44m Storm Sewer (RCP) (S) See Sh. Nos. 139, 179, & 194

Sta. 18+213.25 Construct R.C. Manhole Lt. Connect to Exist. 600mm RCP See Sh. Nos. 142, 179, & 194

Sta. 18+257.7 Construct Gutter Inlet (Special) Rt. Connect to Exist. Storm Sewer (RCP) (N & S) Remove Exist. Inlet See Sh. Nos. 139 & 194

No.	Revisions	By	Date
-----	-----------	----	------

CITY OF WICHITA  
**STORM WATER SEWER**  
**STA. 18+200 TO STA. 18+600**  
 SEDGWICK COUNTY

**Professional Engineering Consultants, P.A.**  
303 S. TOPEKA • WICHITA, KANSAS 67202  
 316-262-2691 • FAX 316-262-3003

Designed by	RCH	Checked by	WDH
Drawn by	JGP	Date	April, 2002
		Job No.	97362