FHWA REGION NO.	STATE	PROJECT NO.	YEAR	SHEET NO.	TOTAL SHEETS
7	KANSAS	54-87 K-6657-01	2002	210	1122

SCALE:
PLAN: LAT. & LONG. 0 10 20 1:500
PROFILE: HORIZ. SAME AS ABOVE
VERT.

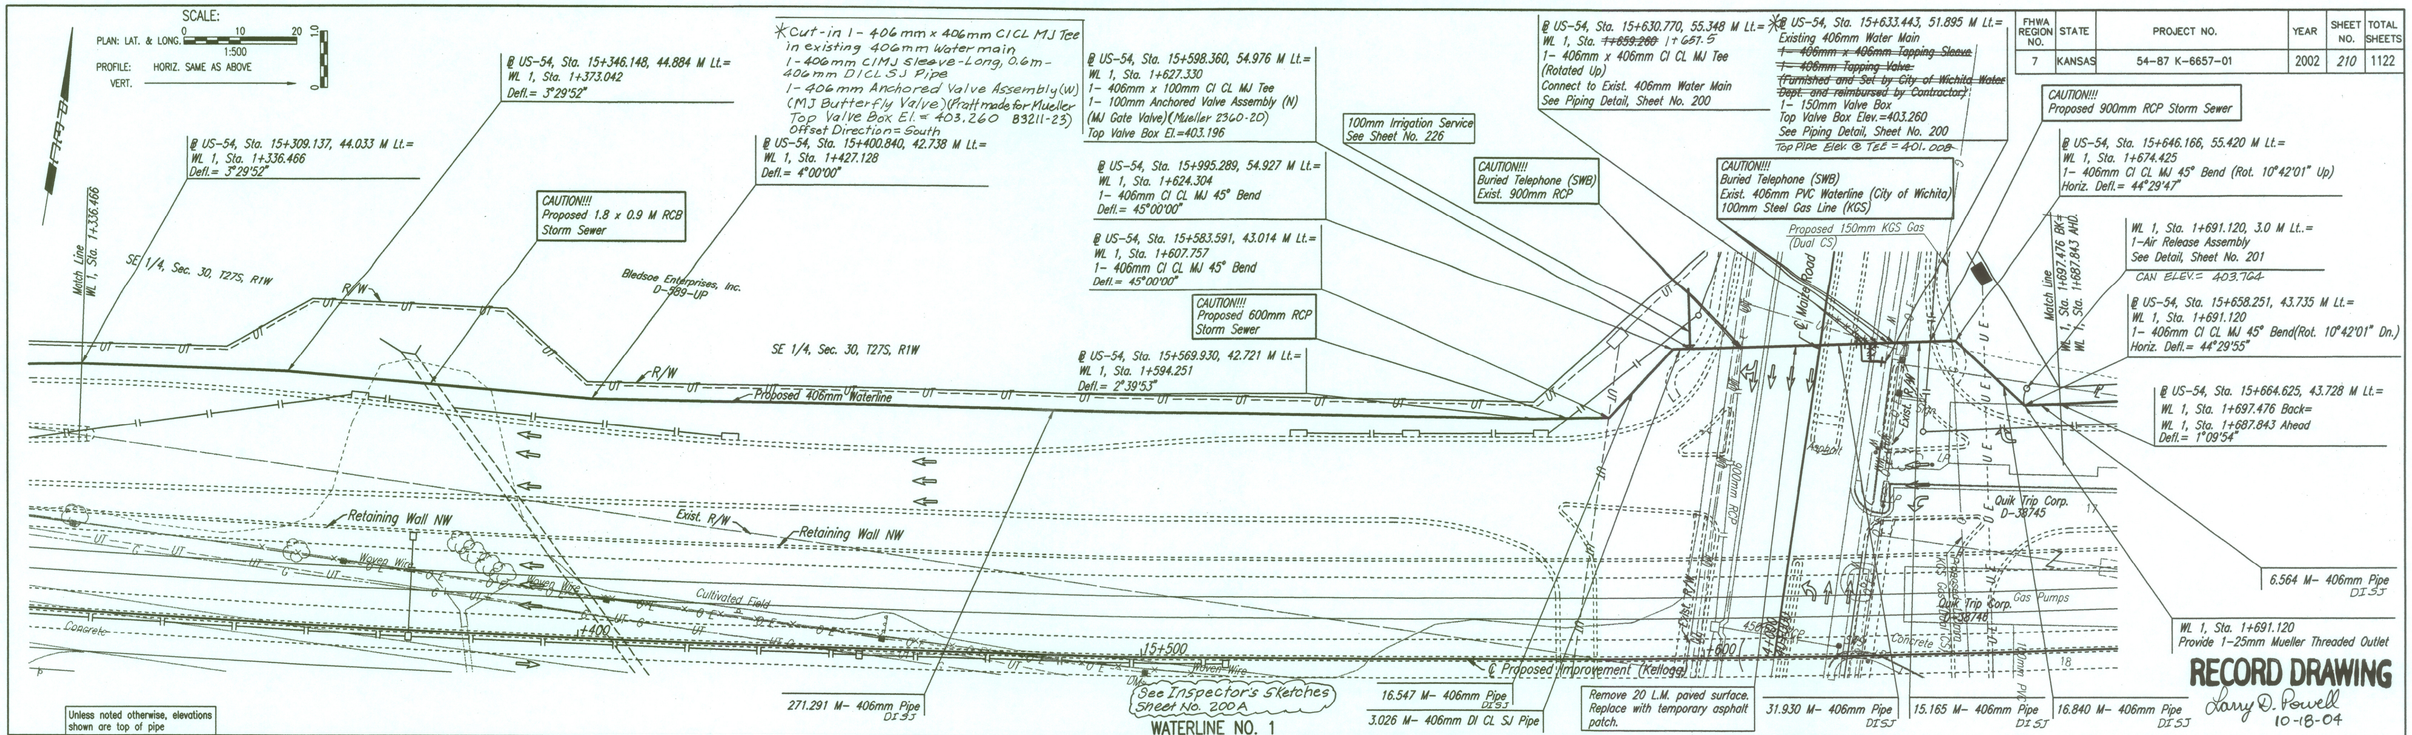

Unless noted otherwise, elevations shown are top of pipe

DSNR: KJW OPER: TDS SCALE: 1=0.50
Q:\1997\97362\007\wpp05 04-12-2002 11:06:15 am