FHWA REGION NO.	STATE	PROJECT NO.	YEAR	SHEET NO.	TOTAL SHEETS
7	KANSAS	54-87 K-6657-01	2002	226	1122

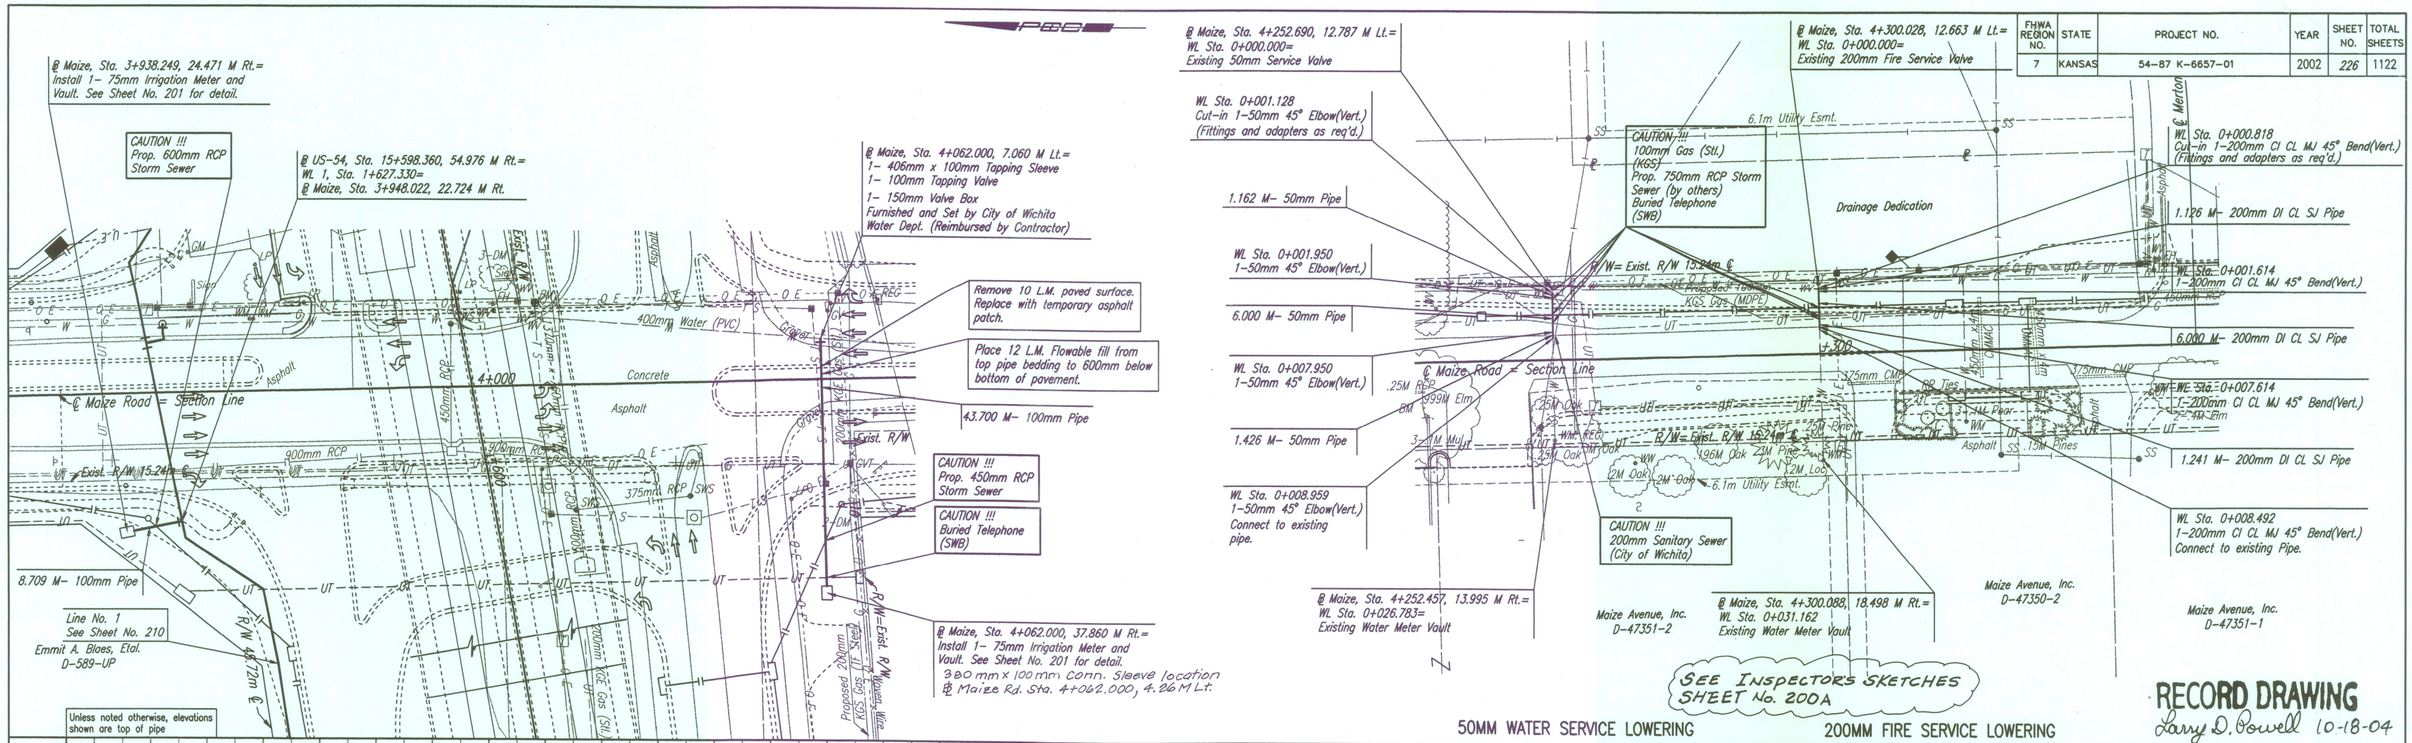

DSNR: KJW OPER: TDS SCALE: 1=0.50
Q:\1997\97362\007\wlpp22_new 04-12-2002 11:22:20 am