


STATE	PROJECT NO.	YEAR	SHEET NO.	TOTAL SHEETS
KANSAS	54-87 K-6657-01	2002	242	1122

DATE	
BY	
REFERENCES NOTED	
REFERENCES CHECKED	



NOTE:
Mechanically Stabilized Earth (MSE) Walls were constructed in lieu of Cast-In-Place Retaining Walls. See Submittal #'s 21.1, 21.1.A, 21.2.A, 21.2.B, 21.2.C, 21.3.A, 34.1.A, 34.1.B, 34.2.A, 34.3.A & 34.3. Also see Special Provision 90M-110-R3.

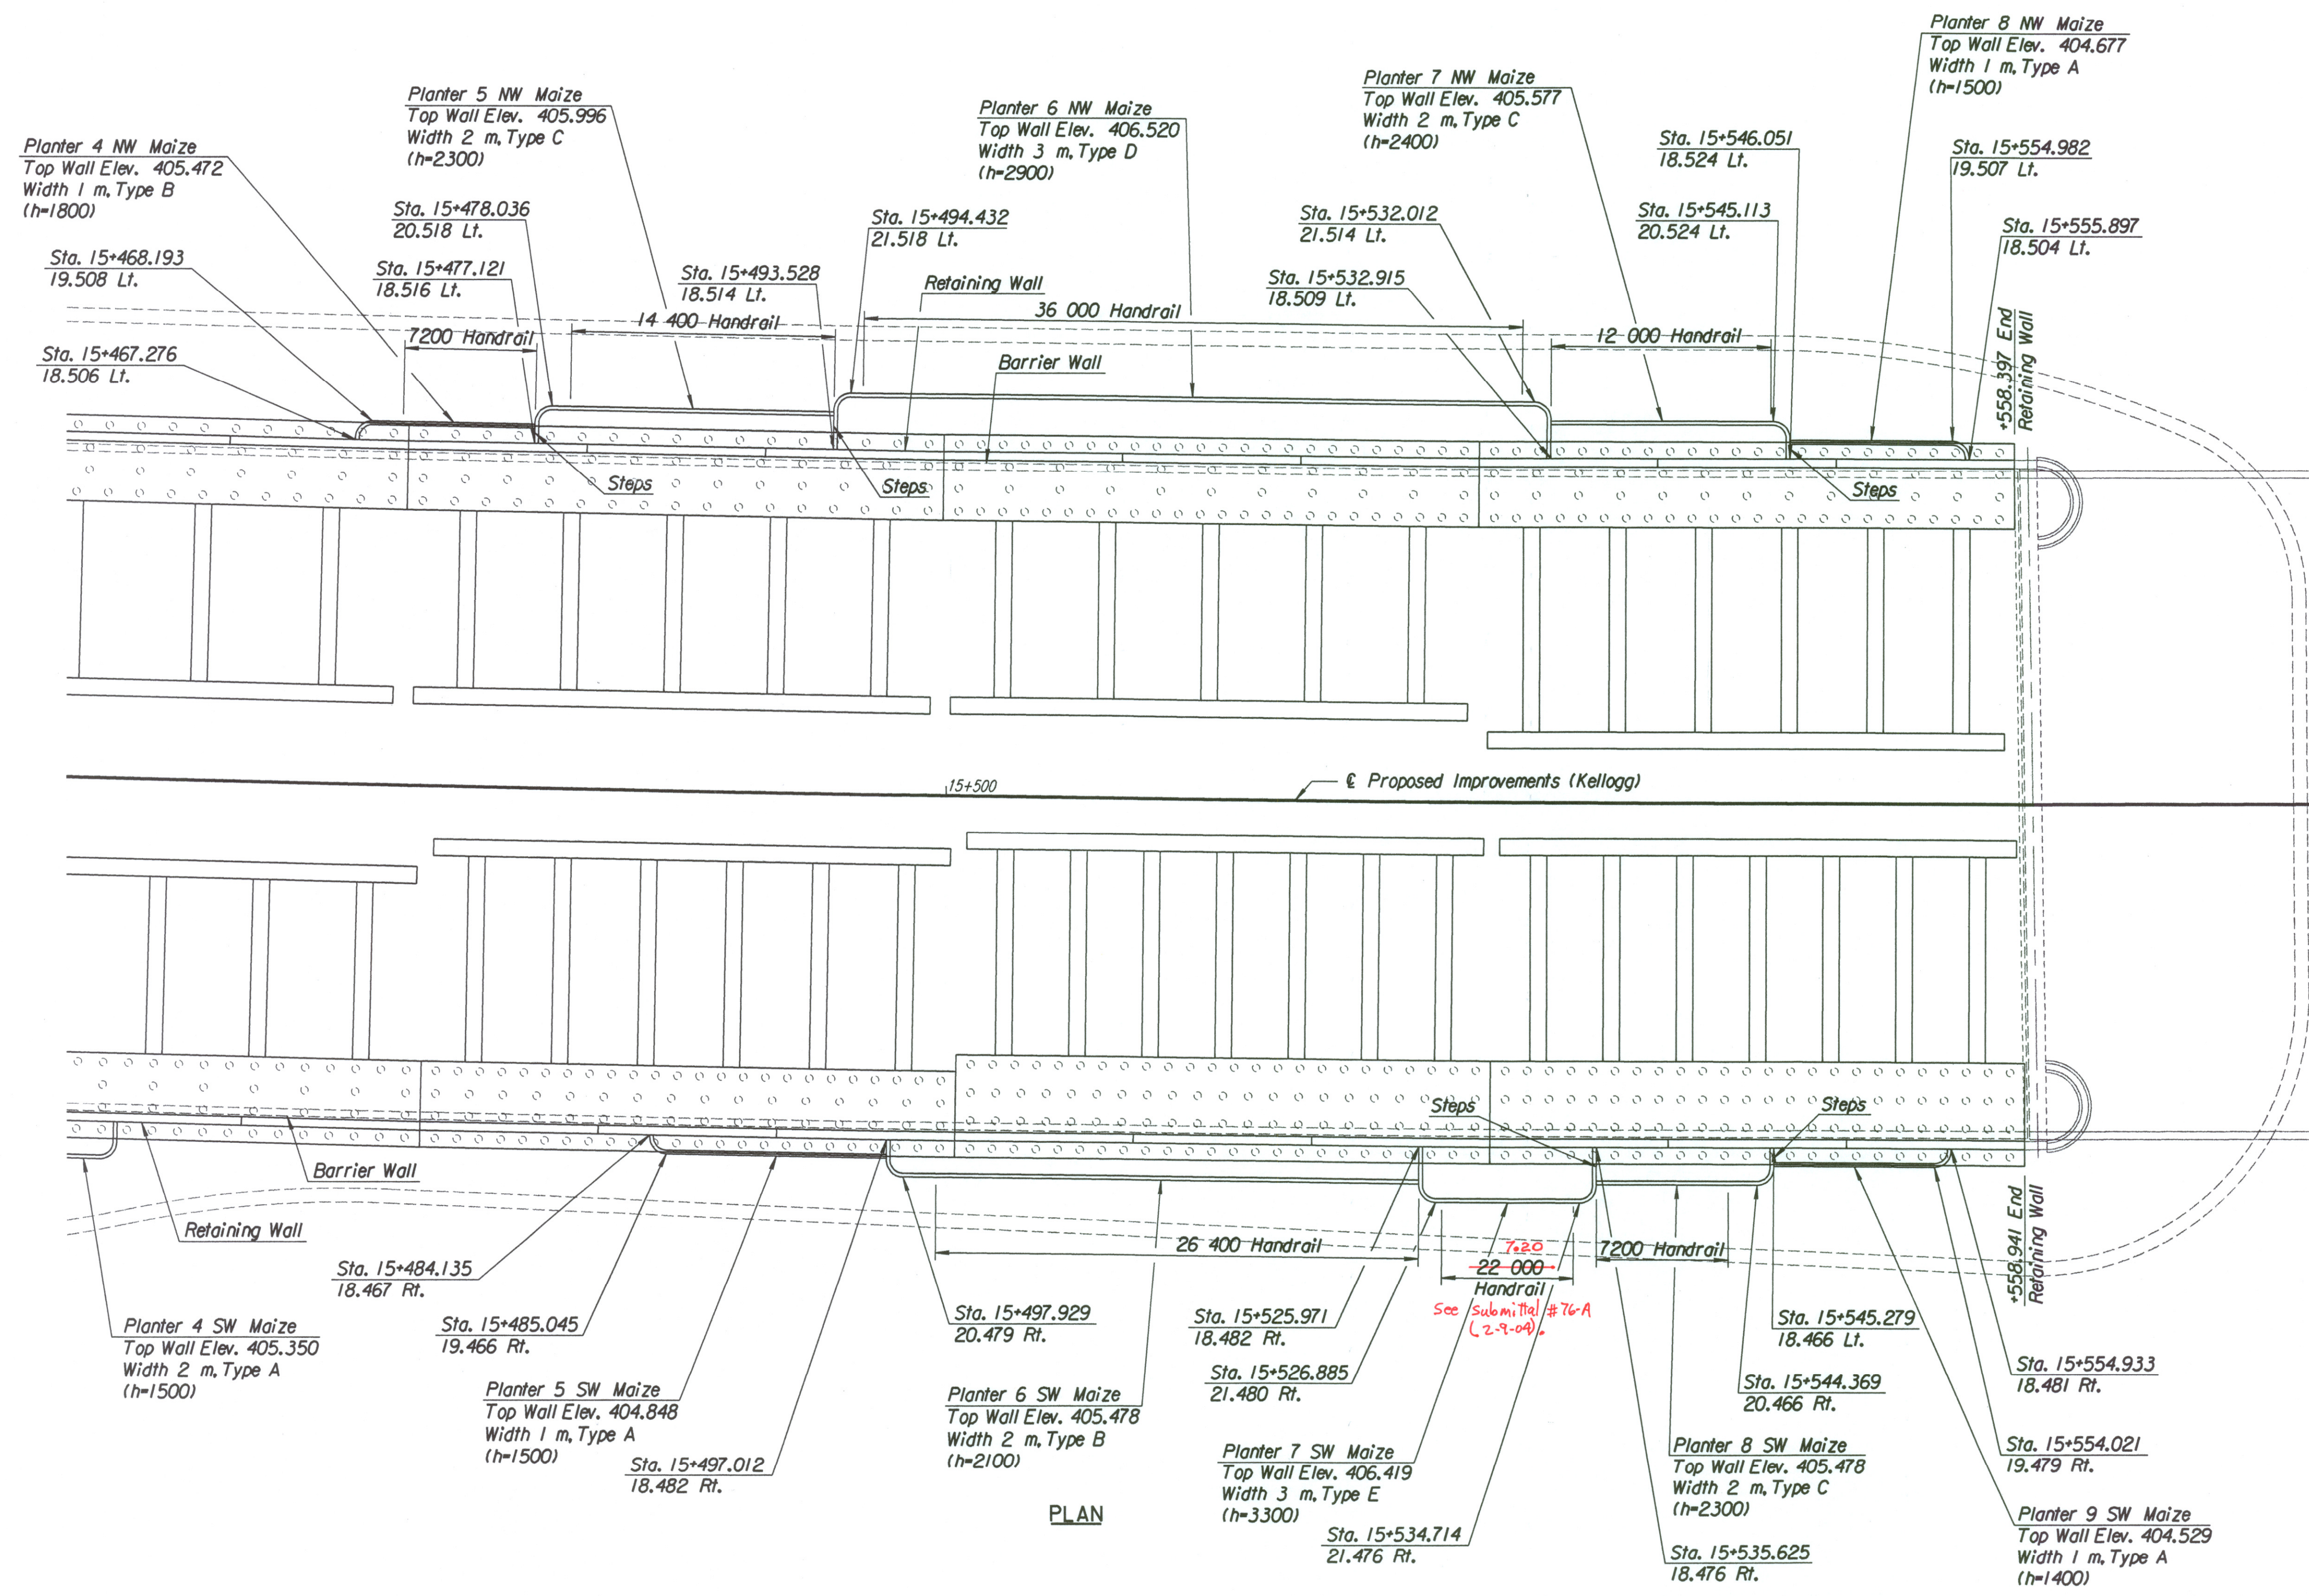

PLAN

Note: See Sheet No. 238A for Wall Type A thru Wall Type E. "h" equals Top of Planter Wall to Bottom of Footing.

DSNR: PDF OPER: DRP SCALE: 1:200
I:\1997\97362\001\RETWALL\PLANTWALL3.DGN 3-19-2002 12:55:45 LAST REV: 4-11-2002 BY: drp

No.	Revisions	By	Date

CITY OF WICHITA
KELLOGG
CAST IN PLACE RETAINING WALL
STA. 15+462 to STA. 15+611
SEDGWICK COUNTY

Professional Engineering Consultants, P.A.
303 S. TOPEKA • WICHITA, KANSAS 67202
316-262-2691 • FAX 316-262-3003

Designed by	PDF	Checked by	RAS
Drawn by	DRP	Date	April, 2002
		Job No.	97362