


STATE	PROJECT NO.	YEAR	SHEET NO.	TOTAL SHEETS
KANSAS	54-87 K-6657-01	2002	248	1122



BY	DATE
REFERENCES NOTED	REFERENCES CHECKED

DSNR: PDF OPER: DRP SCALE: 1:200
 i:/1997/97362/001/RETWALL/PLANTWALL9.DGN 3-19-2002 15:01:19 LAST REV: 4-11-2002 BY: drp

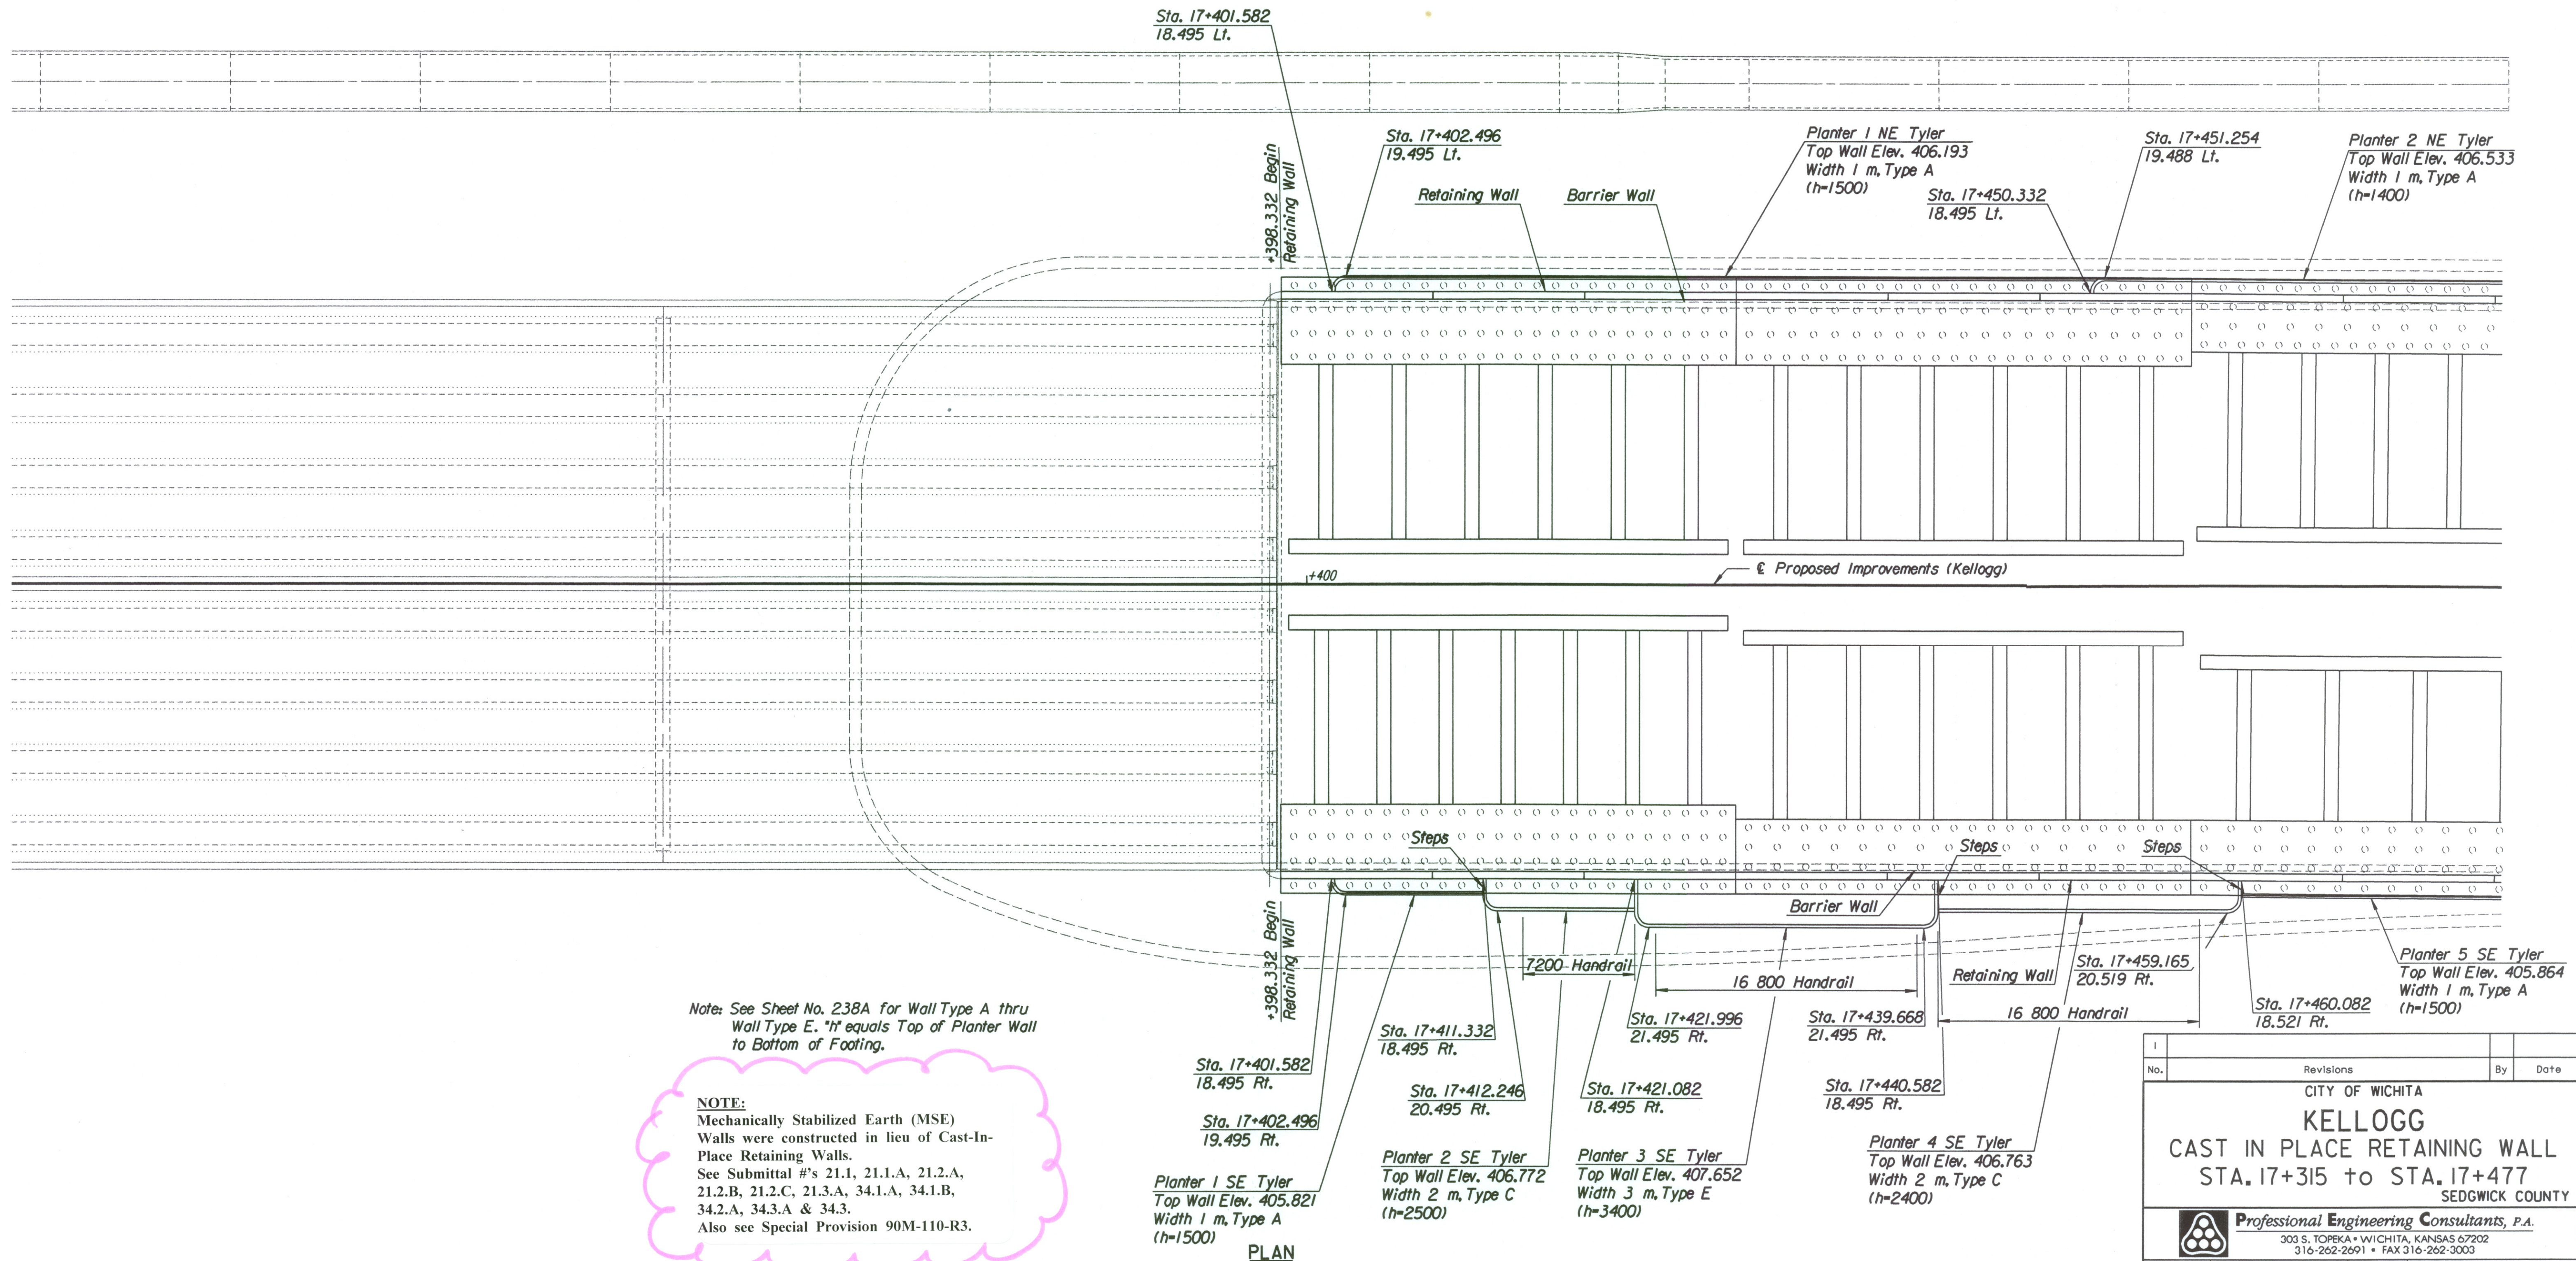

Note: See Sheet No. 238A For Wall Type A thru Wall Type E. *It equals Top of Planter Wall to Bottom of Footing.

NOTE:
 Mechanically Stabilized Earth (MSE) Walls were constructed in lieu of Cast-In-Place Retaining Walls. See Submittal #'s 21.1, 21.1.A, 21.2.A, 21.2.B, 21.2.C, 21.3.A, 34.1.A, 34.1.B, 34.2.A, 34.3.A & 34.3. Also see Special Provision 90M-110-R3.

PLAN

No.	Revisions	By	Date

CITY OF WICHITA
KELLOGG
 CAST IN PLACE RETAINING WALL
 STA. 17+315 to STA. 17+477
 SEDGWICK COUNTY

Professional Engineering Consultants, P.A.
 303 S. TOPEKA • WICHITA, KANSAS 67202
 316-262-2691 • FAX 316-262-3003

Designed by	PDF	Checked by	RAS
Drawn by	DRP	Date	Apr 11, 2002
Job No.	97362		