


FHWA REGION NO.	STATE	PROJECT NO.	YEAR	SHEET NO.	TOTAL SHEETS
7	KANSAS	54-87 K-6657-01	2002	380	1122

DATE	BY

DSNR: WDH OPER: JGP SCALE: 1:500
 I:/1997/97362/001/RETWALL/MNE_PROFILE.DGN 13:50:48
 LAST REV: 12-20-01 BY: JGP

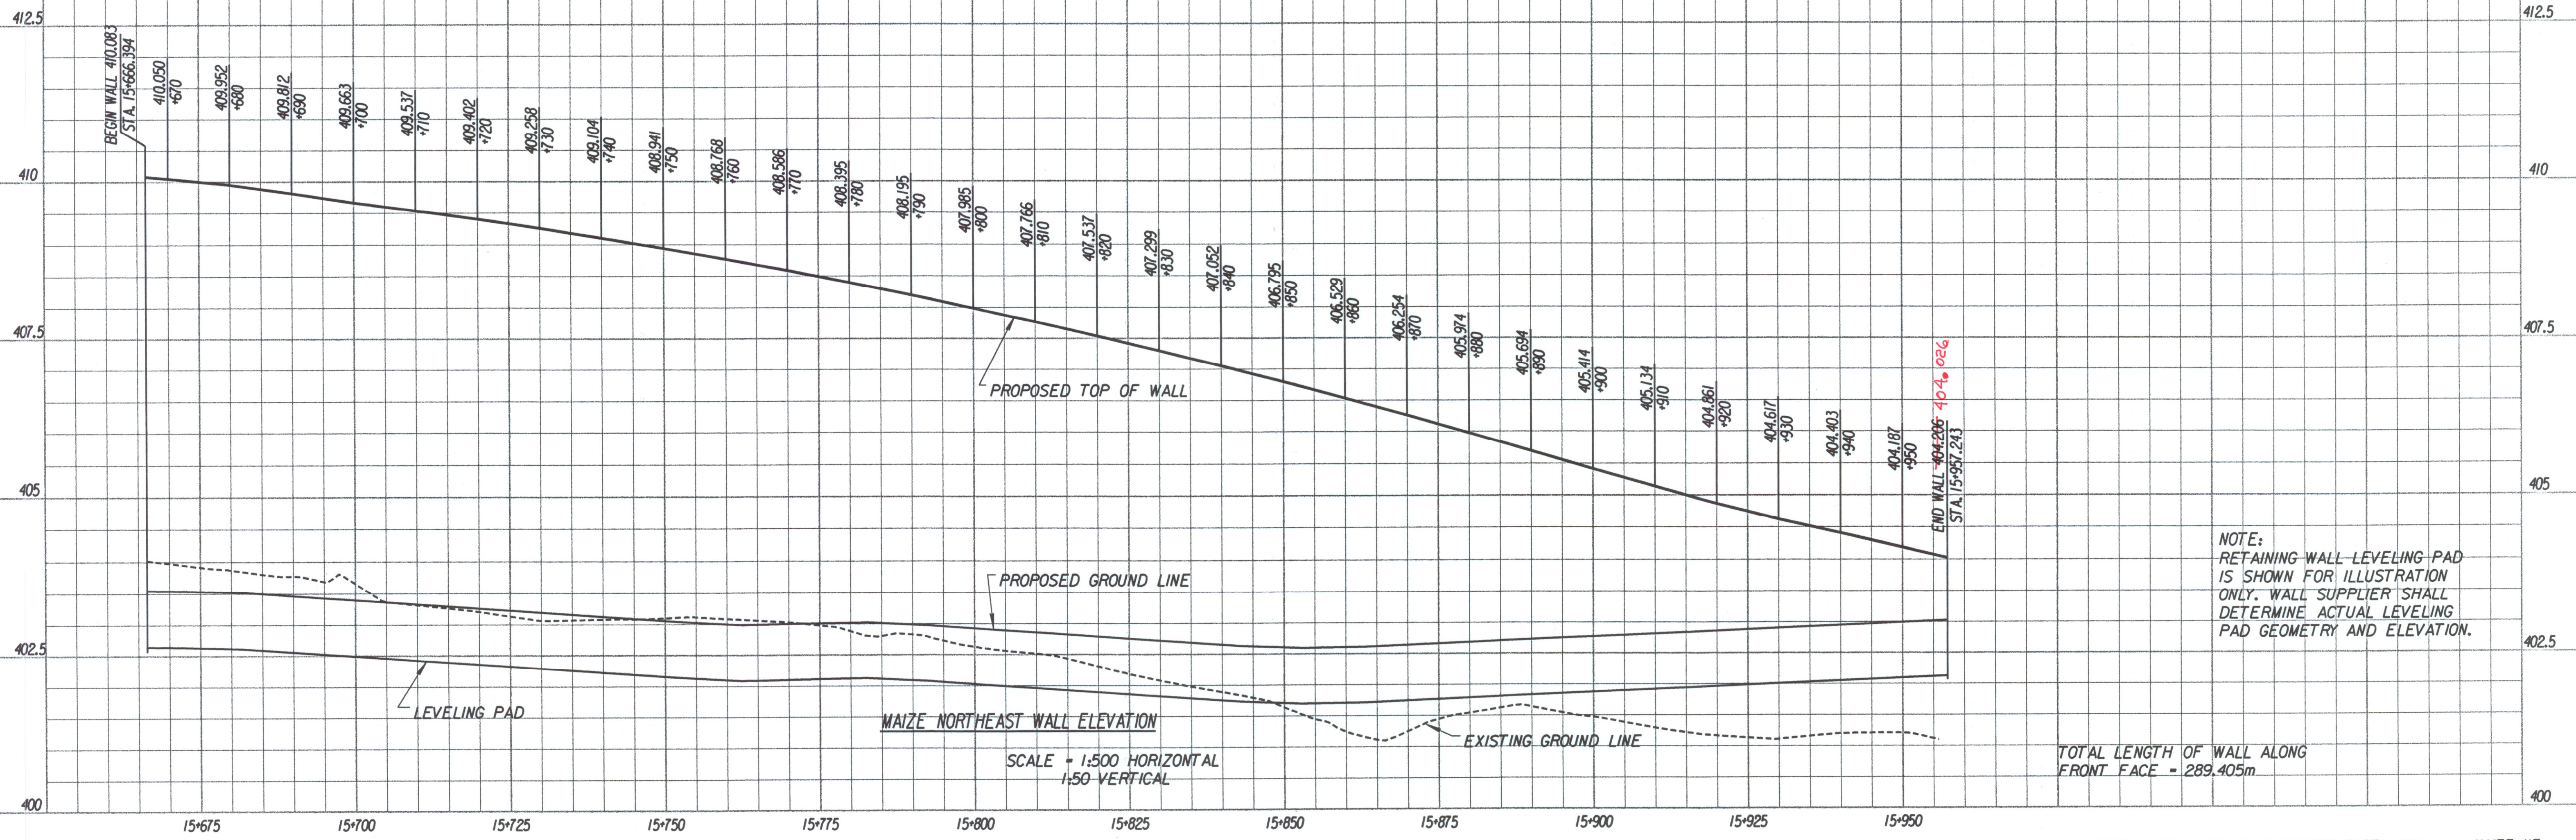

PROPOSED TOP OF WALL

PROPOSED GROUND LINE

LEVELING PAD

MAIZE NORTHEAST WALL ELEVATION

SCALE = 1:500 HORIZONTAL
 1:50 VERTICAL

EXISTING GROUND LINE

NOTE:
 RETAINING WALL LEVELING PAD
 IS SHOWN FOR ILLUSTRATION
 ONLY. WALL SUPPLIER SHALL
 DETERMINE ACTUAL LEVELING
 PAD GEOMETRY AND ELEVATION.

TOTAL LENGTH OF WALL ALONG
 FRONT FACE = 289.405m