


FHWA REGION NO.	STATE	PROJECT NO.	YEAR	SHEET NO.	TOTAL SHEETS
7	KANSAS	54-87 K-6657-01	2002	383	1122

REFERENCES NOTED	DATE
REFERENCES CHECKED	

BY: _____

DSNR: WDH OPER: JGP SCALE: 1:500
 I:/1997/97362/001/RETWALL/TNW PROFILE.DGN 3-11-2002 14:13:03 LAST REV:

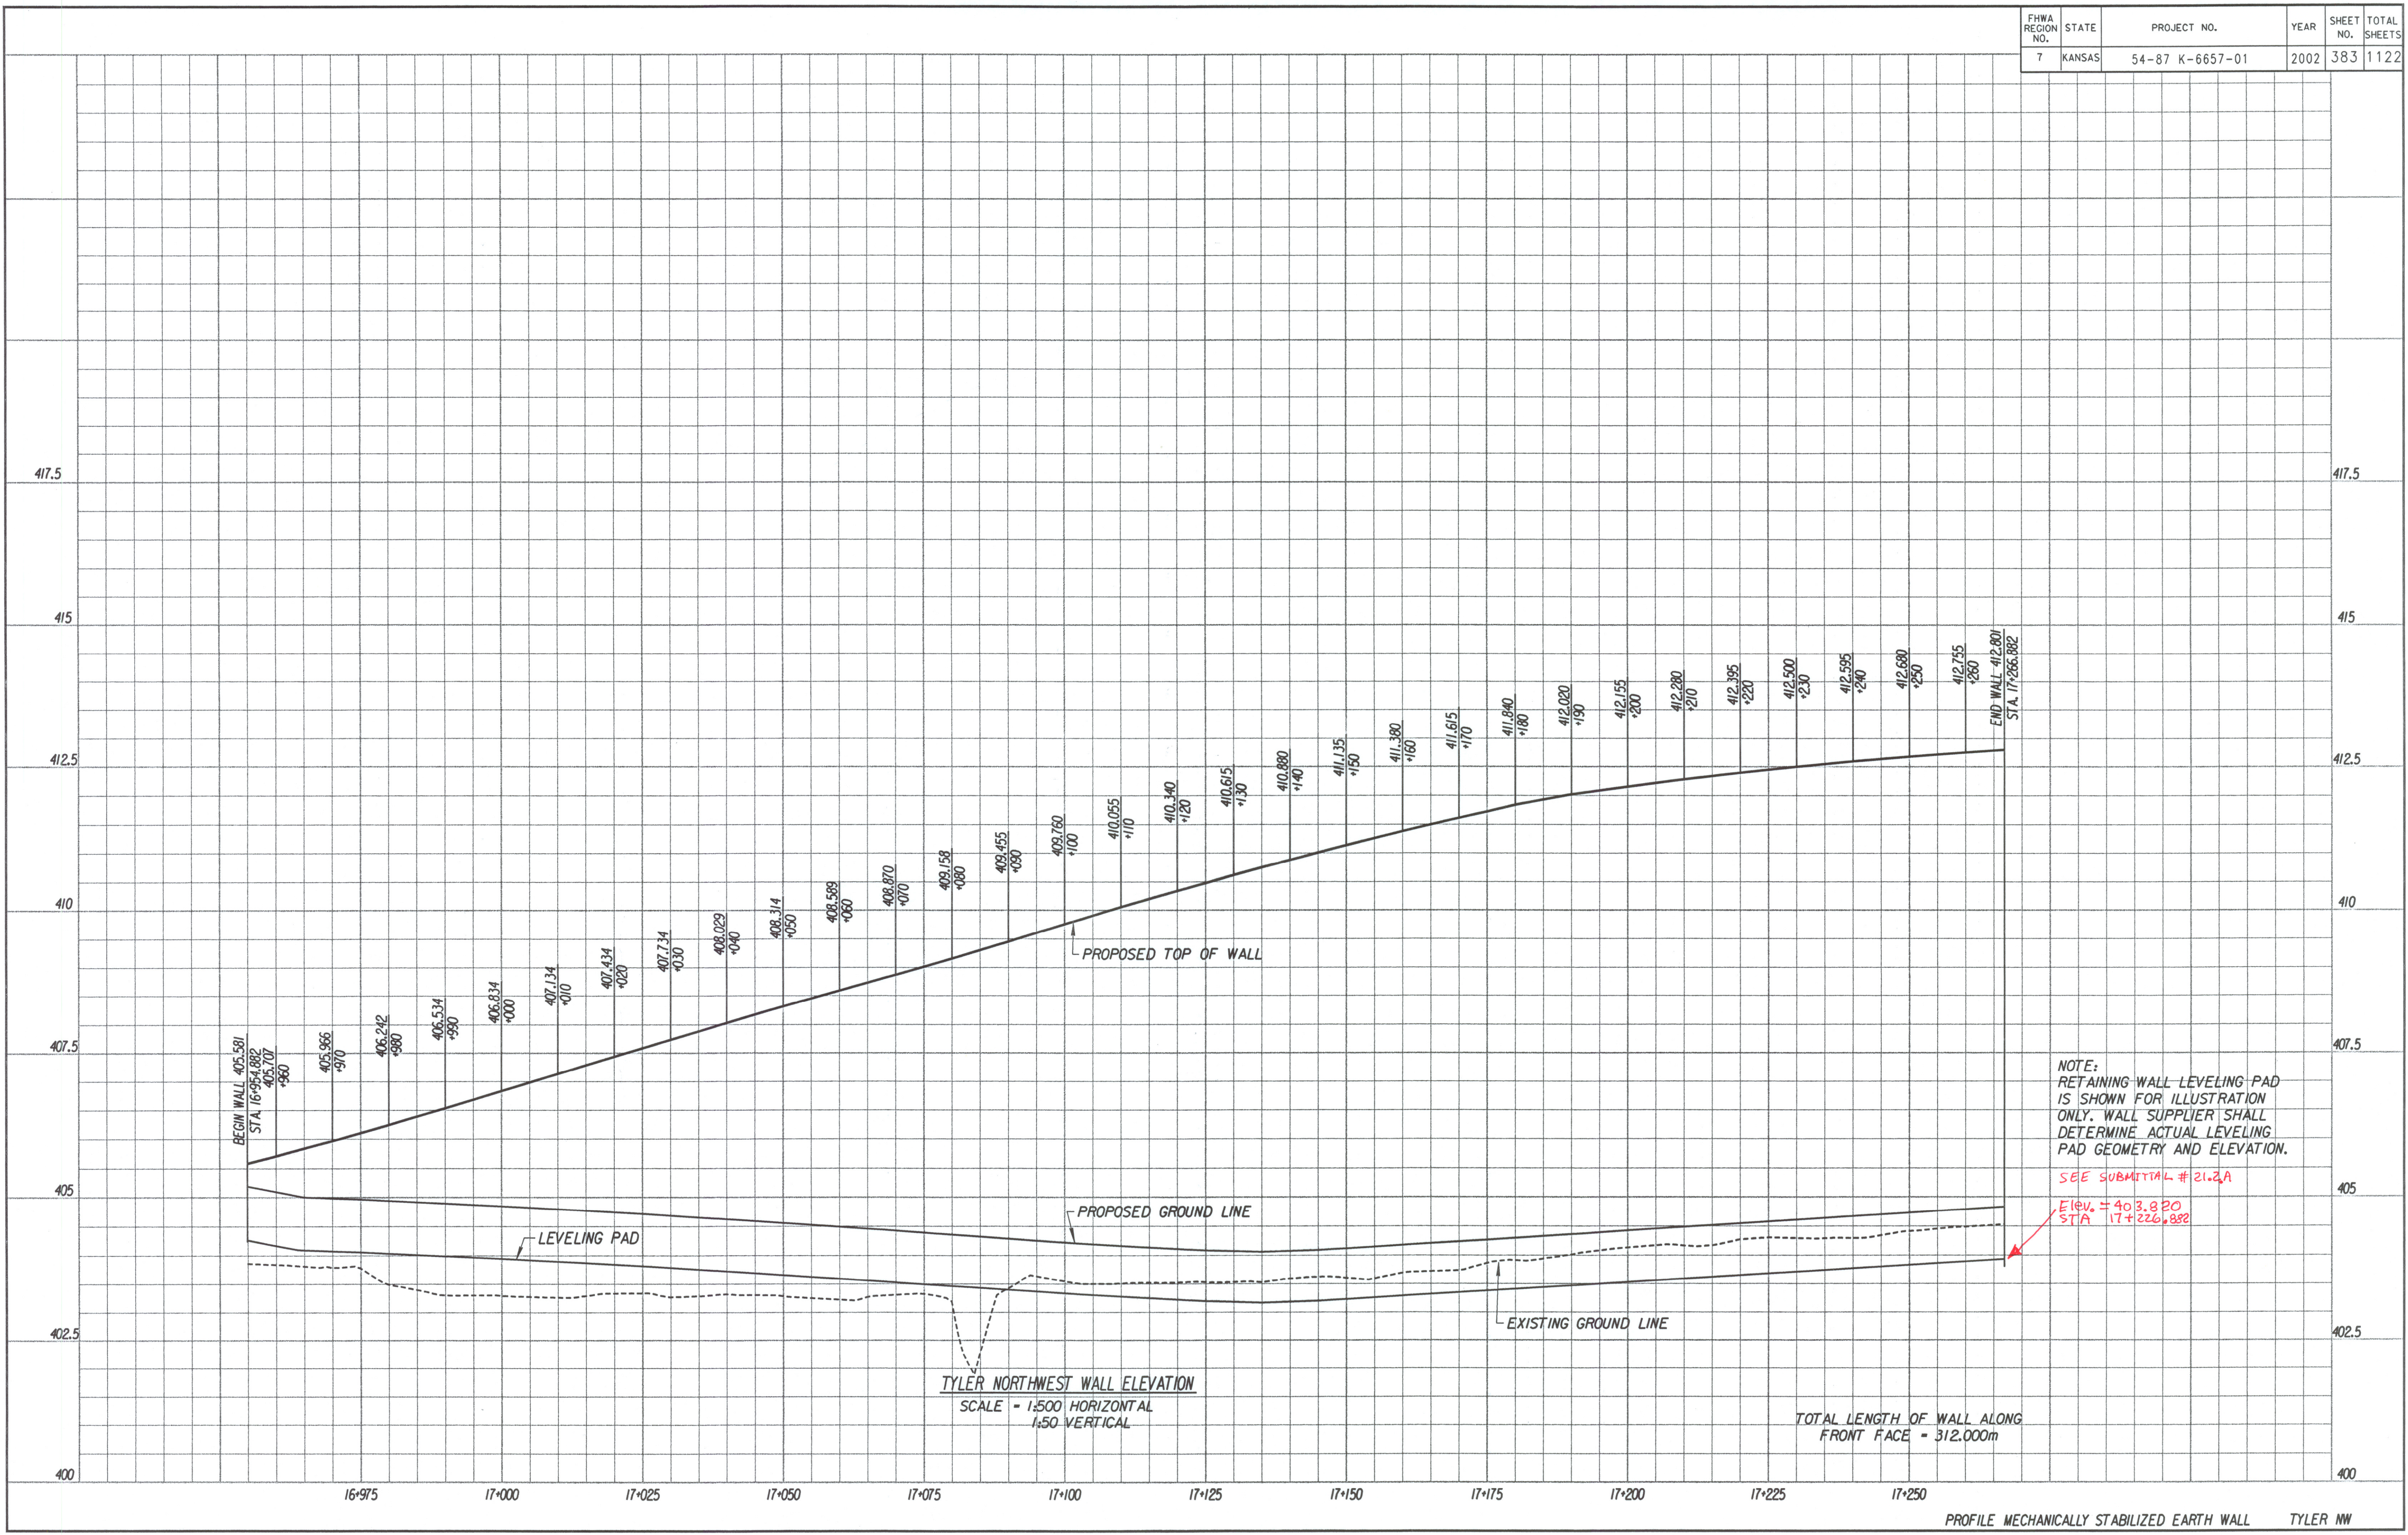

NOTE:
 RETAINING WALL LEVELING PAD
 IS SHOWN FOR ILLUSTRATION
 ONLY. WALL SUPPLIER SHALL
 DETERMINE ACTUAL LEVELING
 PAD GEOMETRY AND ELEVATION.

SEE SUBMITTAL # 21.2.A

Elev. = 403.820
 STA 17+226.882

TYLER NORTHWEST WALL ELEVATION
 SCALE = 1:500 HORIZONTAL
 1:50 VERTICAL

TOTAL LENGTH OF WALL ALONG
 FRONT FACE = 312.000m