
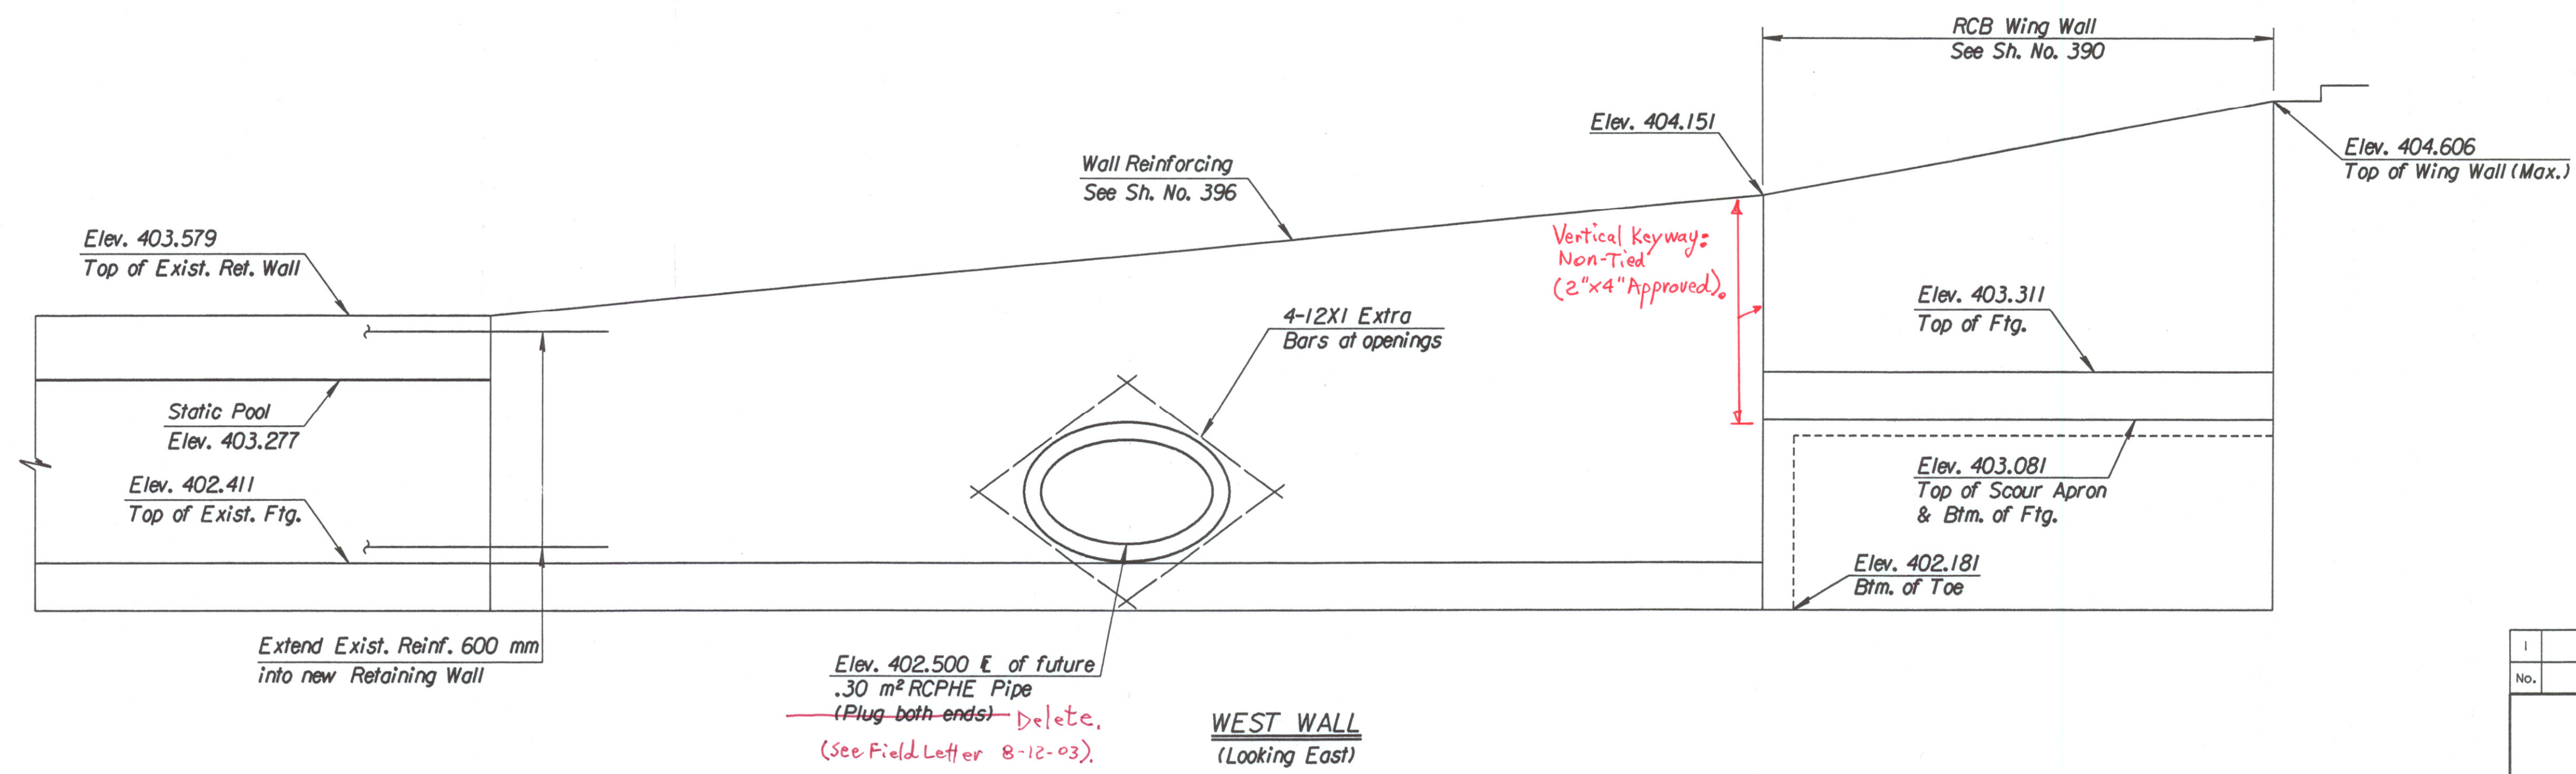


FHWA REGION NO.	STATE	PROJECT NO.	YEAR	SHEET NO.	TOTAL SHEETS
7	KANSAS	54-87 K-6657-01	2002	397	1122

DATE	
BY	
REFERENCES NOTED	
REFERENCES CHECKED	

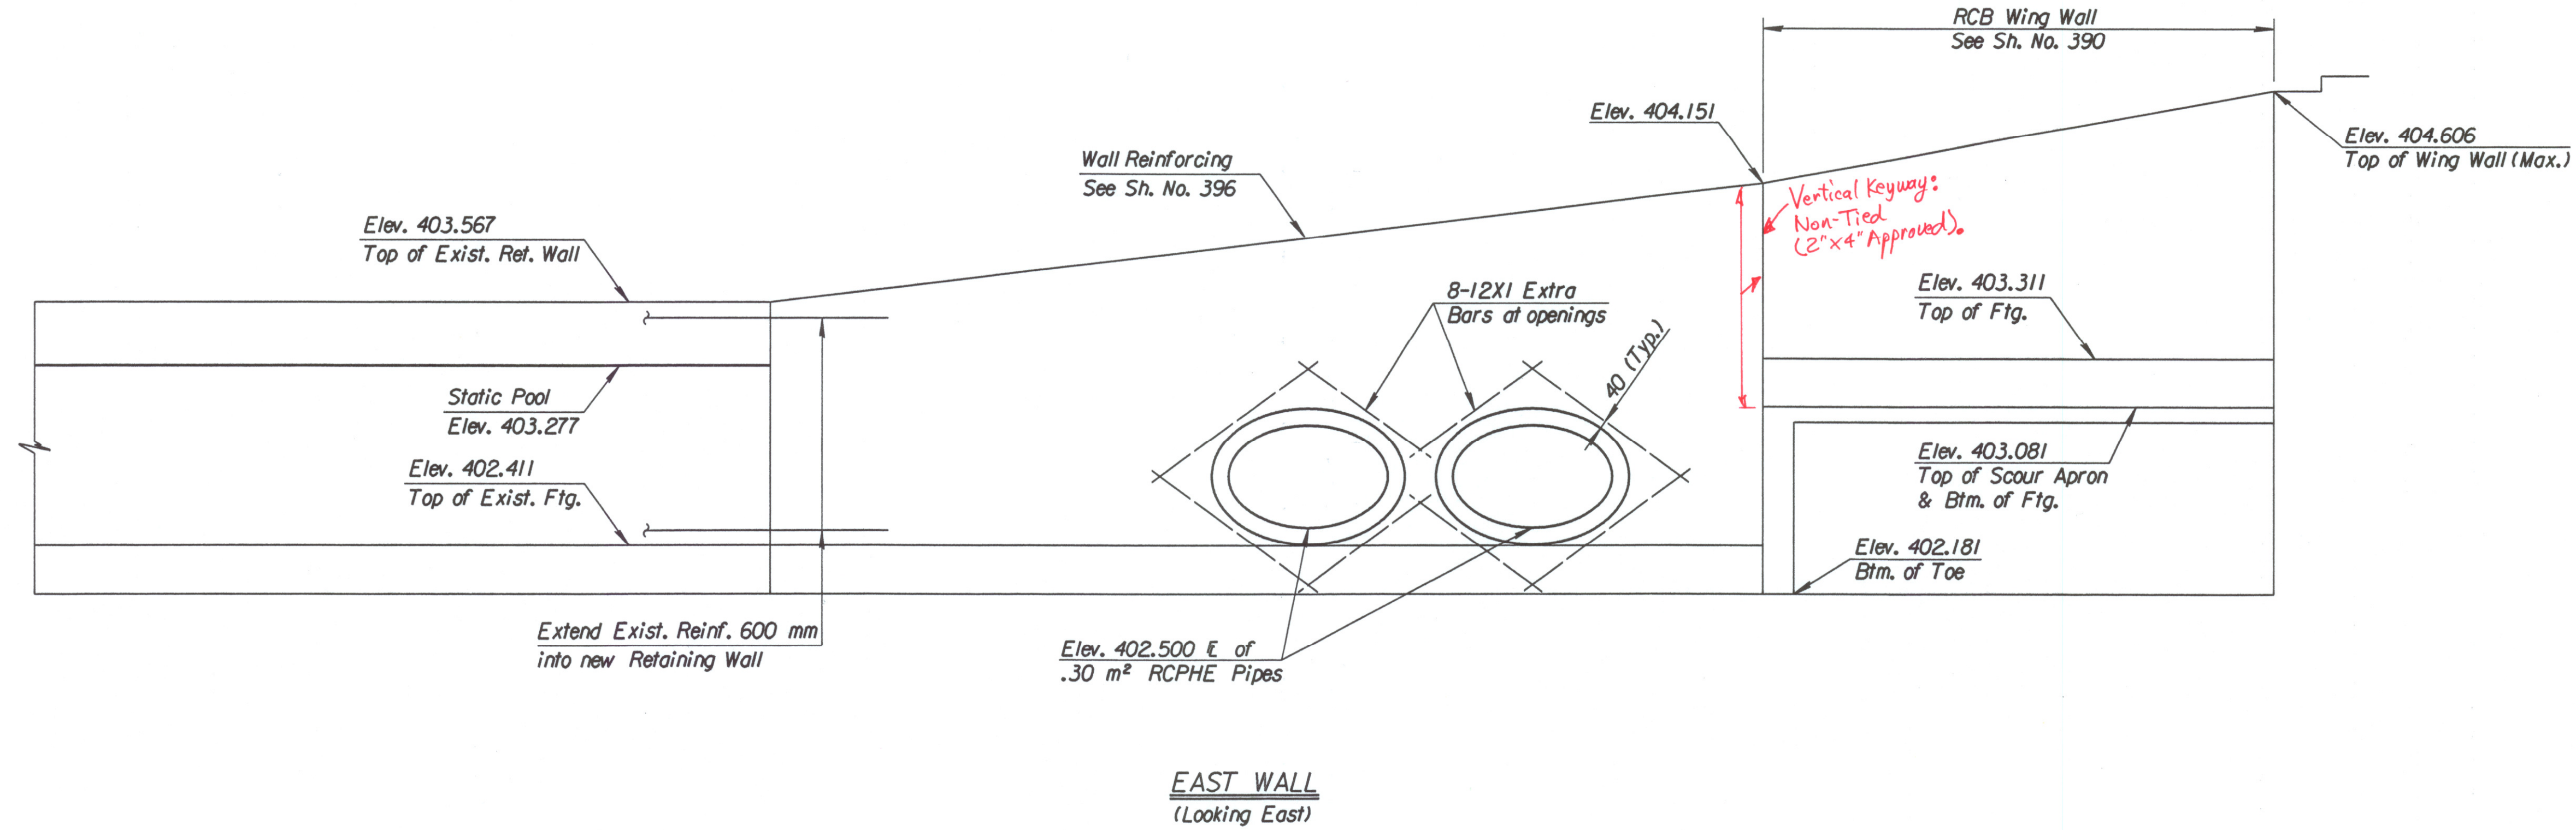

DSNR: RWA OPER: DRP SCALE: 1:20  
 i:/1997/97362/001/RCB/WINGDETAIL.DGN 8-10-2001 10:27:00 LAST REV: 3-27-2002 BY: mdg

No.	Revisions	By	Date
KANSAS DEPARTMENT OF TRANSPORTATION <b>EXTENDED WING WALL DETAILS</b>			
PROJECT NO. 54-87 K-6657-01		SEDGWICK COUNTY	
<b>Professional Engineering Consultants, P.A.</b> <small>303 S. TOPEKA • WICHITA, KANSAS 67202          316-262-2691 • FAX 316-262-3003</small>			
Designed by	RWA	Checked by	RAS
Drawn by	DRP	Date	April, 2002 Job No. 97362