
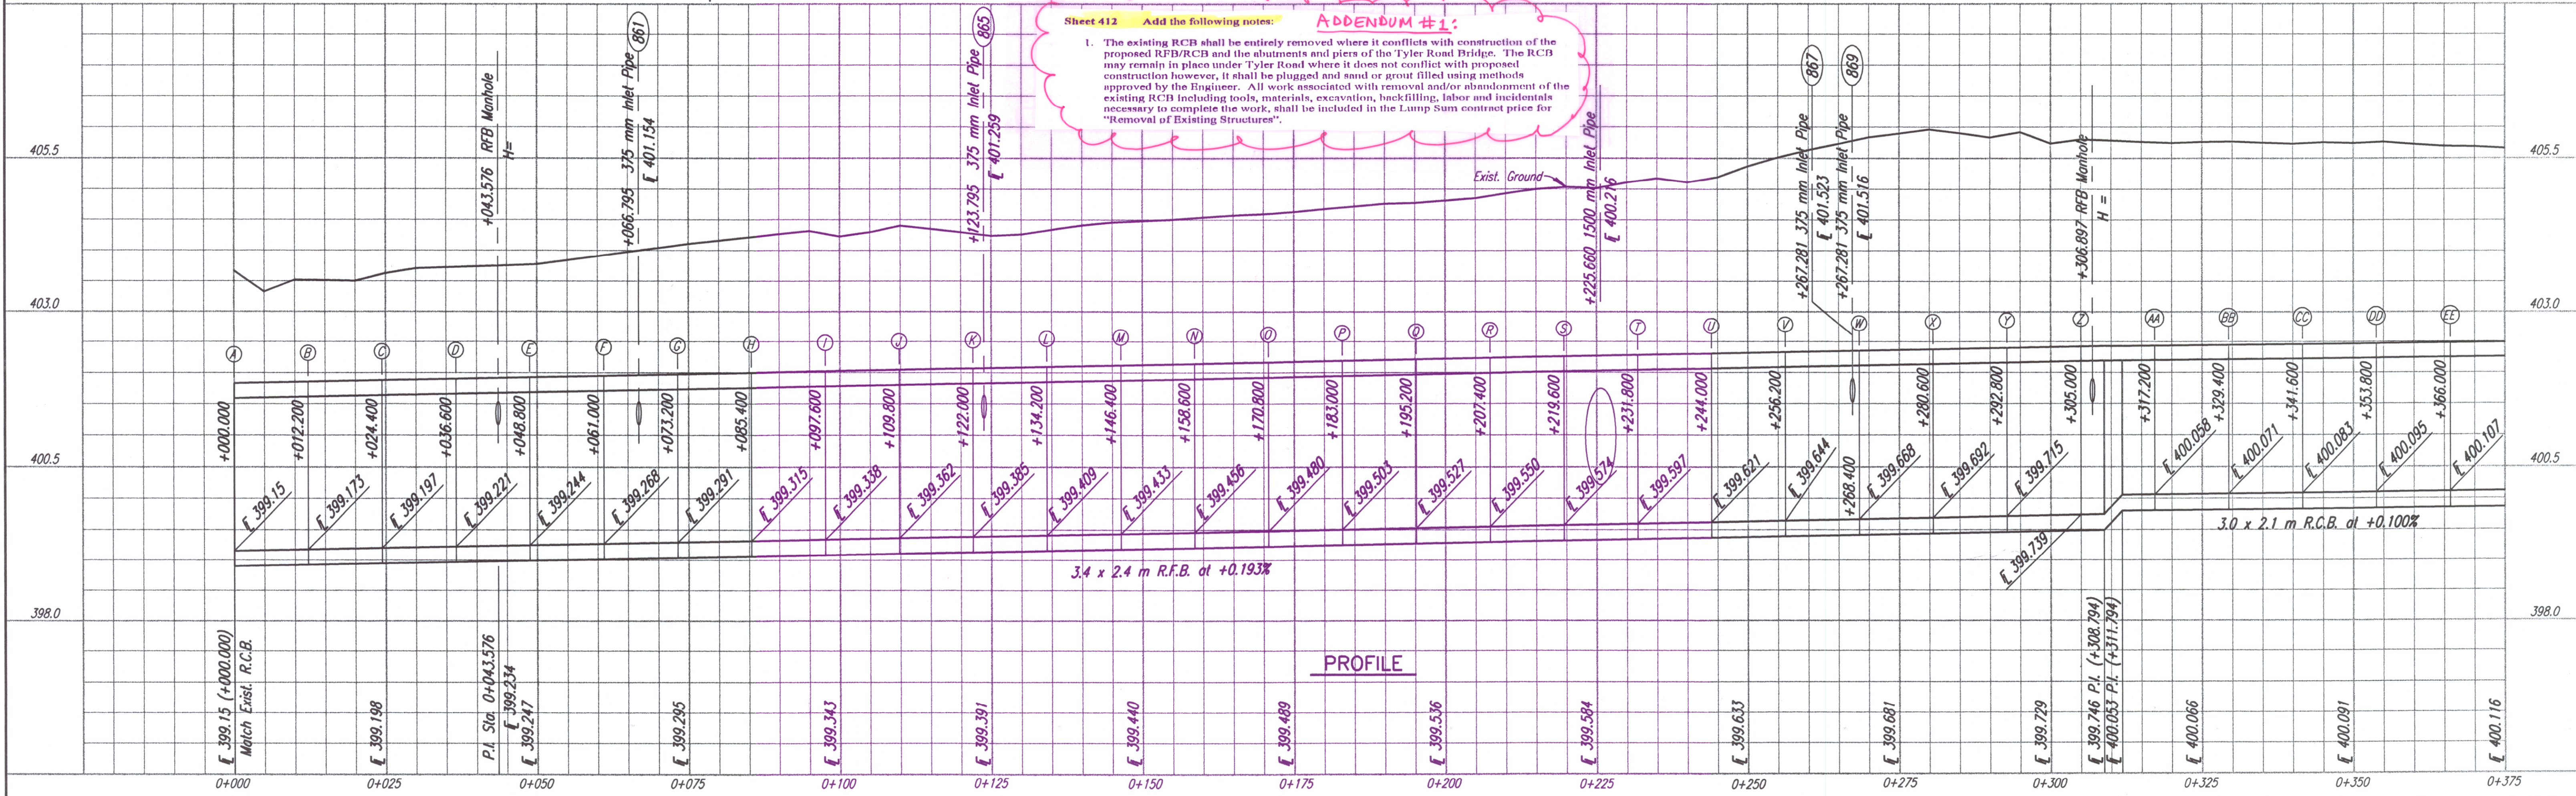


STATE	PROJECT NO.	YEAR	SHEET NO.	TOTAL SHEETS
KANSAS	54-87 K-6675-01	2002	412	1122

DATE	
BY	
REFERENCES NOTED	
REFERENCES CHECKED	

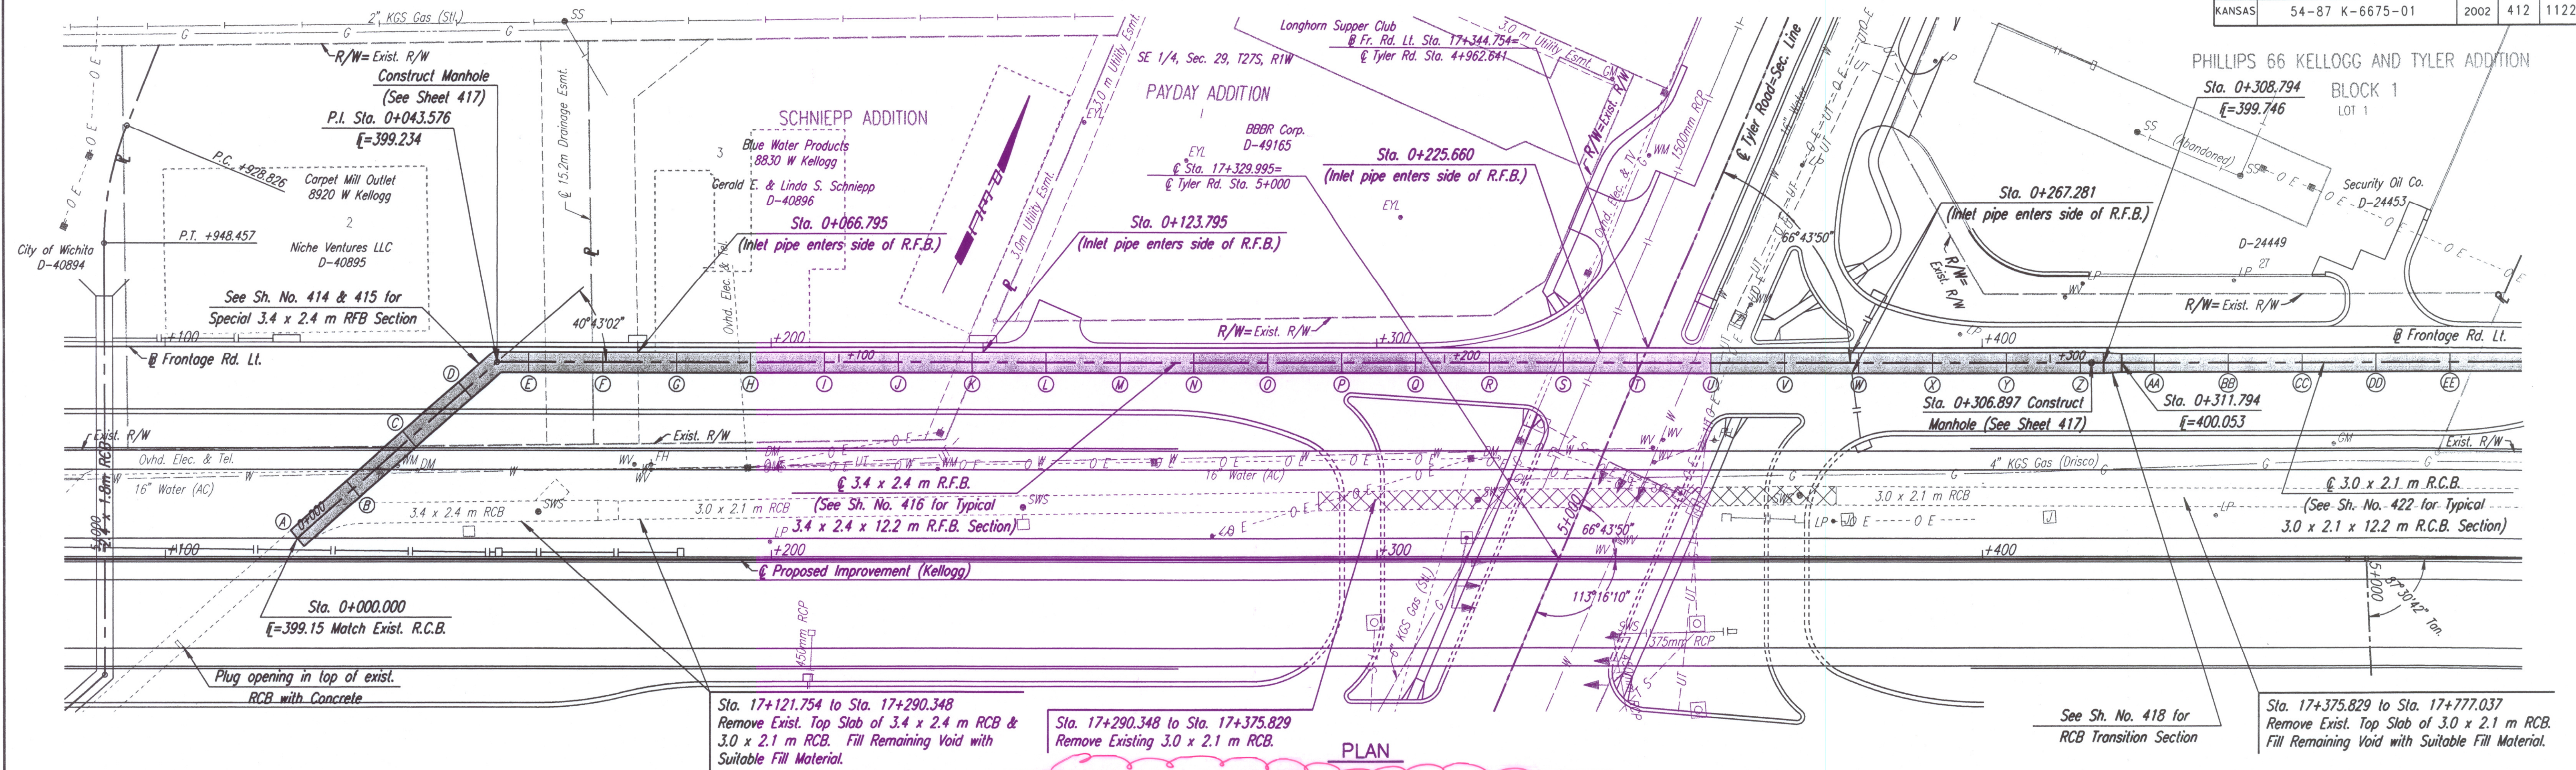

PLAN AND PROFILE -3.4 x 2.4 m R.F.B.

DSNR: OPER: GOR SCALE: 1:500
 1/1997/97362/RCB/RCB1148.DGN LAST REV: 2-9-2002 BY: ros