
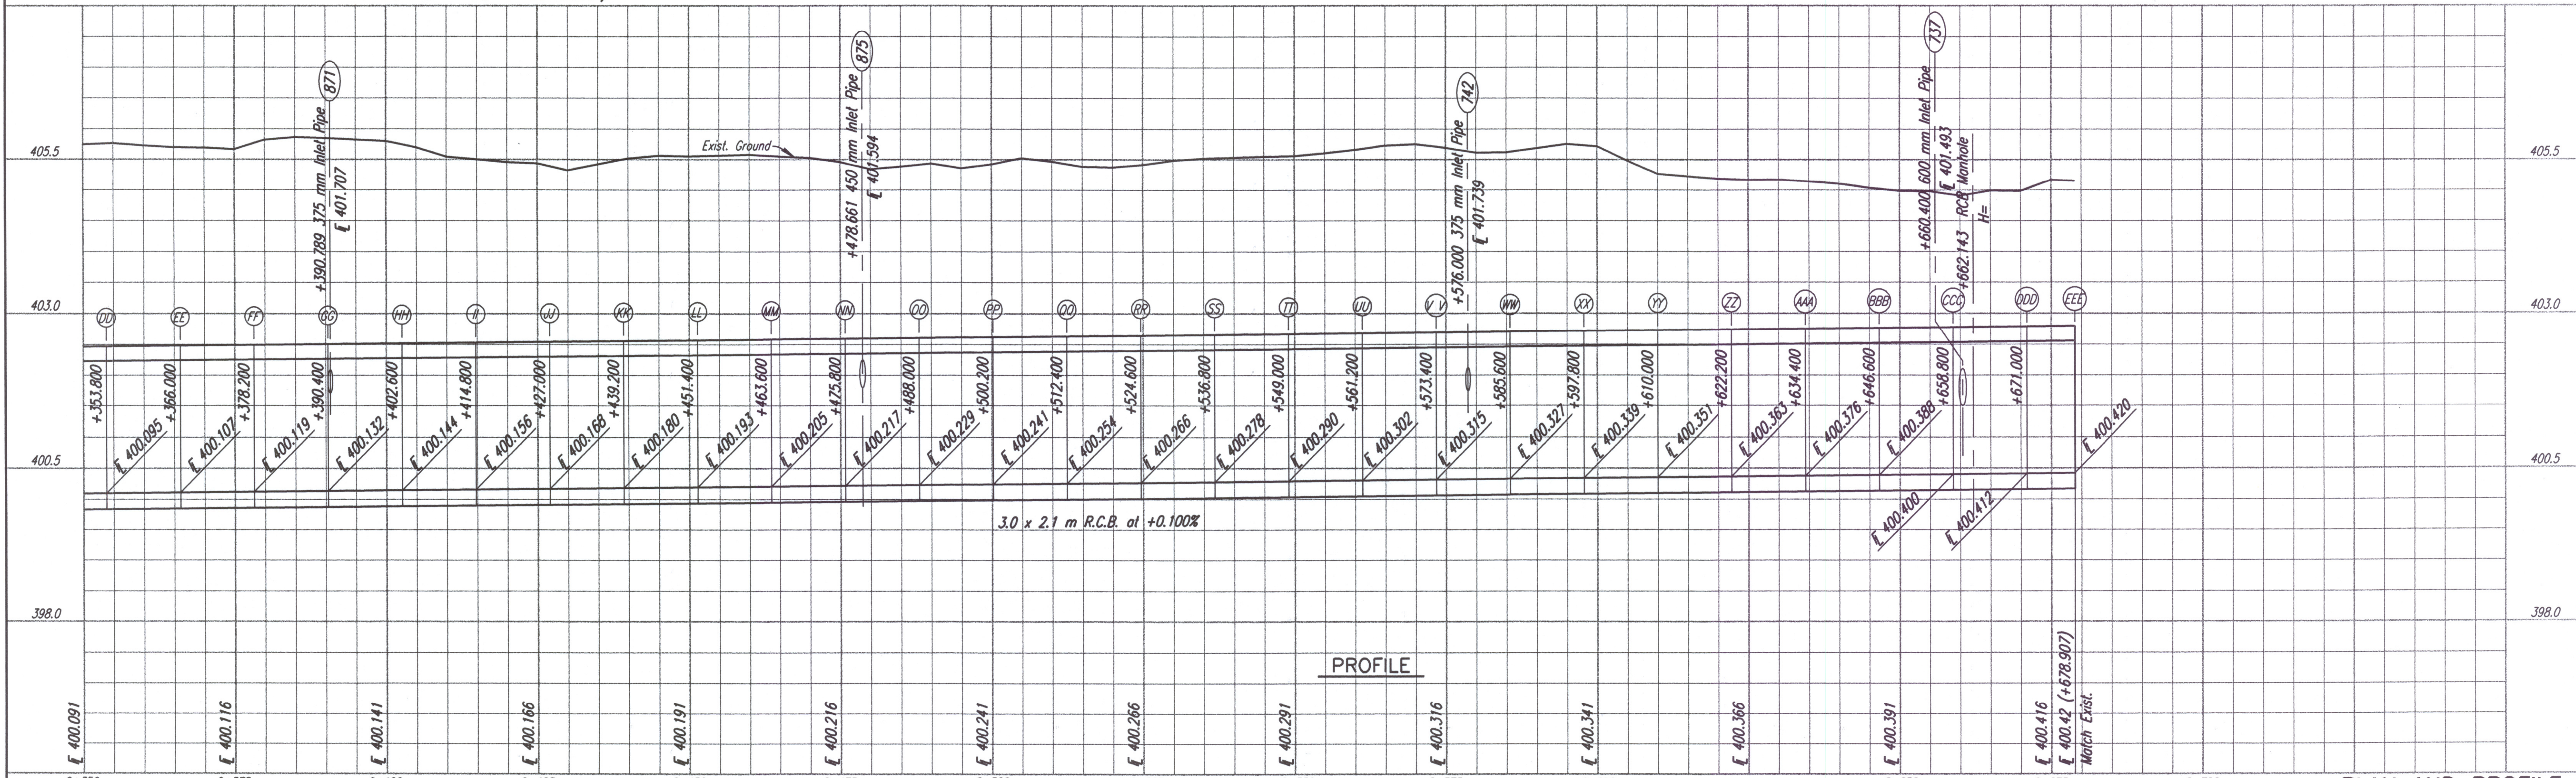


DATE	
BY	
REFERENCES NOTED	
REFERENCES CHECKED	

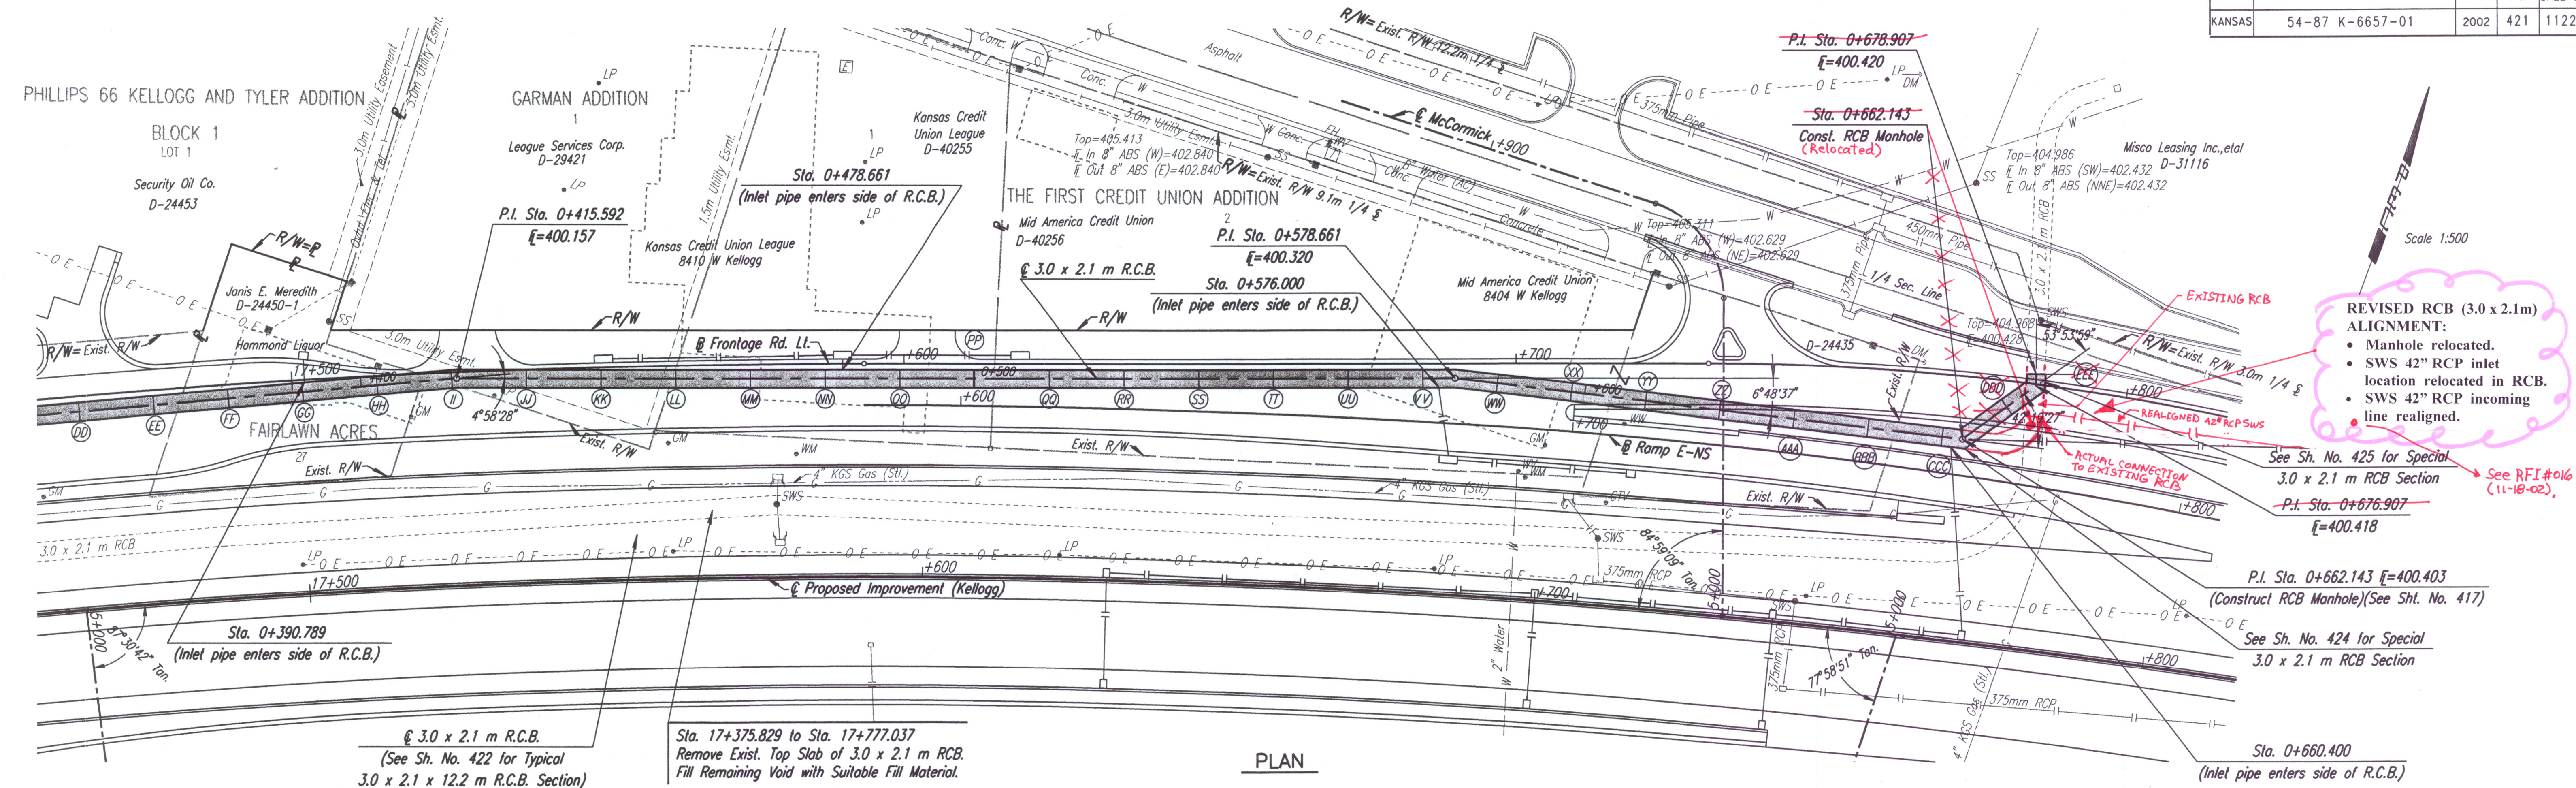

PLAN AND PROFILE
3.0 x 2.1 m R.C.B.

DSNR: OPER. GDR SCALE: 1:500
4/1997/93862/rcb/rcb10a7.dgn Last Rev. 2-11-2002 By: ros