



STATE	PROJECT NO.	YEAR	SHEET NO.	TOTAL SHEETS
KANSAS	54-87 K-6657-01	2002	451	1122

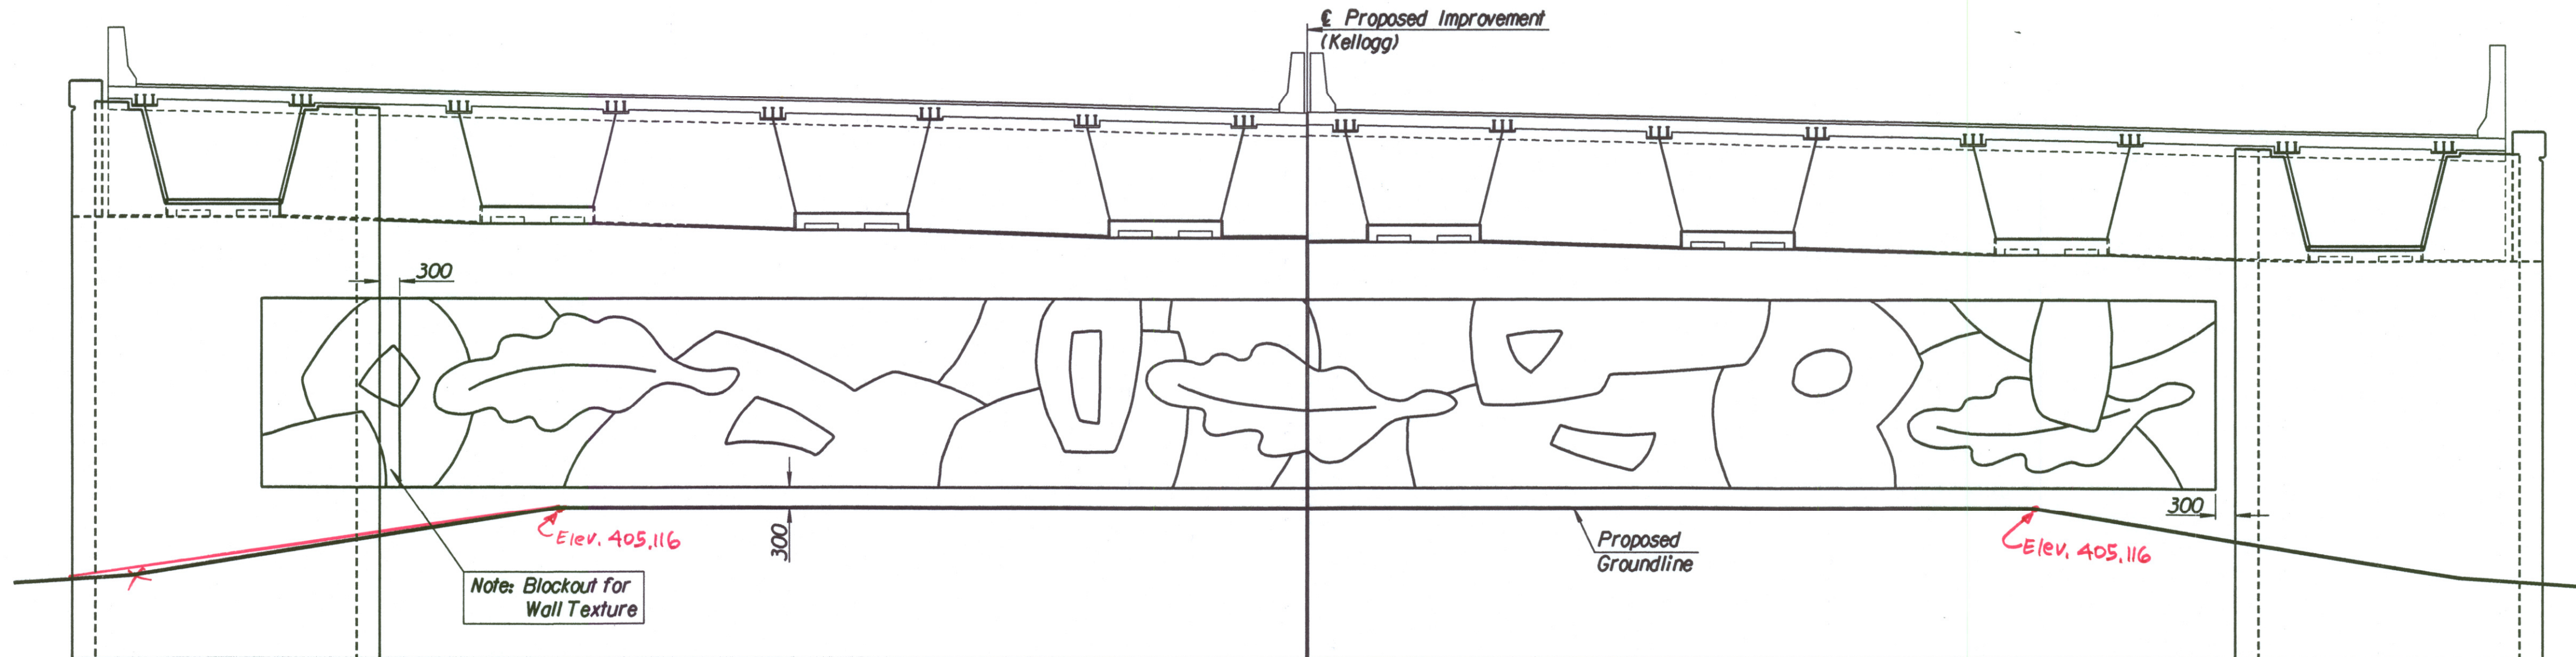

ABUTMENT NO. 1  
Looking Backstation

SPECIAL SURFACE TREATMENT: The area on the abutment walls depicting special art texture and delimited by the 300 mm band as shown shall be quantified separately and will be paid for as Special Surface Treatment. See Special Provision for additional information.

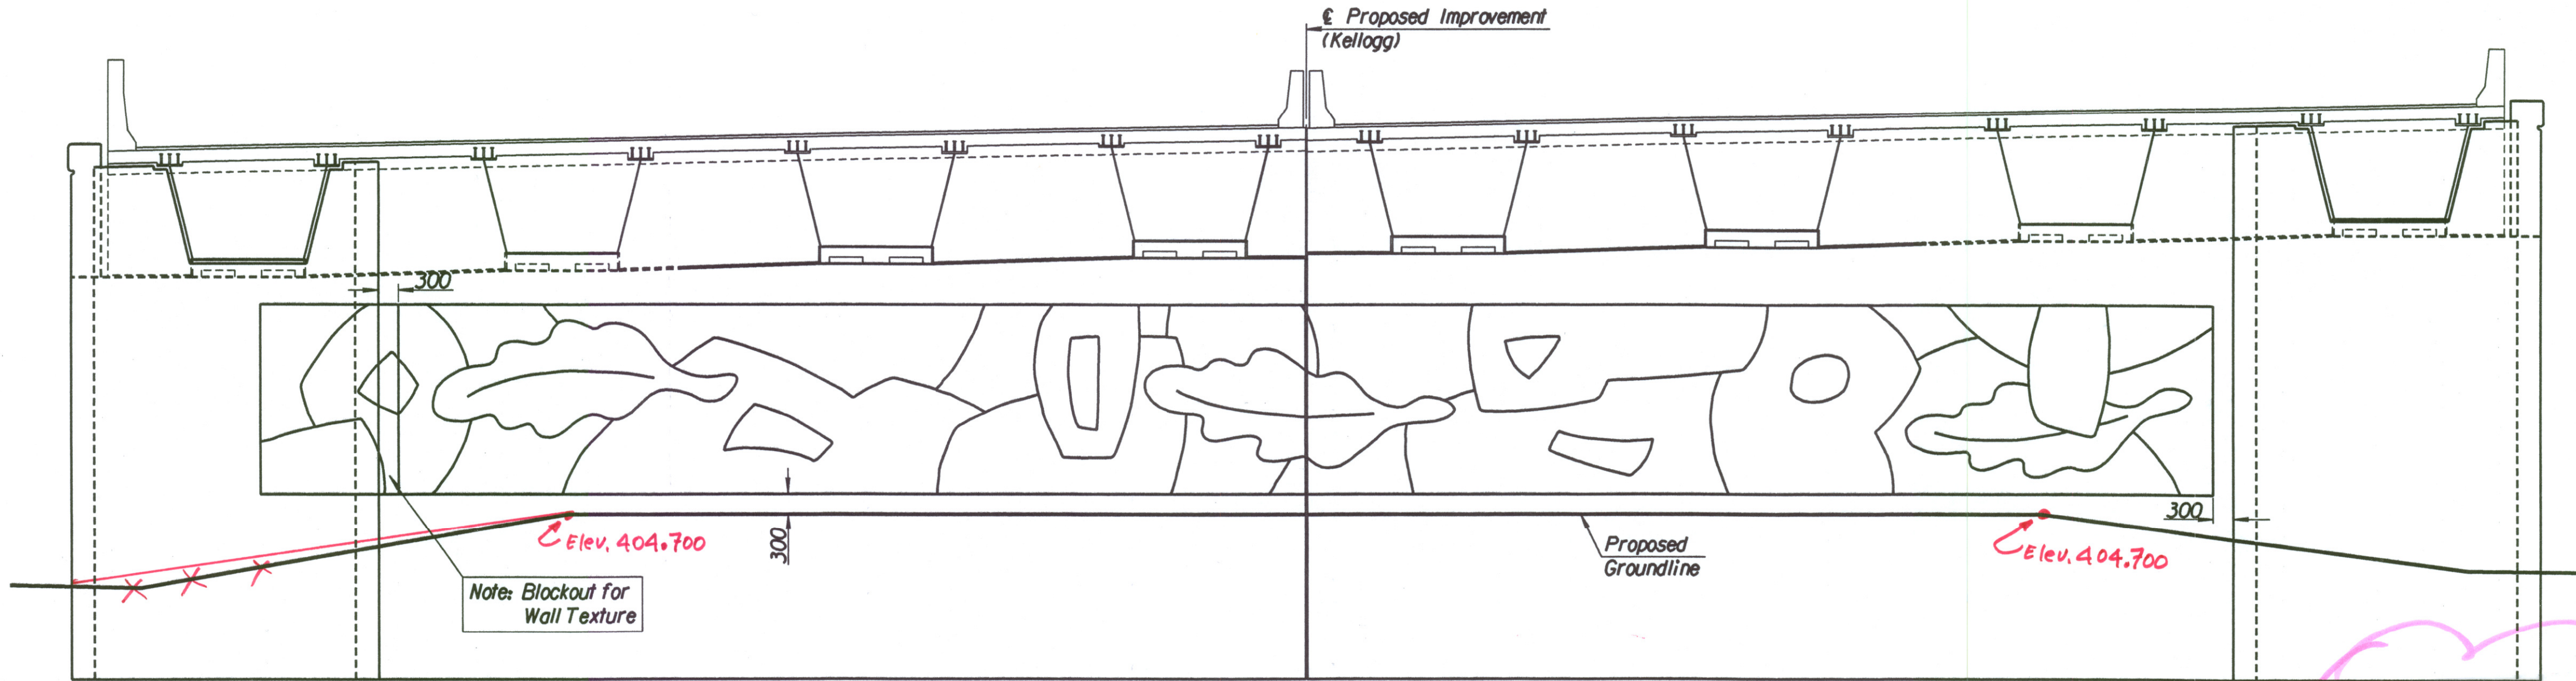

ABUTMENT NO. 2  
Looking Upstation

**ADDENDUM #1:**  
Sheet 451 and Sheet 581 Add the following notes:  
1. The exposed face of the abutment wall outside of the "Special Surface Treatment" area shall be textured with Scott Systems #109 Fractured Fin, or approved equal, with the ribs aligned vertically. The form liner for the "Special Surface Treatment" is the same as Form Linge B on Sheet No. 239 (2.795 m. high) except for the blocked out area shown. The length horizontally of the Special Surface Treatment on the abutment walls is 27.182 meters.

DSNR: RAS OPER: SCALE: BY: drp  
 I:\1997\97362\001\BRIDGE\MAIZERD\ABUTART.DGN 3-14-2002 14:03:30 LAST REV: 4-10-2002

CITY OF WICHITA		By		Date	
BR. NO. 54-87-19.05(489) W.B.				STA. 15+612.397	
BR. NO. 54-87-19.06(491) E.B.				STA. 15+612.397	
<b>ABUTMENT ART</b>					
<b>KELLOGG OVER MAIZE ROAD</b>					
SEDGWICK COUNTY					
<b>Professional Engineering Consultants, P.A.</b> 303 S. TOPEKA • WICHITA, KANSAS 67202 316-262-2691 • FAX 316-262-3003					
Designed by	RAS	Checked by	RAS		
Drawn by	JSB	Date	April, 2002	Job No.	97362