



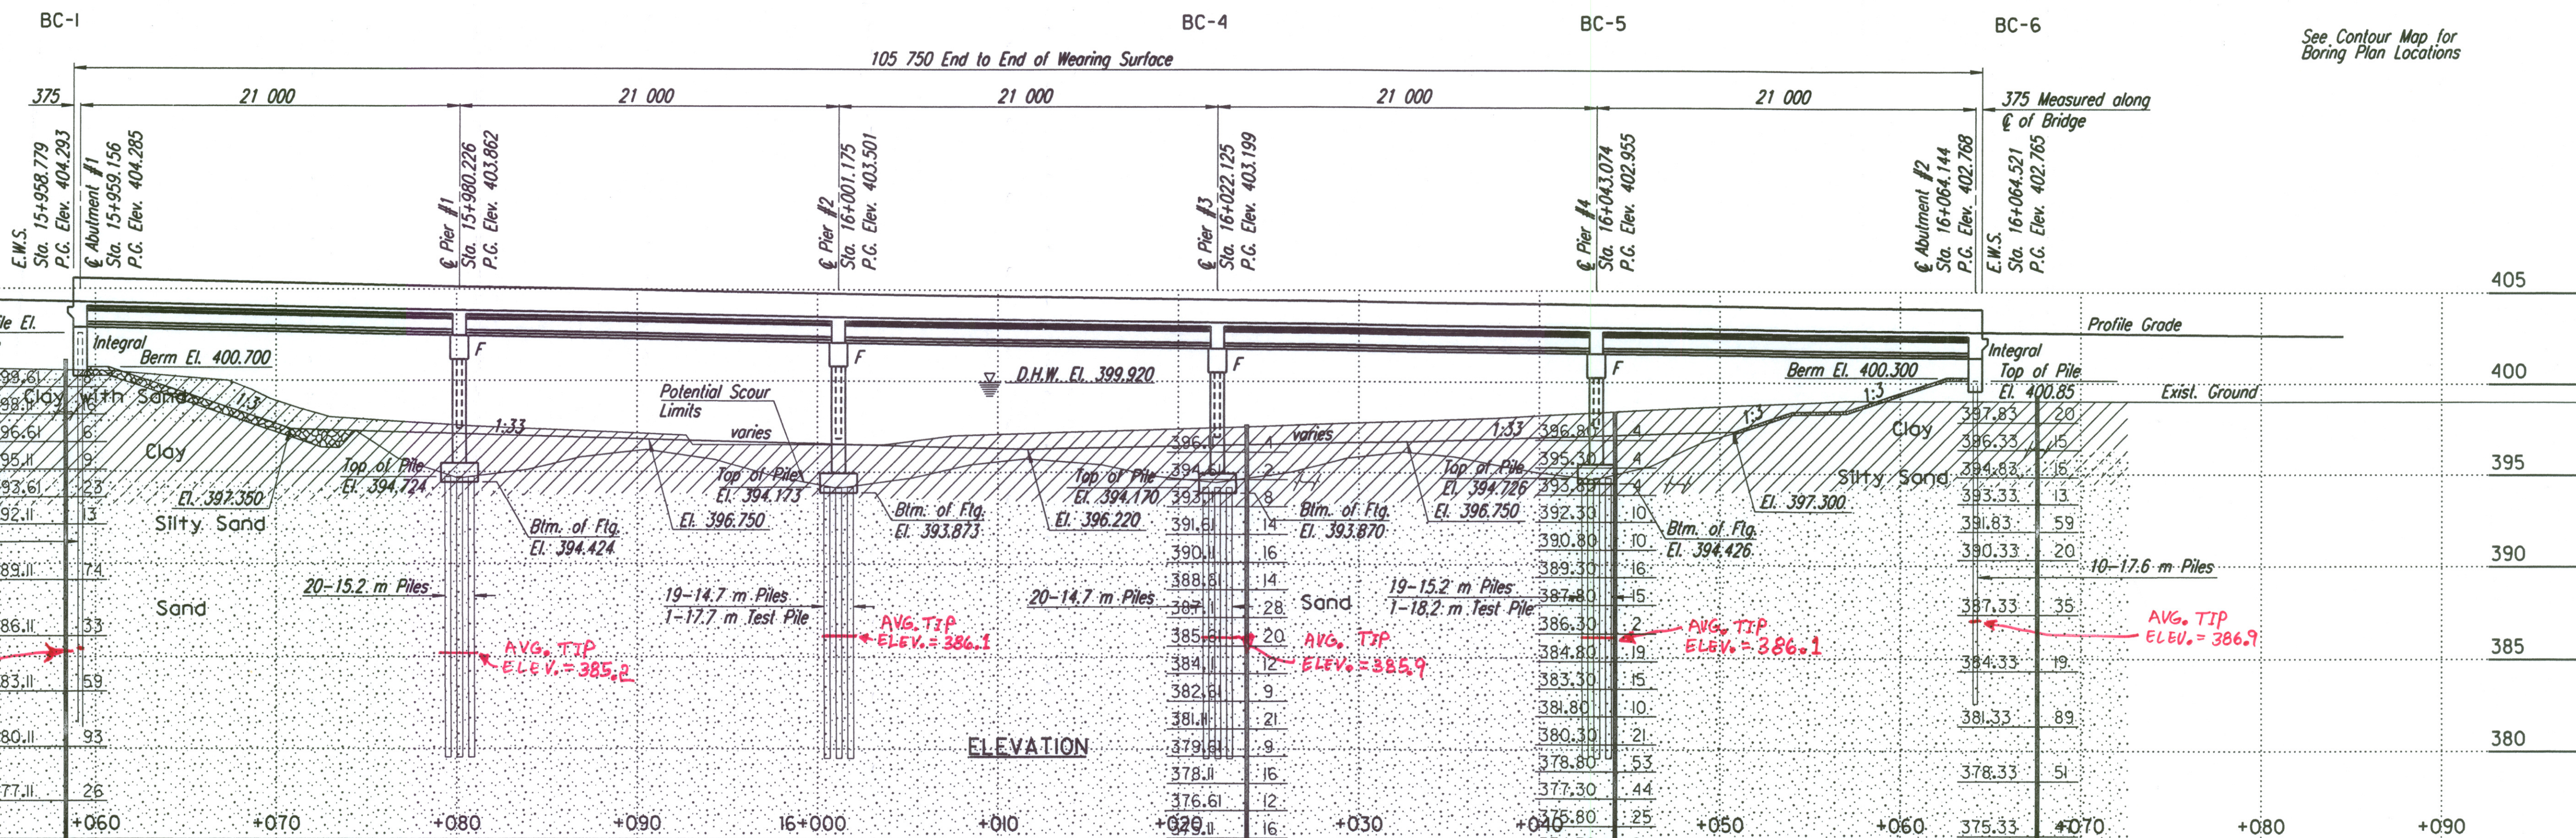

STANDARD GEOLOGIC SYMBOLS

SOUNDINGS

- Core drill
- Power auger
- Hand tools
- Air hammer
- Dutch cone penetrometer
- Unconfined compression
- Standard penetration
- Water level 02/92

GEOLOGIC PROFILE

- UNCONFINED COMPRESSION TEST
- STANDARD PENETRATION TEST
- AIR HAMMER DRIVE TEST
- DUTCH CONE PENETROMETER TEST

NOTE: The soundings shown on these plans are taken from notes obtained in the field and represent the best information available. The logs of these soundings are in the files of Allied Laboratories and are available at their offices at Wichita, Kansas for inspection by interested and qualified bidders.

Revisions		By	Date
CITY OF WICHITA			
BR. NO. 54-87-19.30 (493) E.B.		STA. 16+011.650	
ENGINEERING GEOLOGY			
EAST BOUND KELLOGG (US-54)			
OVER COWSKIN CREEK			
SEDGWICK COUNTY			
Professional Engineering Consultants, P.A.			
303 S. TOPEKA • WICHITA, KANSAS 67202			
316-262-2691 • FAX 316-262-3003			
Designed by	O.O.O.	Checked by	R.A.S.
Drawn by	W.L.L.	Date	April, 2002
		Job No.	97362

SCALE: 1:200

i: 1997/97362/001/bridge/cowskin/MANLINE/EGeology
 drawn by: wll
 plotted by: drp 3-25-2002