



STATE	PROJECT NO.	YEAR	SHEET NO.	TOTAL SHEETS
KANSAS	54-87 K-6657-01	2002	581	1122

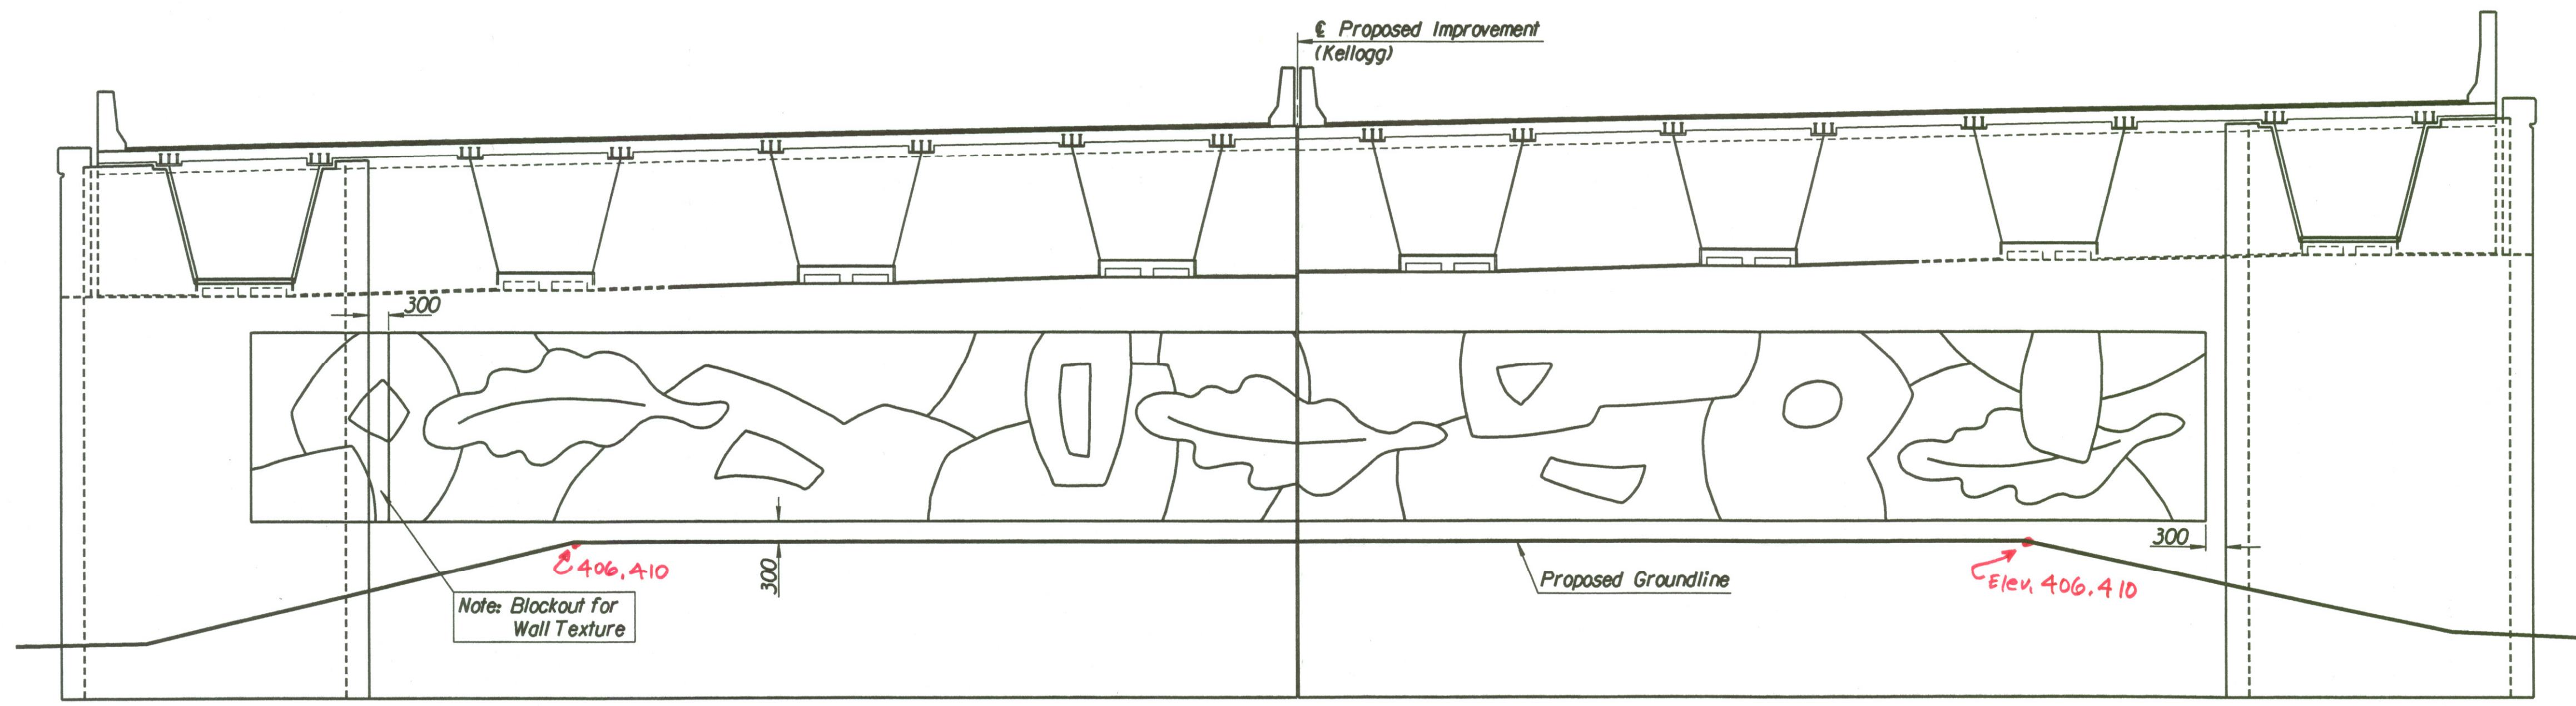

ABUTMENT NO. 1
Looking Backstation

SPECIAL SURFACE TREATMENT: The area on the abutment walls depicting special art texture and delimited by the 300 mm band as shown shall be quantified separately and will be paid for as Special Surface Treatment. See Special Provision for additional information.

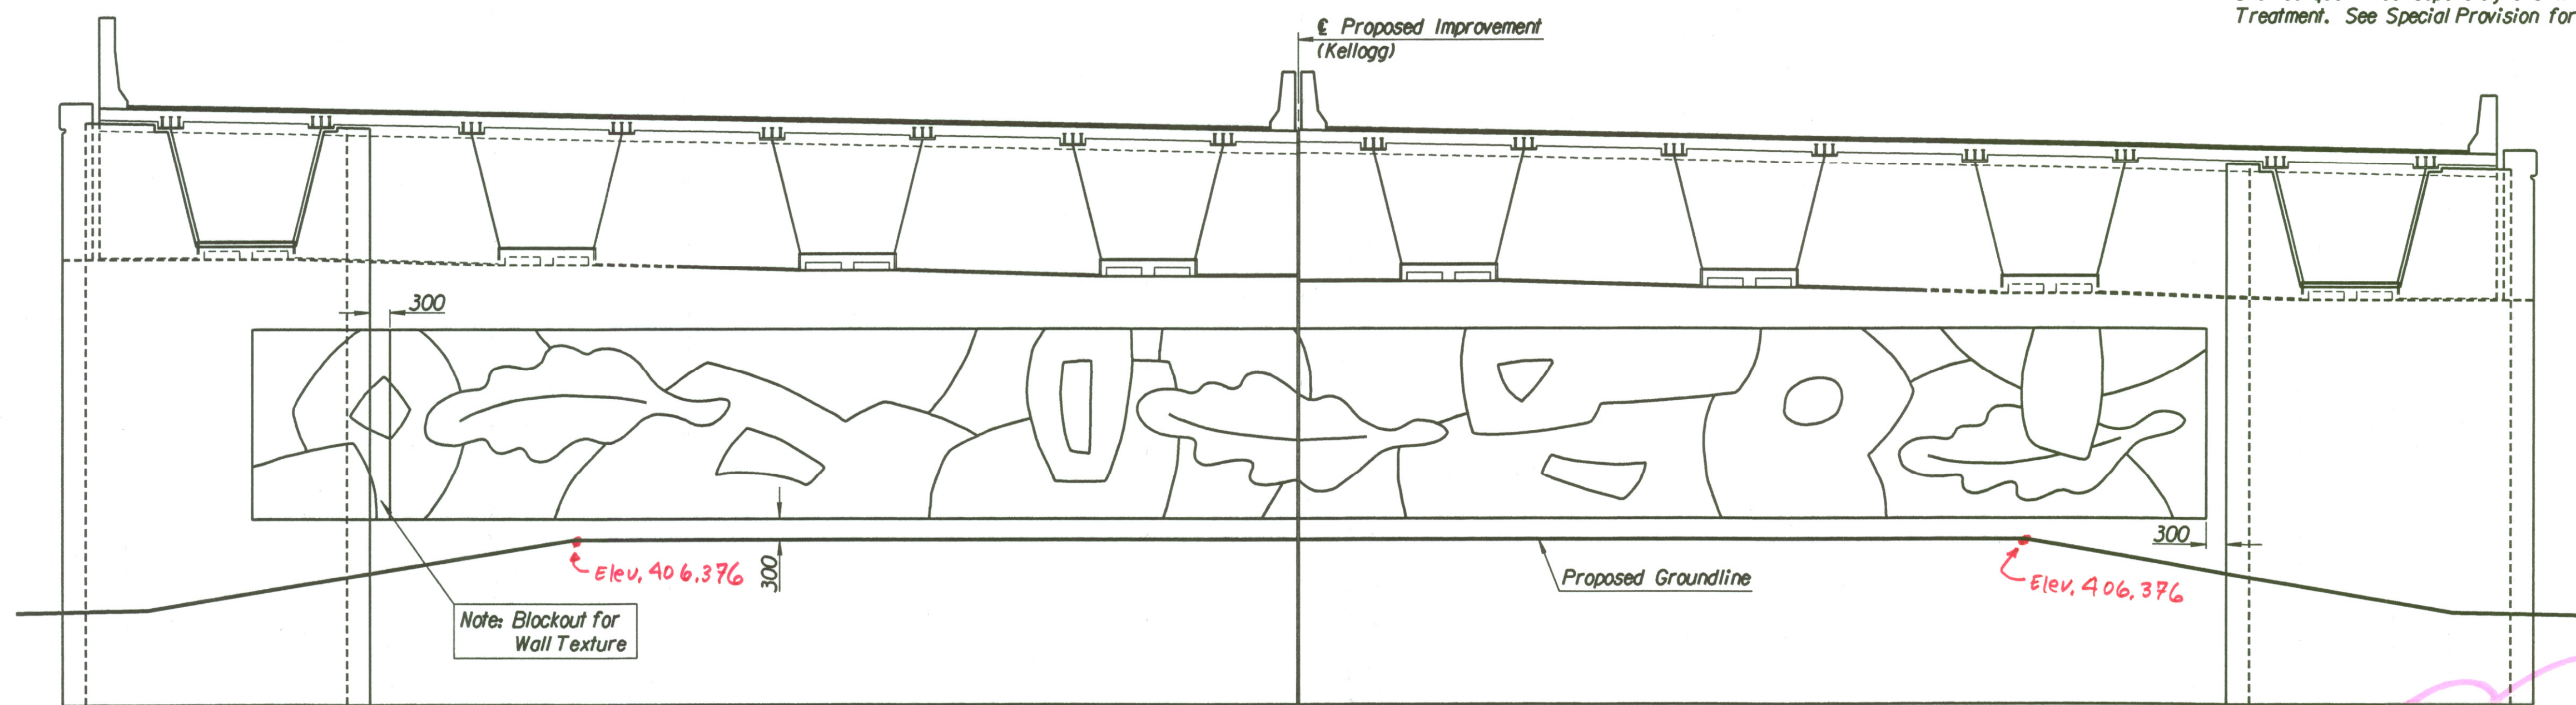

ABUTMENT NO. 2
Looking Upstation

ADDENDUM #1:

- Sheet 451 and Sheet 581 Add the following notes:
- The exposed face of the abutment wall outside of the "Special Surface Treatment" area shall be textured with Scott Systems #109 Fractured Fin, or approved equal, with the ribs aligned vertically. The form liner for the "Special Surface Treatment" is the same as Form Liner B on Sheet No. 239 (2.795 m. high) except for the blocked out area shown. The length horizontally of the Special Surface Treatment on the abutment walls is 27.182 meters.

DSNR: RWA OPER: DRP SCALE: 1:1997/97362/001/BRIDGE/TYLERRD/ABUT ART.DGN 3-14-2002 11:22:19 LAST REV: 4-10-2002 BY: drp

No.	Revisions	By	Date
CITY OF WICHITA			
BR. NO. 54-87-20.13(496) W.B.		STA. 17+332.607	
BR. NO. 54-87-20.12(497) E.B.		STA. 17+332.607	
ABUTMENT ART			
KELLOGG OVER TYLER ROAD			
SEDGWICK COUNTY			
Professional Engineering Consultants, P.A. 303 S. TOPEKA • WICHITA, KANSAS 67202 316-262-2691 • FAX 316-262-3003			
Designed by	RAS	Checked by	RAS
Drawn by	JSB	Date	April, 2002
		Job No.	97362