


FHWA REGION NO.	STATE	PROJECT NO.	YEAR	SHEET NO.	TOTAL SHEETS
7	KANSAS	54-87 K-6657-01	2002	641A	1122

(2ND SET)

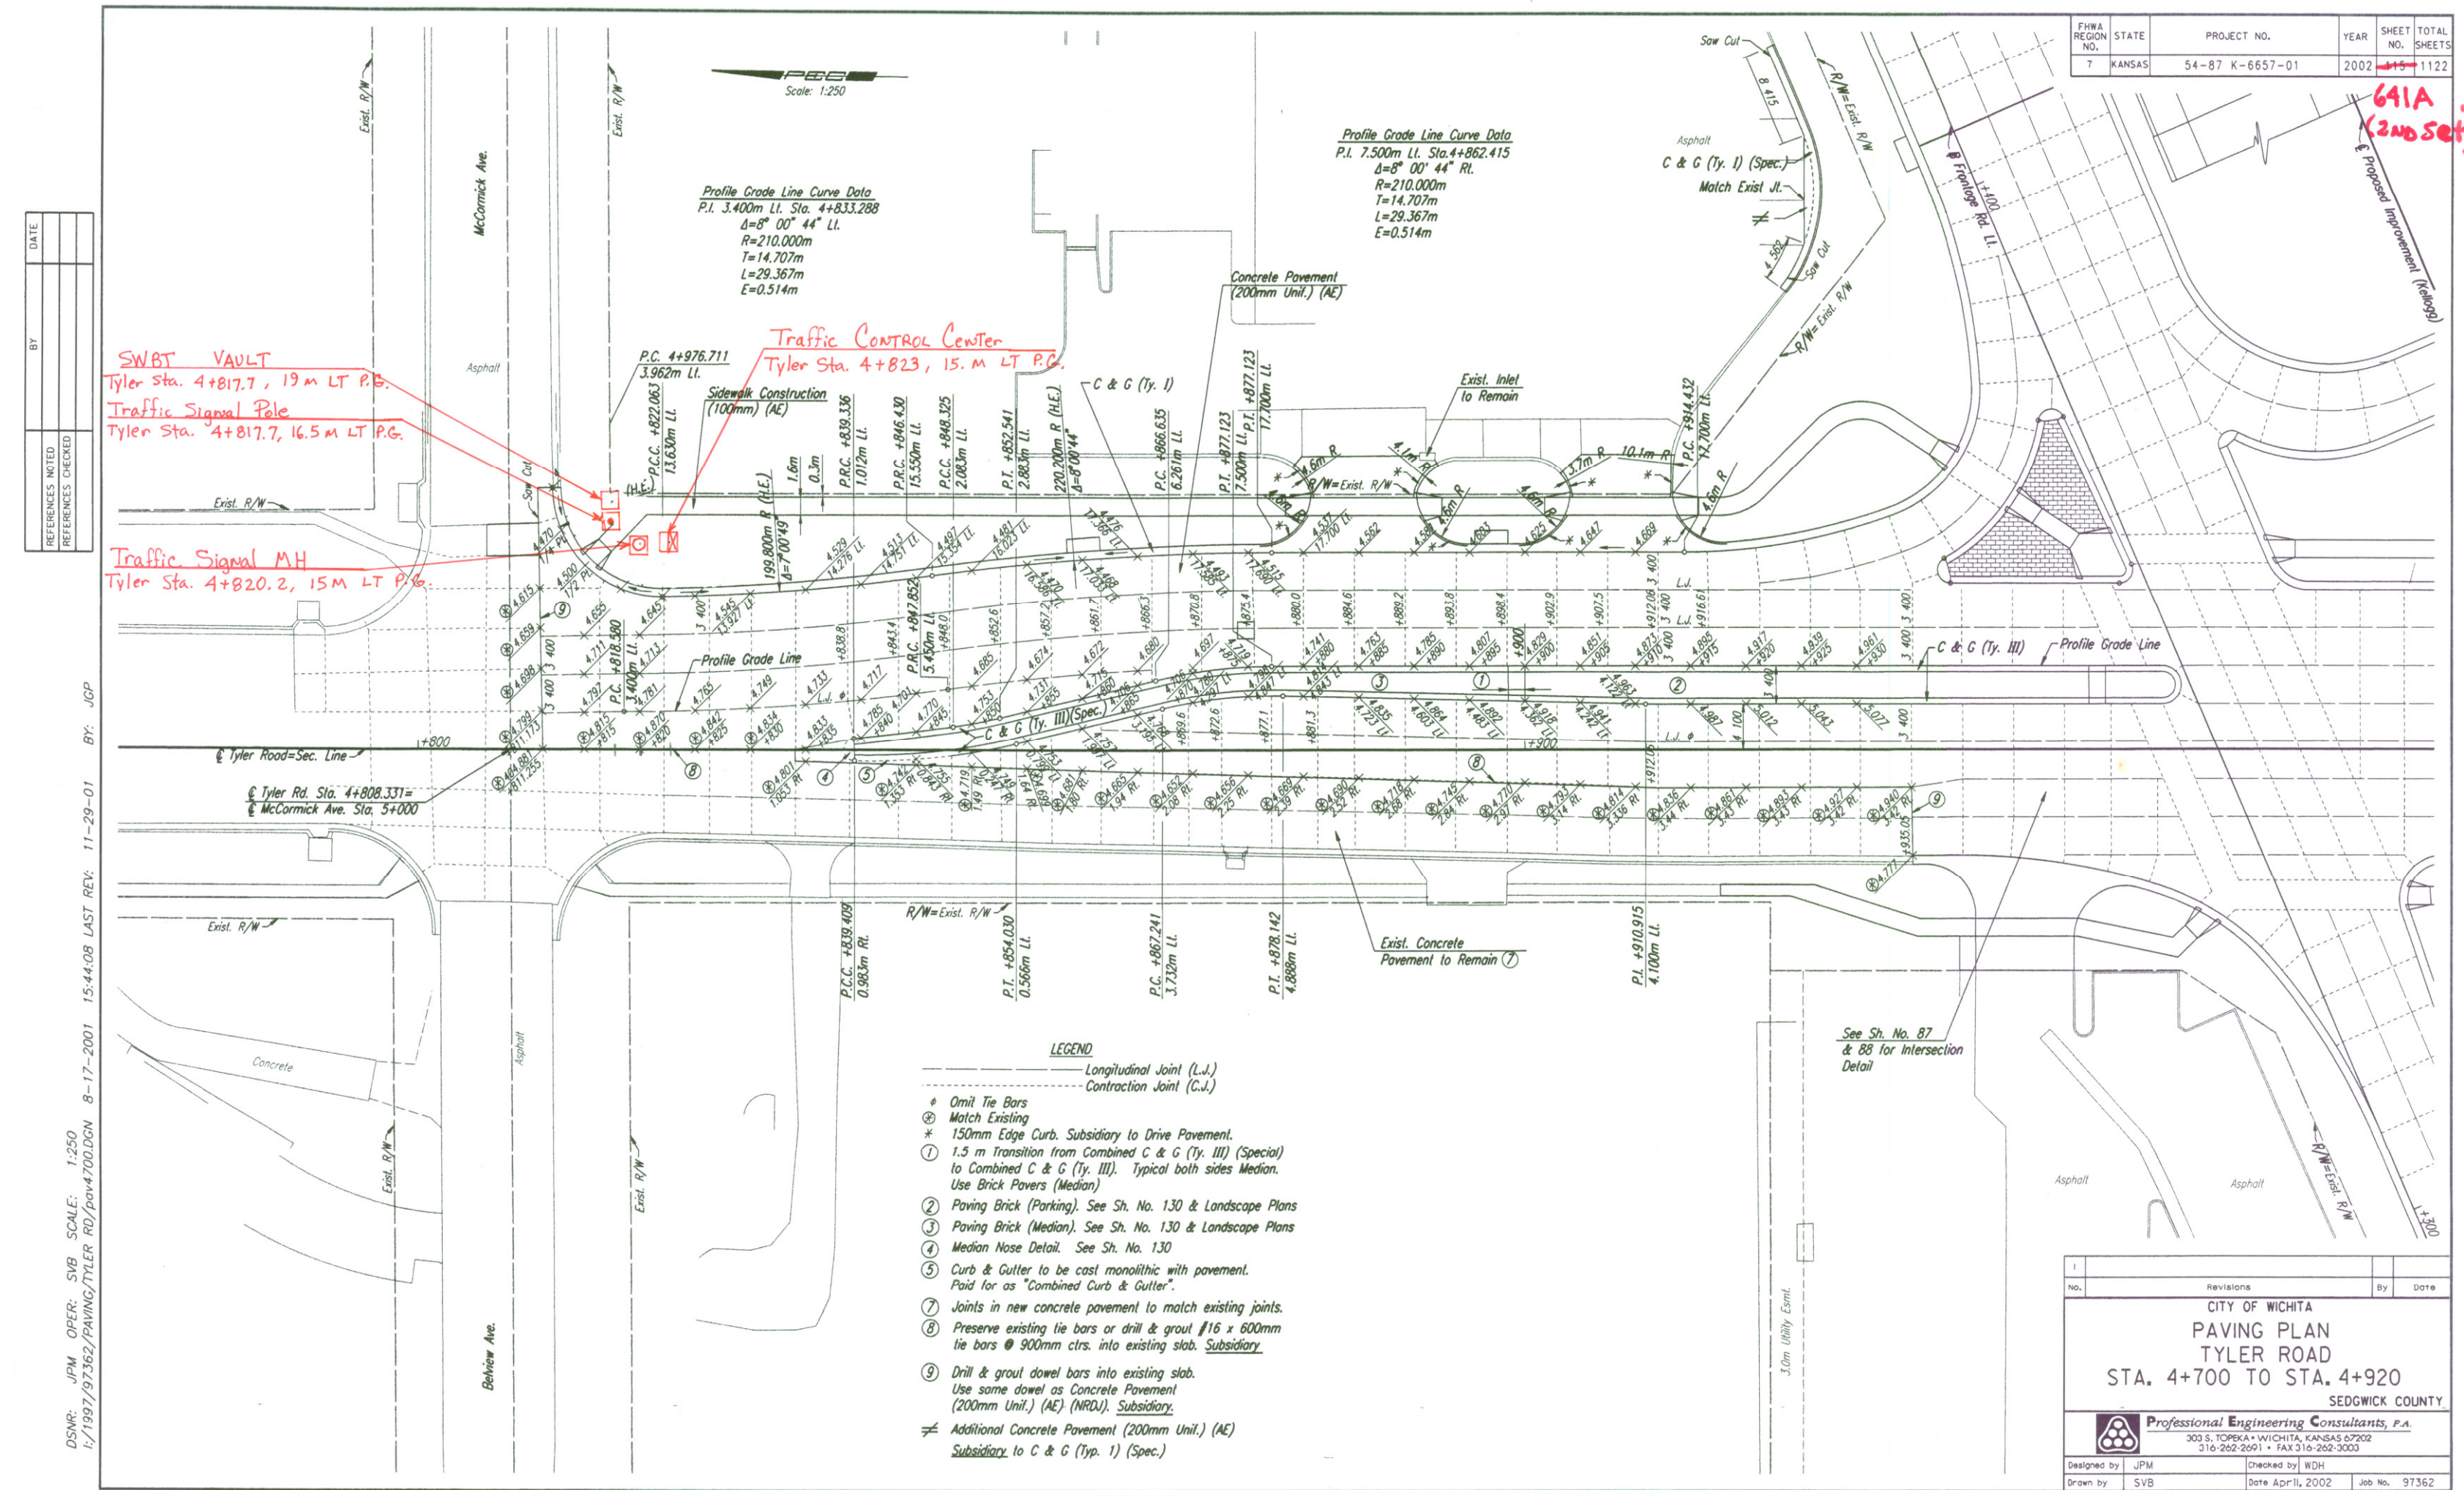

DATE	BY	REVISIONS

DWG: JPM DATE: 1/25/02 SCALE: 1:250
 12/19/01/2/26/2/PAVING/TYLER RD/PAVING/01/01/01 8-17-2001 15:44:08 LAST REV: 11-29-01 BY: JOP

641A
(2ND SET)

NO.	REVISIONS	BY	DATE

CITY OF WICHITA
 PAVING PLAN
 TYLER ROAD
 STA. 4+700 TO STA. 4+920
 SEDGWICK COUNTY

Professional Engineering Consultants, P.C.
 302 S. TOPICKA AVENUE, WICHITA, KS 67202
 316-262-3001 • FAX 316-262-3003

Designed by: JPM
 Drawn by: JVB
 Checked by: WCH
 Date: April 9, 2002 Job No.: 97362