


FHWA REGION NO.	STATE	PROJECT NO.	YEAR	SHEET NO.	TOTAL SHEETS
7	KANSAS	54 - 87 K - 6657 - 01	2002	646B	1122

BRIDGE ELECTRICAL ROOM LAYOUT @ TYLER ROAD

WEST KELLOGG FREEWAY - MAIZE AND TYLER ROAD INTERCHANGES
 CITY OF WICHITA PROJECT NO: 472 - 83533
 K.D.O.T. PROJECT NO: 54 - 87 K 6657 - 01

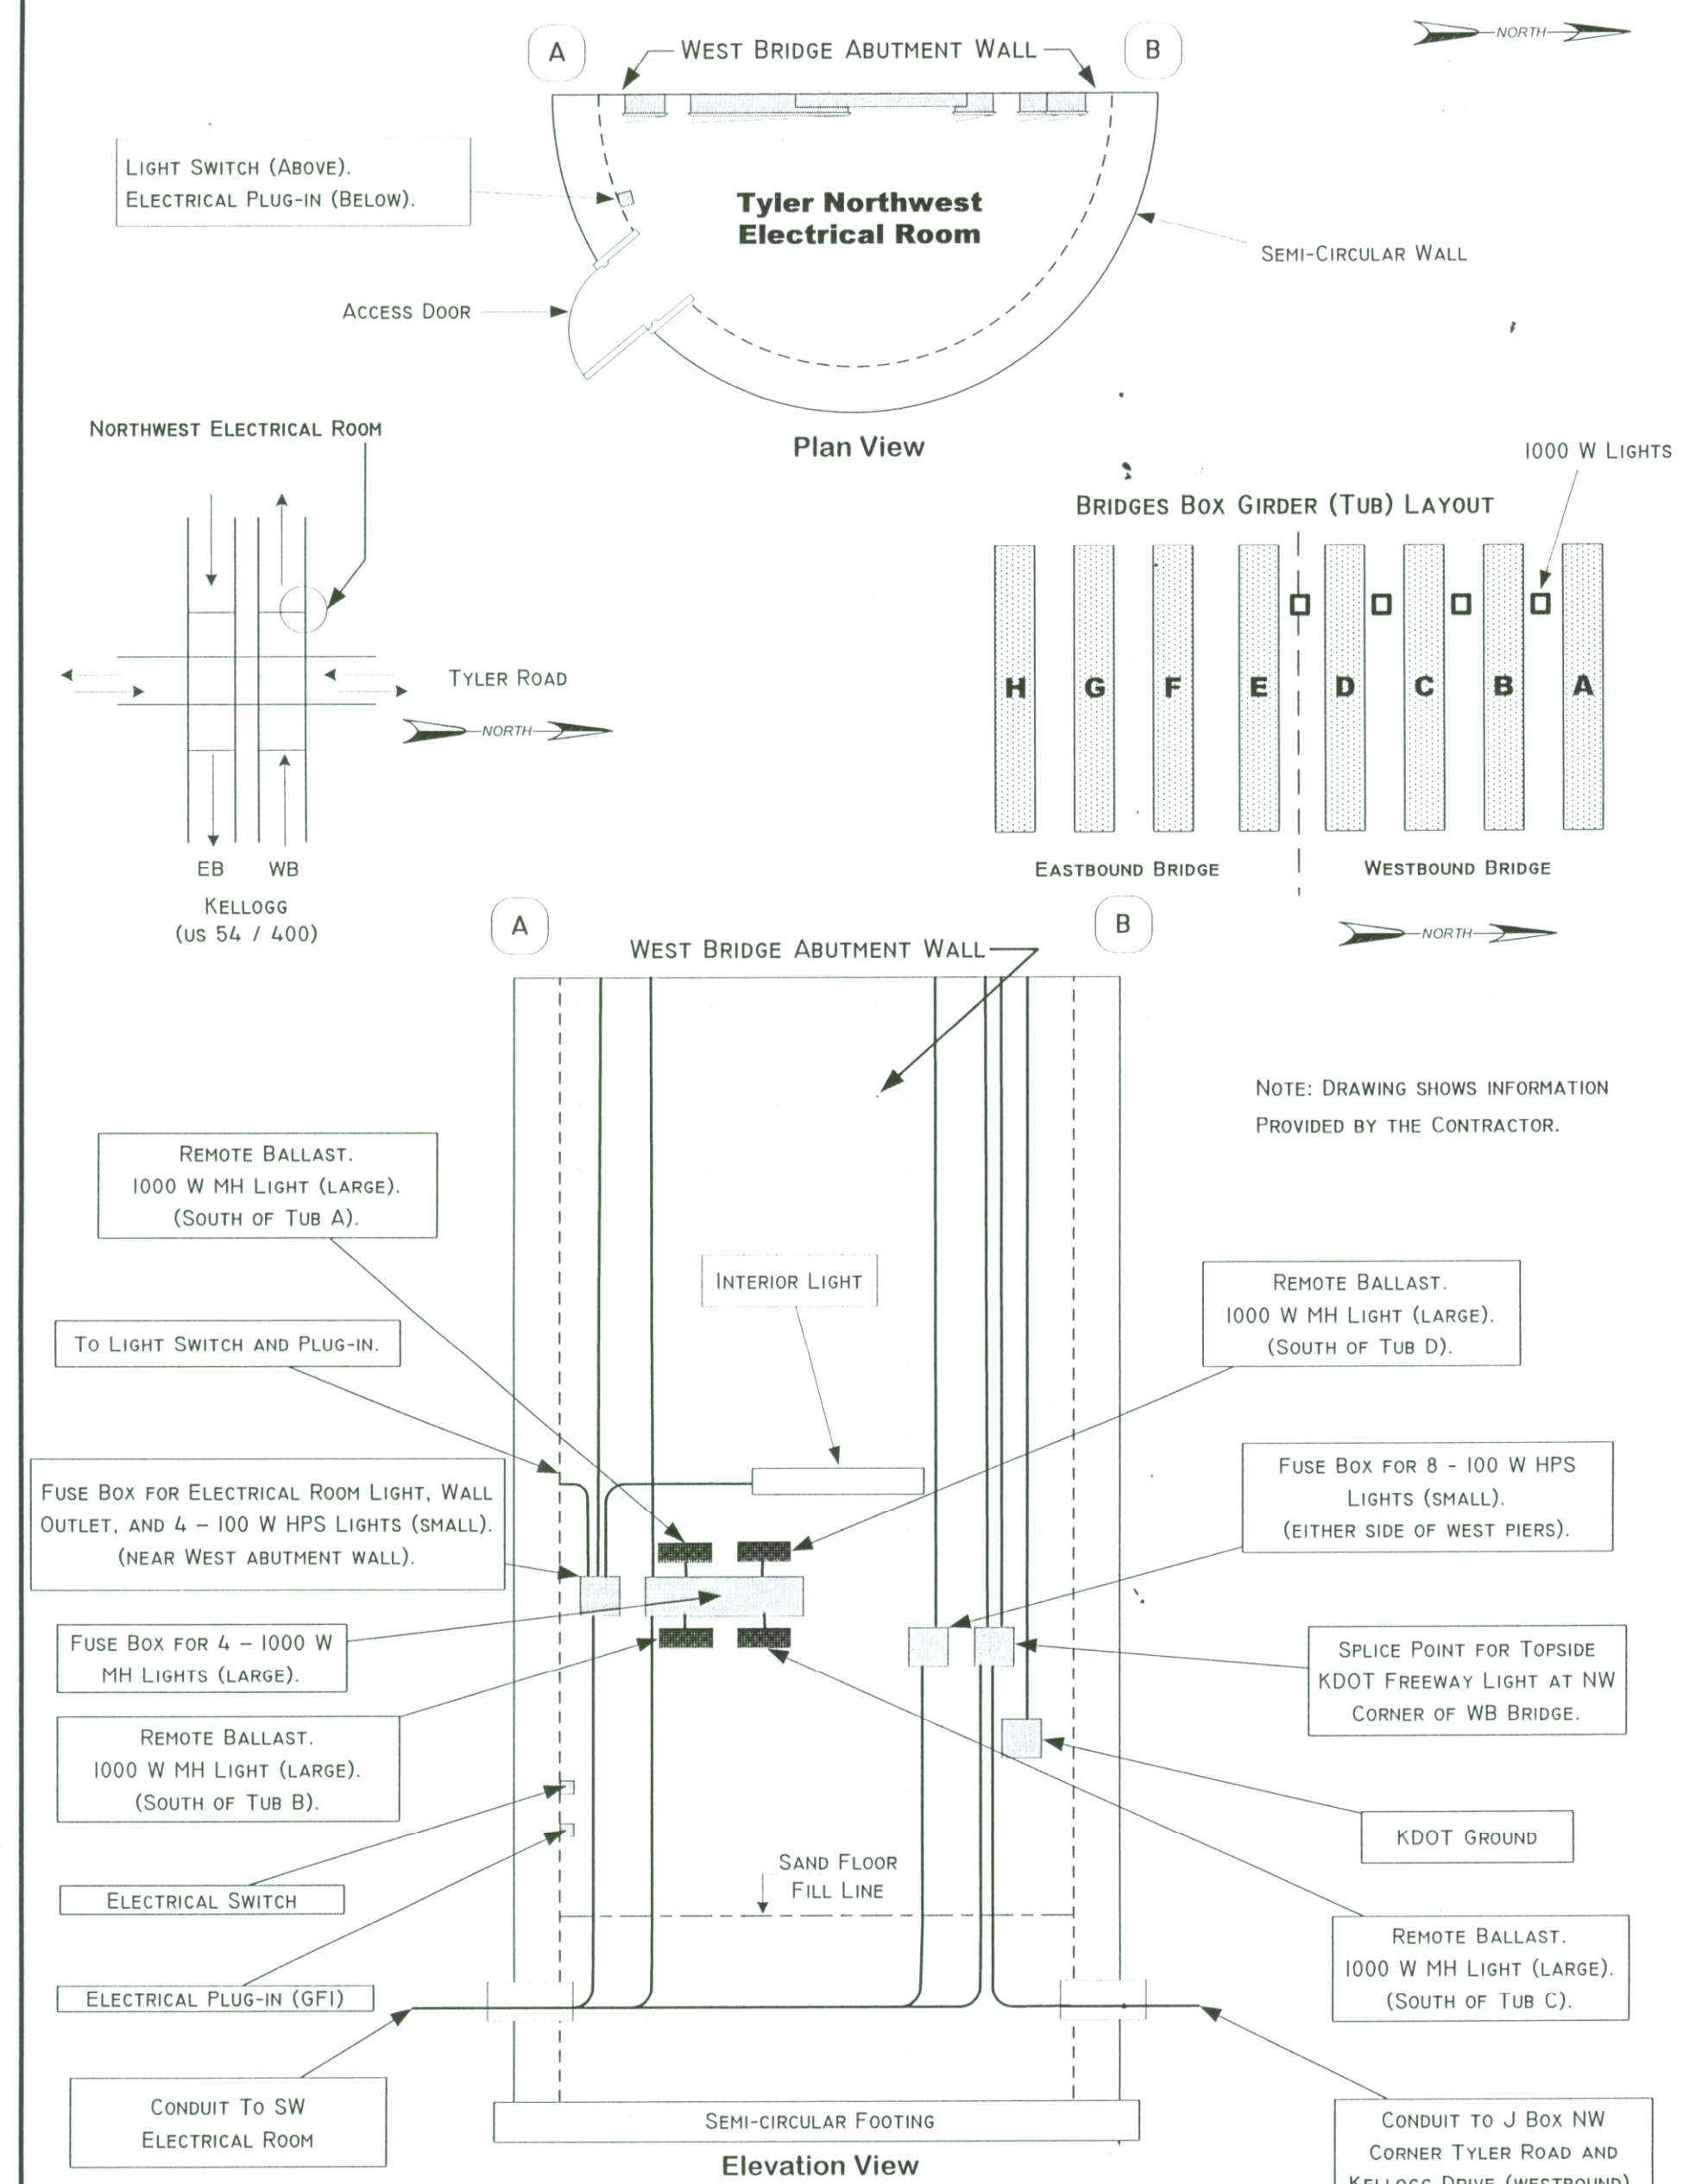


NOTE: 1000 W MH AND 100 W HPS LIGHTS ARE "UNDER BRIDGE LIGHTS" BELOW WEST HALF OF BRIDGE No. 54 - 87 - 20.13 (496) WB KELLOGG.

Professional Engineering Consultants, P.A.
 303 S. TOPEKA - WICHITA, KANSAS 67202 - 316-262-2691 - FAX 316-262-3003
 www.pect.com - designers@pect.com

SHEET 1 OF 4 PREPARED: SEPTEMBER 2005

BRIDGE ELECTRICAL ROOM LAYOUT @ TYLER ROAD

WEST KELLOGG FREEWAY - MAIZE AND TYLER ROAD INTERCHANGES
 CITY OF WICHITA PROJECT NO: 472 - 83533
 K.D.O.T. PROJECT NO: 54 - 87 K 6657 - 01

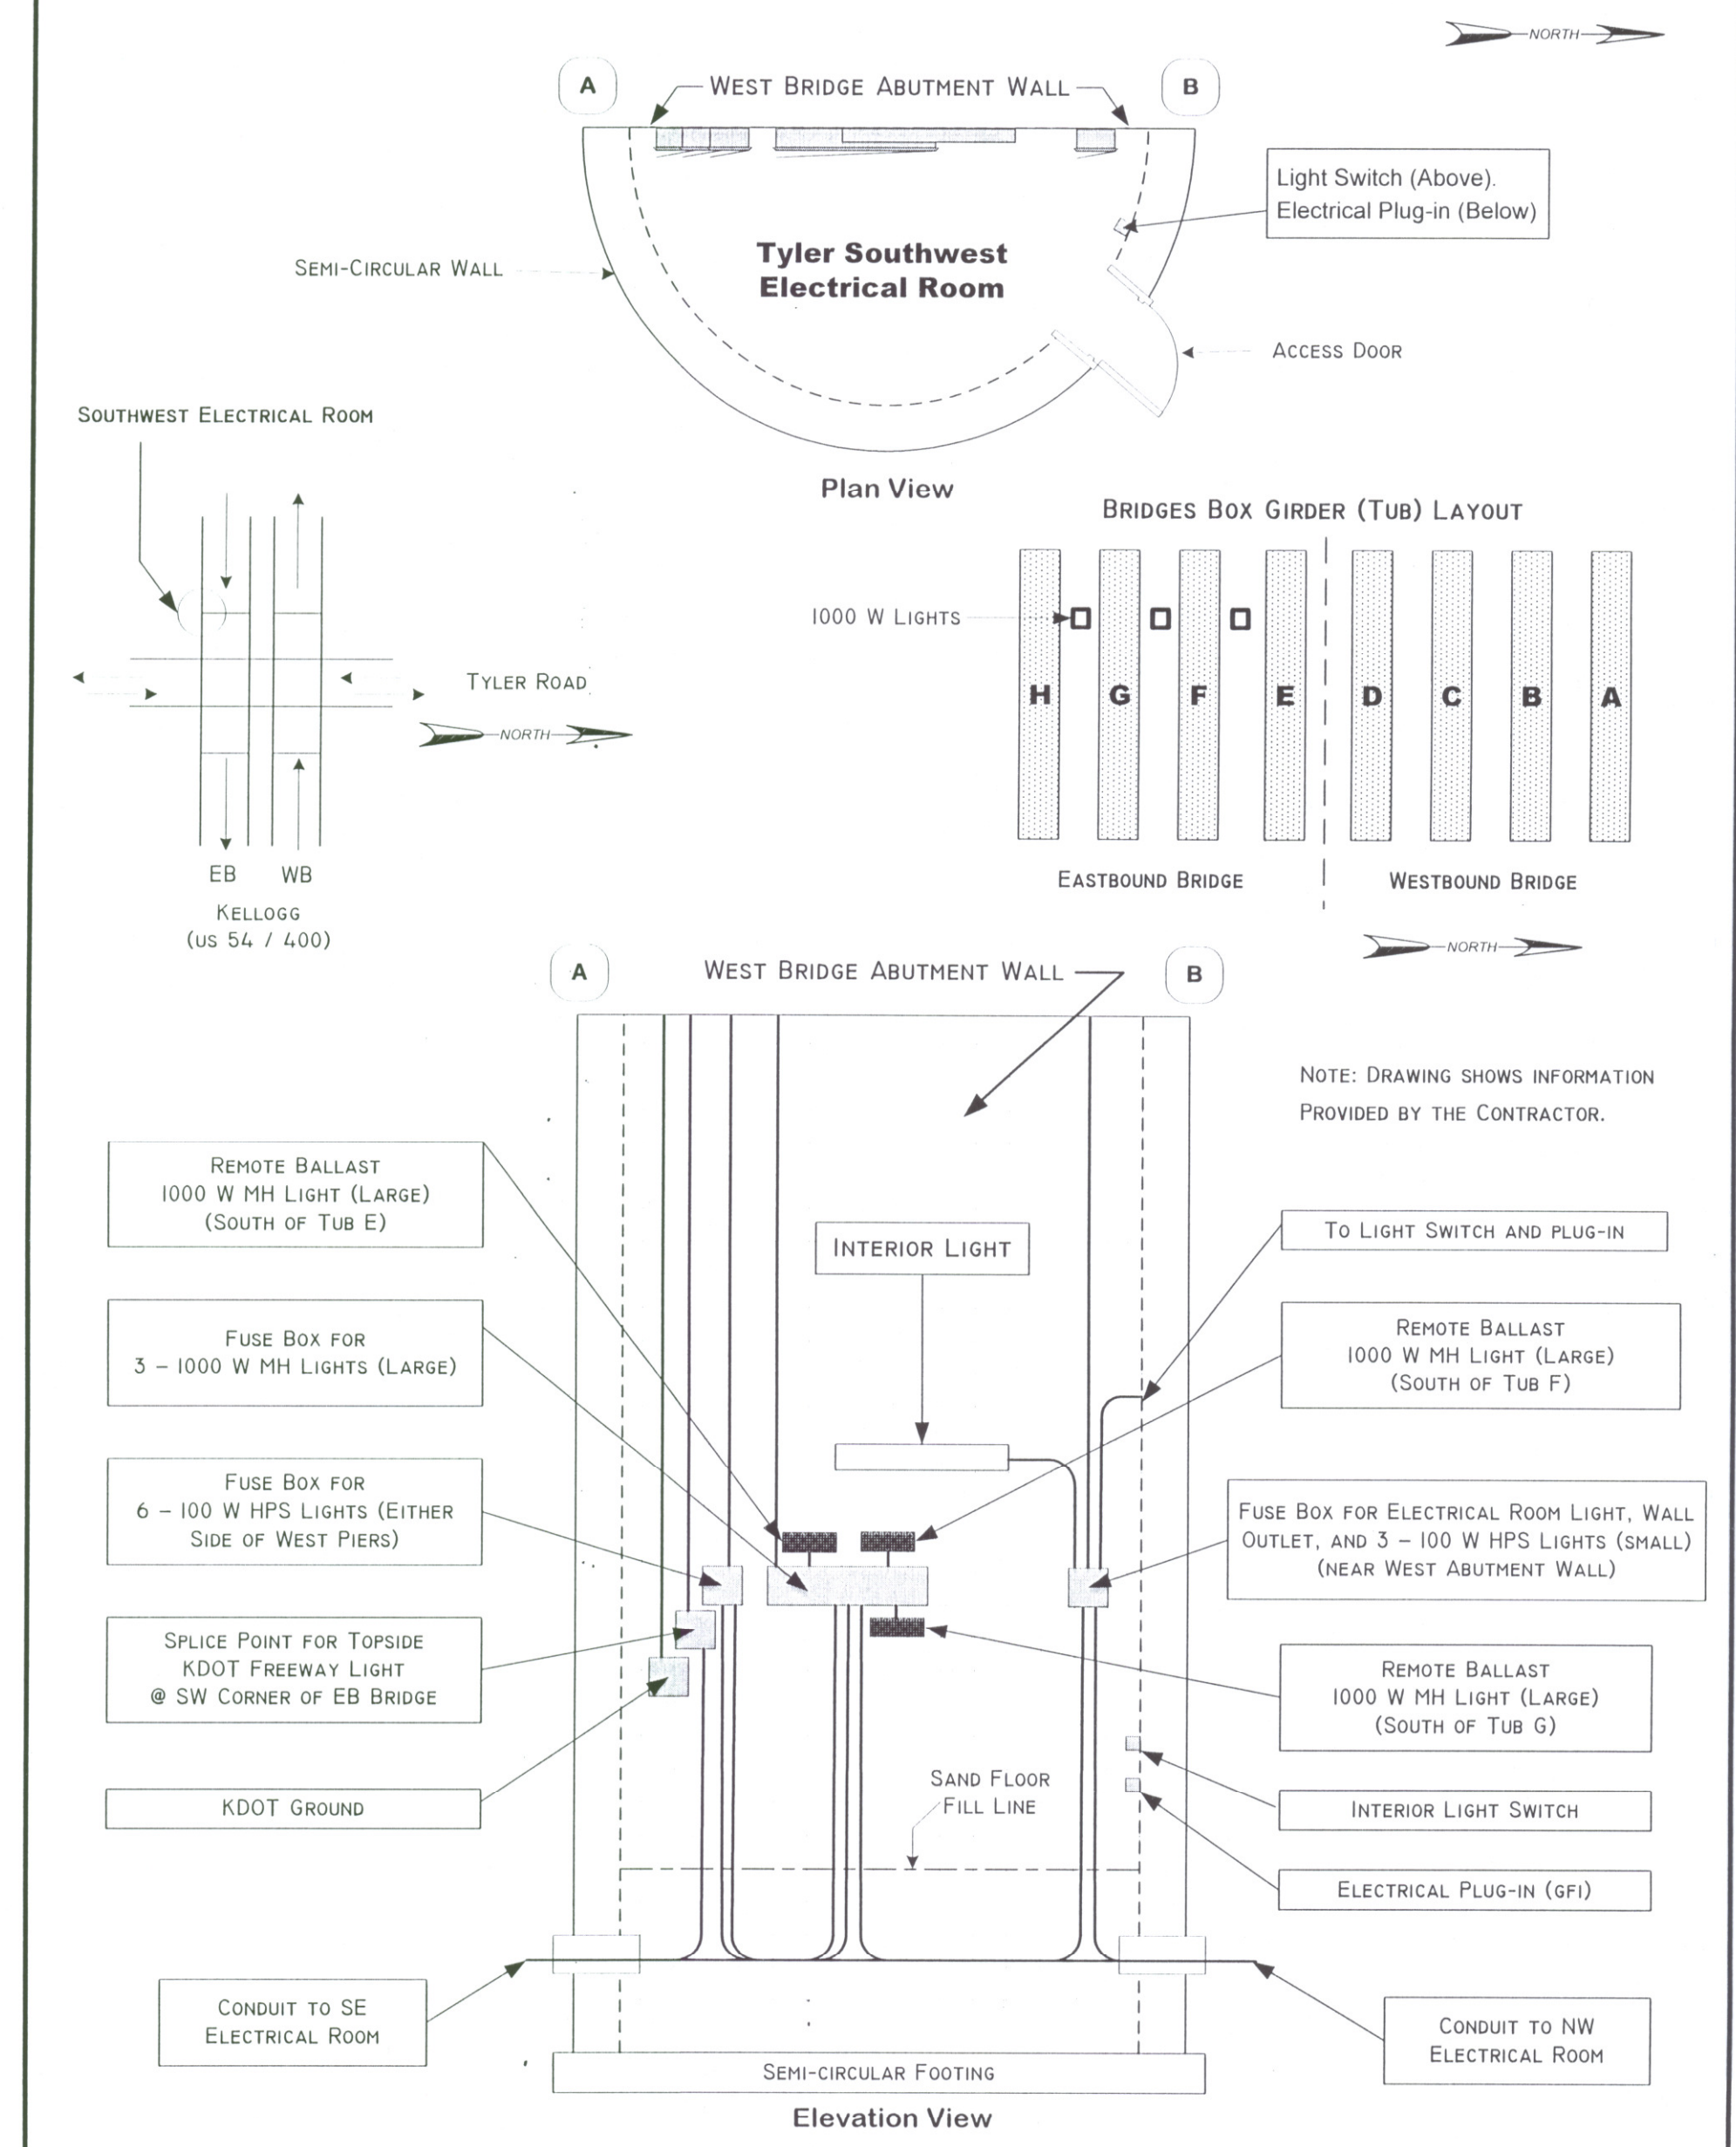

NOTE: 1000 W MH AND 100 W HPS LIGHTS ARE "UNDER BRIDGE LIGHTS" BELOW WEST HALF OF BRIDGE No. 54 - 87 - 20.12 (497) WB KELLOGG.

Professional Engineering Consultants, P.A.
 303 S. TOPEKA - WICHITA, KANSAS 67202 - 316-262-2691 - FAX 316-262-3003
 www.pect.com - designers@pect.com

SHEET 2 OF 4 PREPARED: SEPTEMBER 2005