
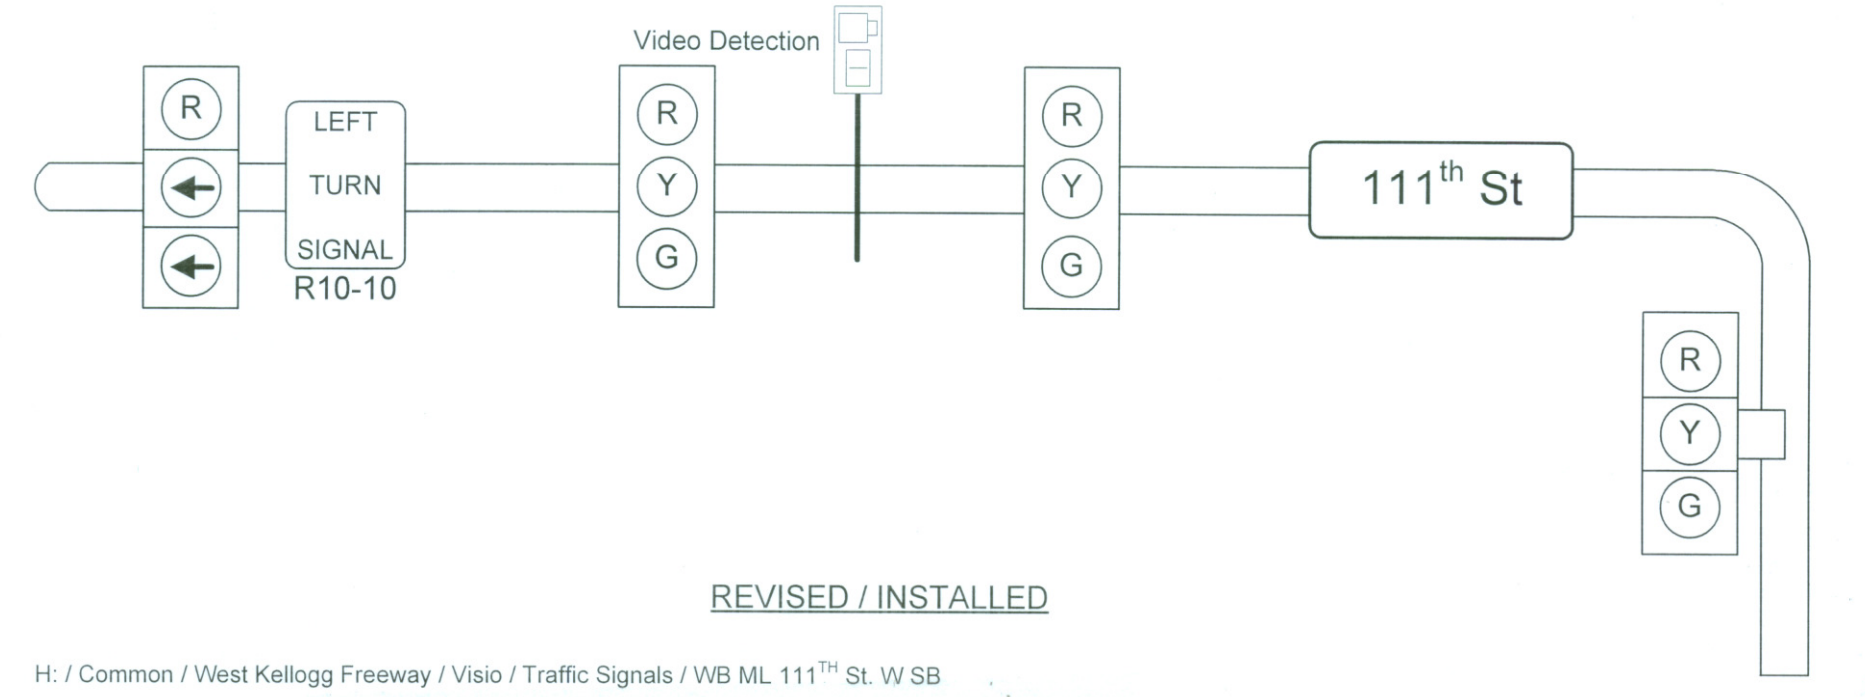


FHWA REGION NO.	STATE	PROJECT NO.	YEAR	SHEET NO.	TOTAL SHEETS
7	KANSAS	54 - 87 K - 6657 - 01	2002	655A	1122

West Kellogg Freeway – Maize and Tyler Road Interchanges

City of Wichita Project Number: 472 - 83533




WK

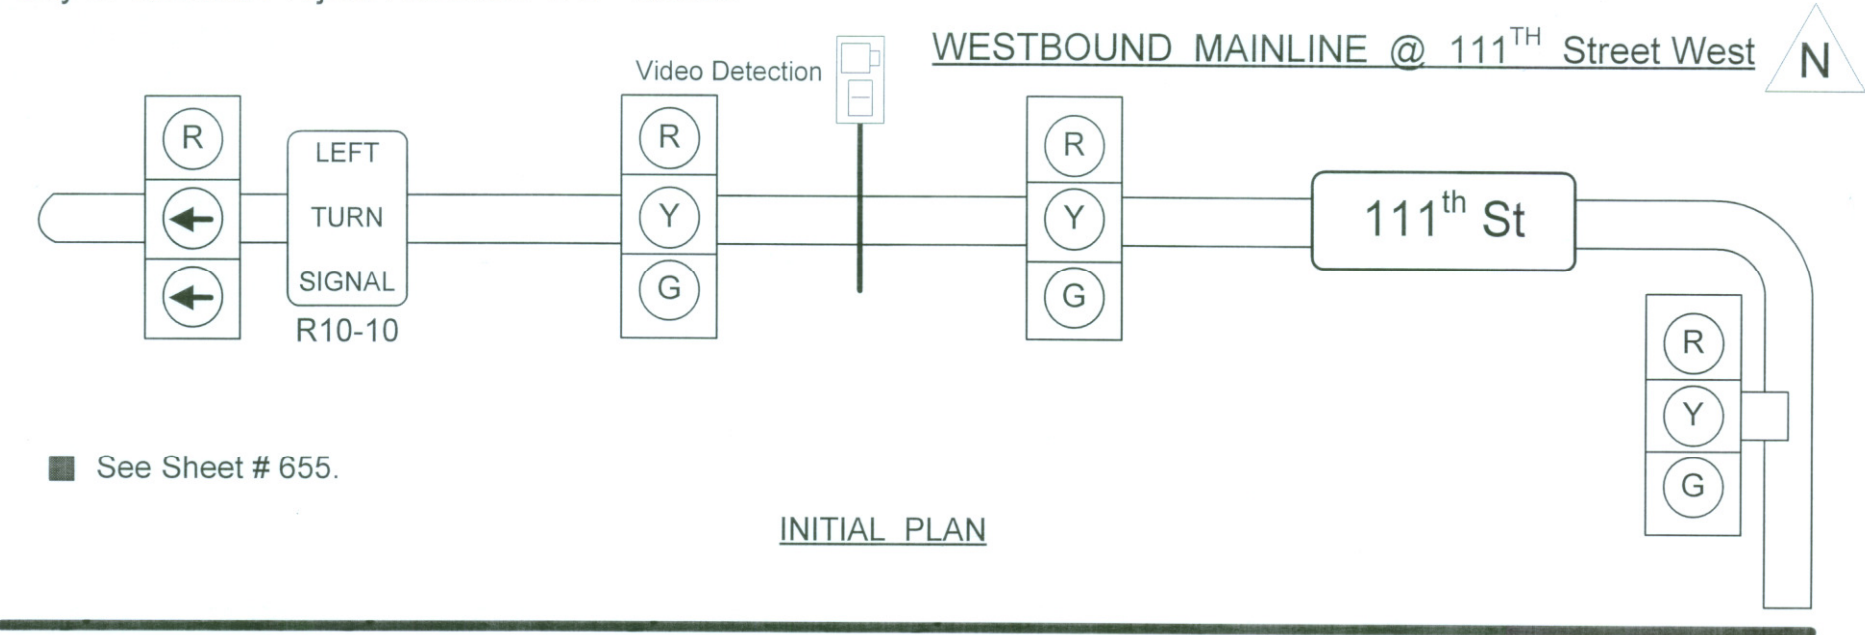

West Kellogg Freeway – Maize and Tyler Road Interchanges

City of Wichita Project Number: 472 - 83533



WK

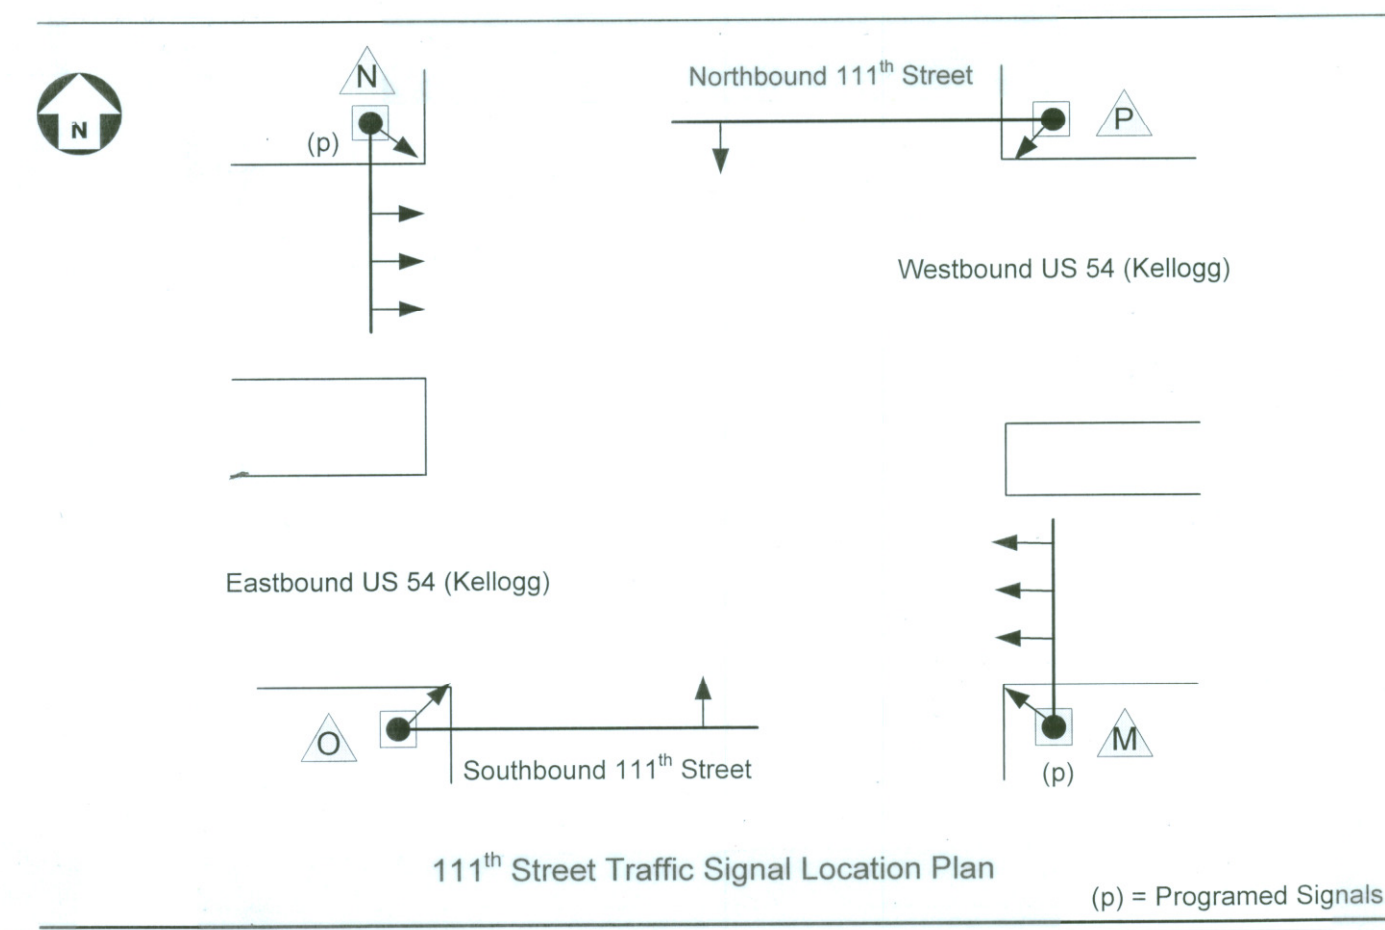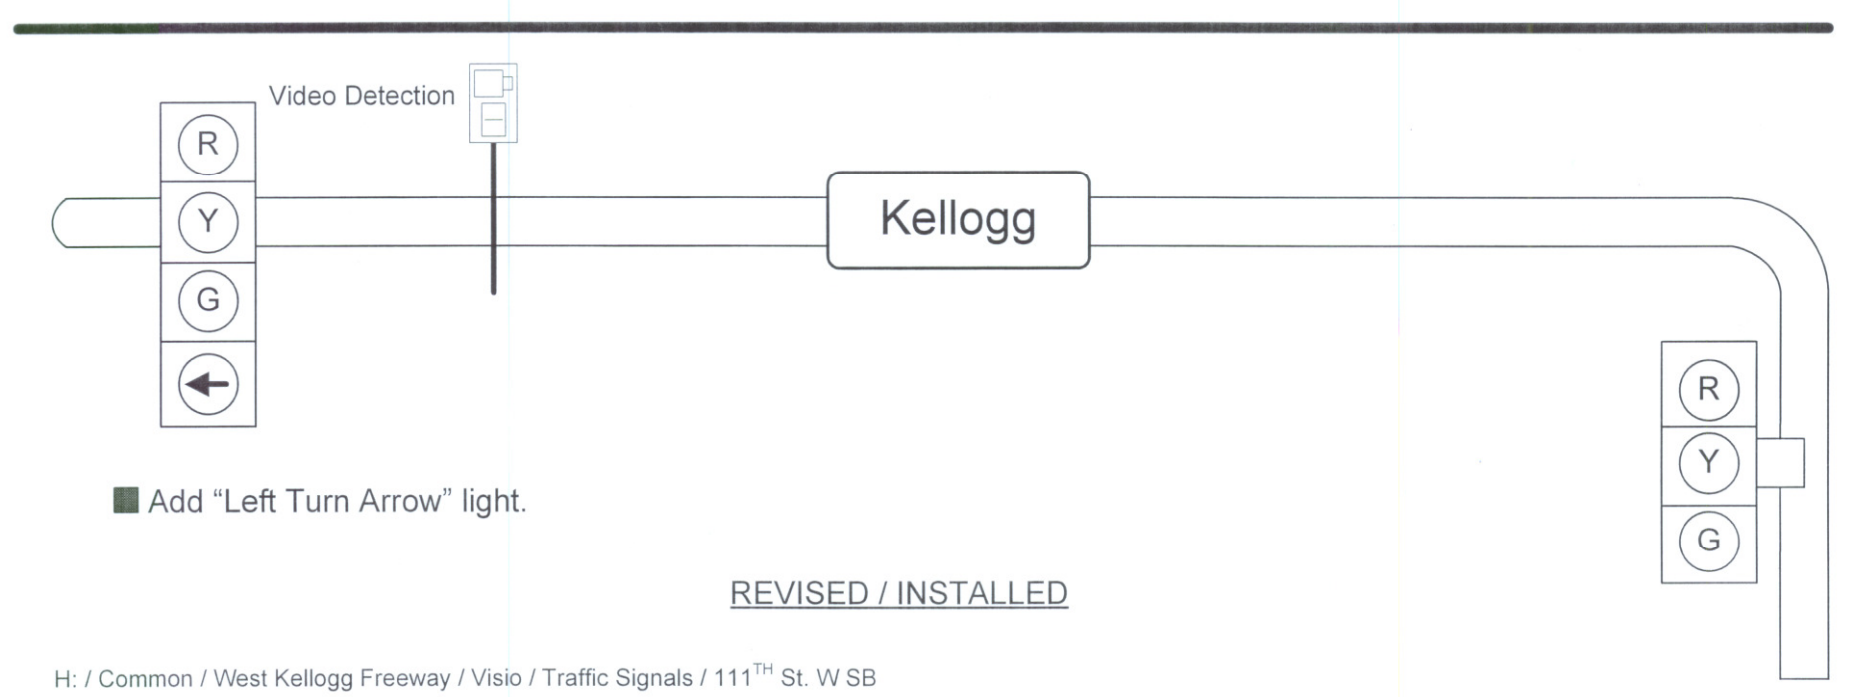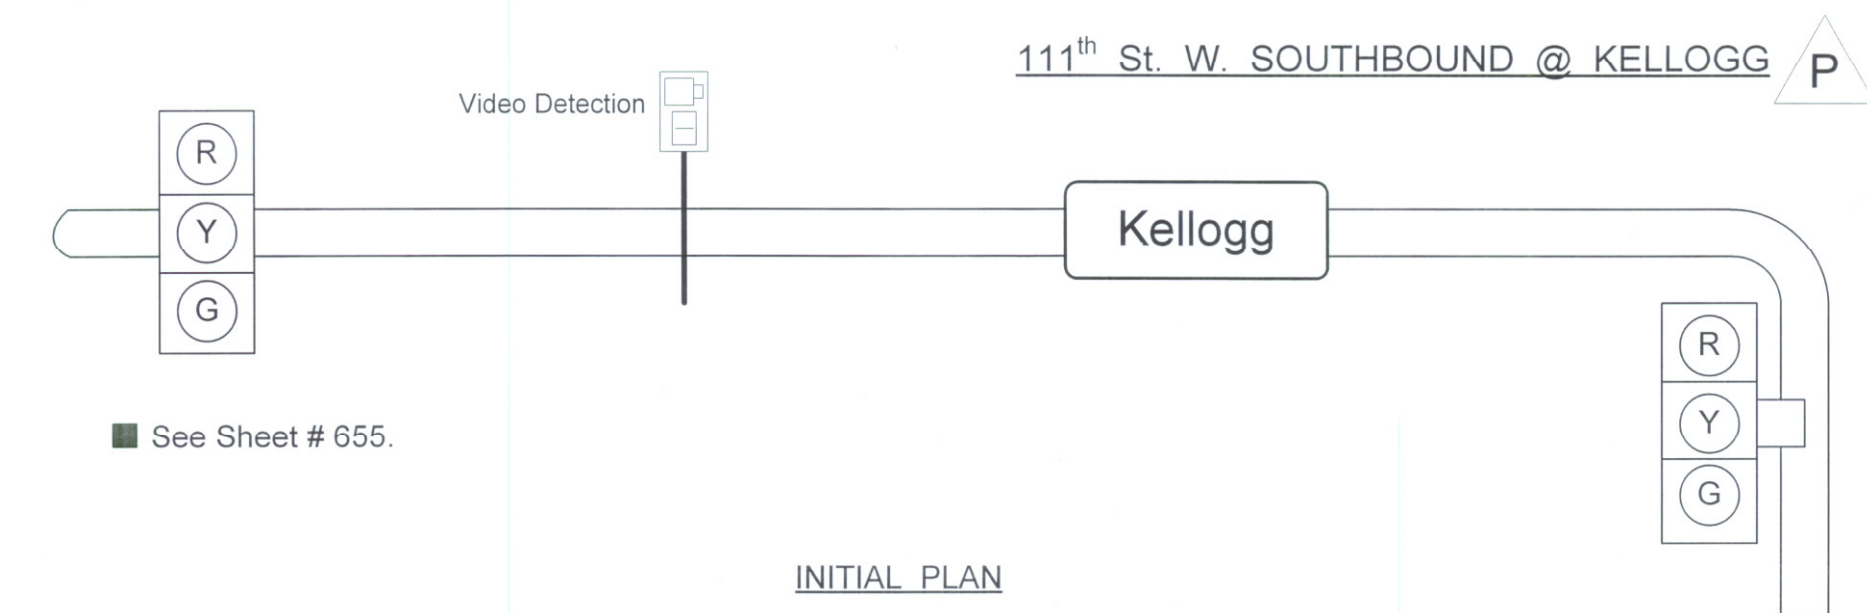

West Kellogg Freeway – Maize and Tyler Road Interchanges

City of Wichita Project Number: 472 - 83533

WK

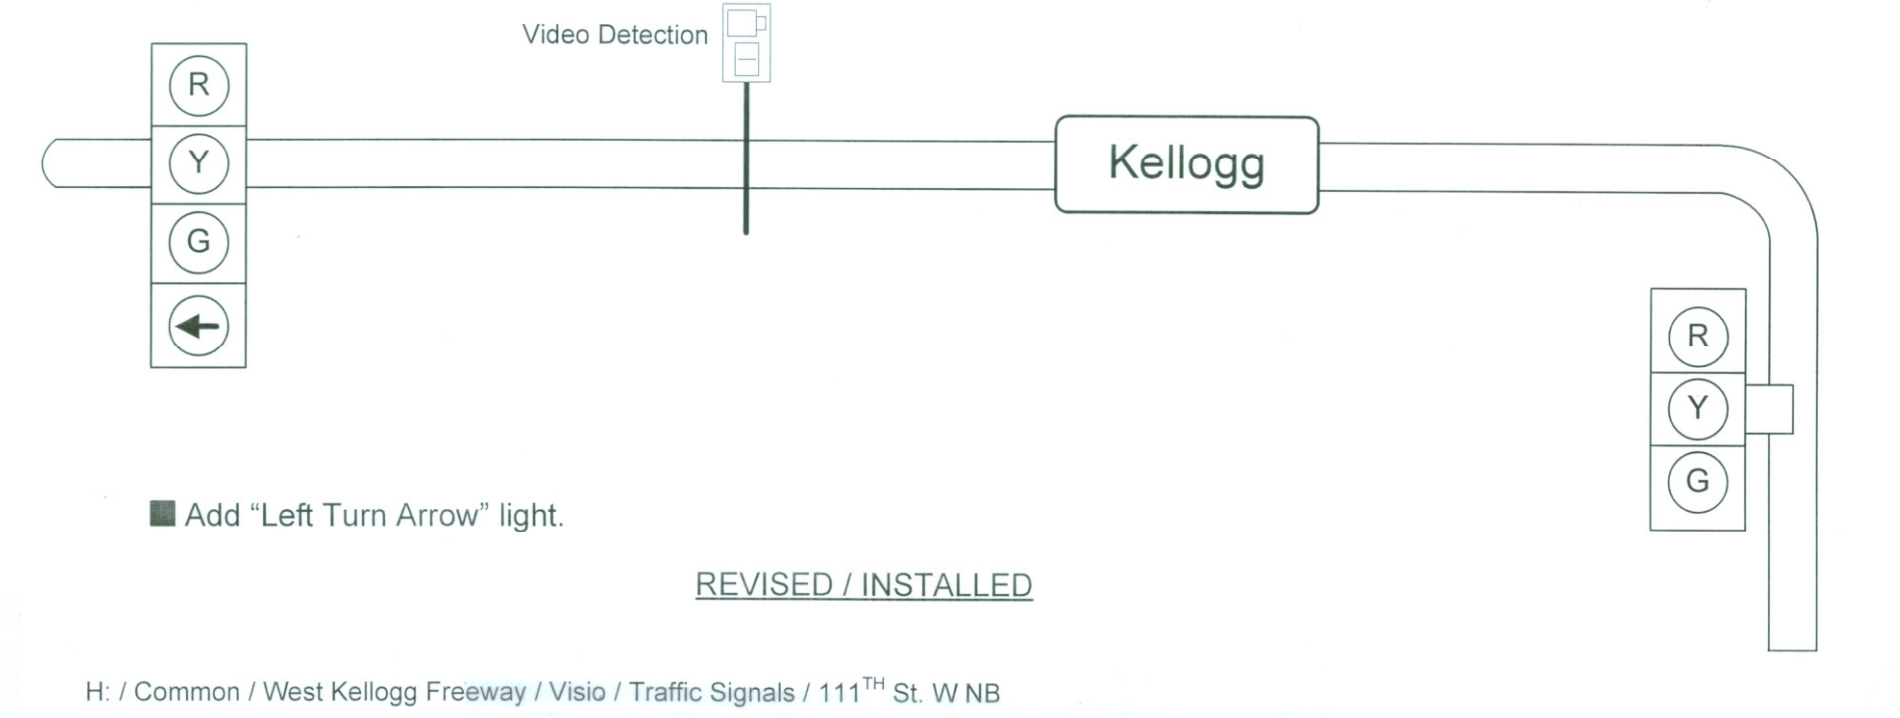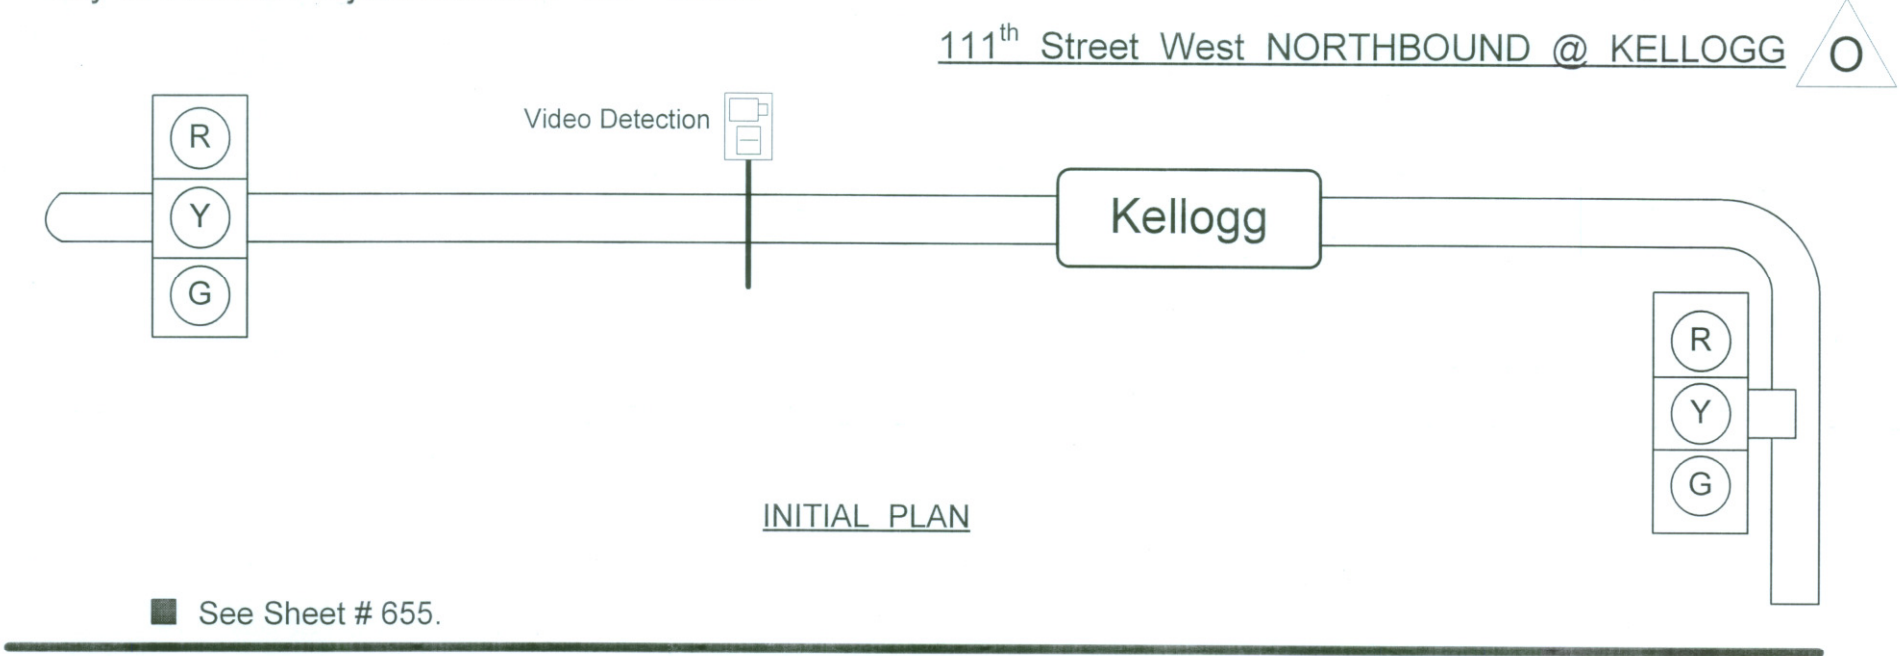

West Kellogg Freeway – Maize and Tyler Road Interchanges

City of Wichita Project Number: 472 - 83533

WK

