FHWA REGION NO.	STATE	PROJECT NO.	YEAR	SHEET NO.	TOTAL SHEETS
7	KANSAS	54-87 K-6657-01	2002	658	1122

ADDENDUM #2:

Sheet 658

1. **Add a single 50mm PVC conduit from the Service Box at Sta. 15+598, 13m Lt. to the Service Box at Sta. 15+644, 11m Lt.**

REPLACED WITH SHEET No. 658R

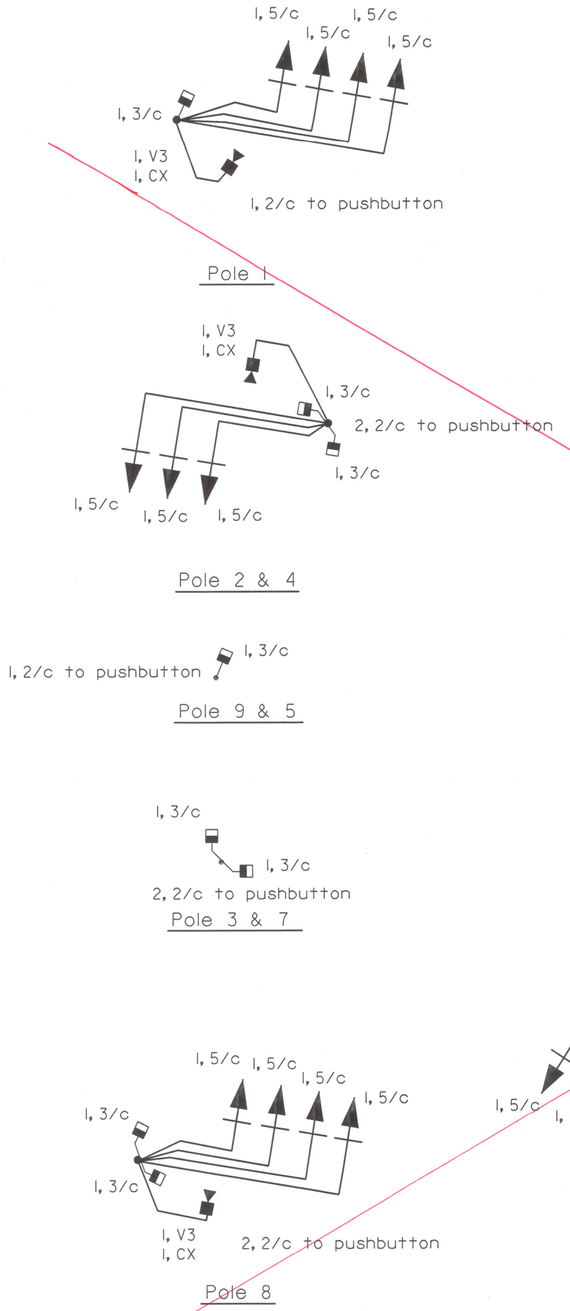

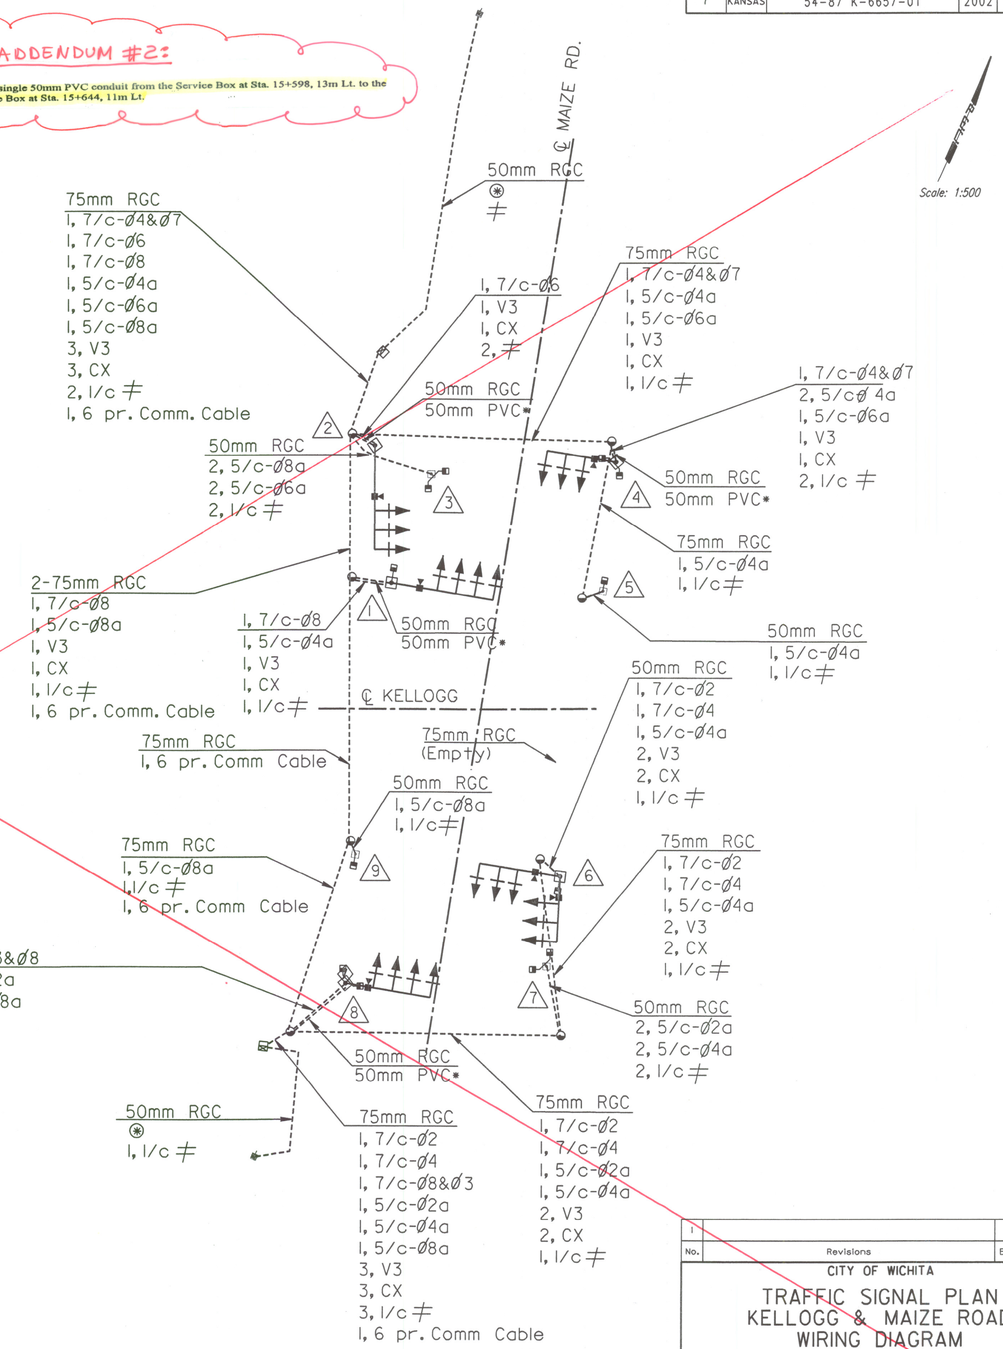

LEGEND

*	See Lighting Plan
#	Ground Wire No. 8 AWG, 1/c
⊛	Power Supply 2 No. 6 AWG, 1/c
V3	Video Power Cable No. 16 AWG, 3/c
CX	75 ohm Coax Video Cable
	6 pr. Comm. Cable - PVC Jacketed No. 19 AWG Twisted Pair

No.	Revisions	By	Date
1			

CITY OF WICHITA

TRAFFIC SIGNAL PLAN
KELLOGG & MAIZE ROAD
WIRING DIAGRAM

SEDGWICK COUNTY

Professional Engineering Consultants, P.A.
303 S. TOPEKA • WICHITA, KANSAS 67202
316-262-2691 • FAX 316-262-3003

Designed by	RPG	Checked by	BER
Drawn by	JSB	Date	April 2002
Job No.	97362		

REFERENCES NOTED	BY	DATE
REFERENCES CHECKED		

DSNR: OPER: JGP SCALE: 1:500
I:/1997/97362/SIGNALS/MAIZEWIRING.DGN 7-11-2001 11:08:31 LAST REV: 4-1-02 BY: drp