| FHWA REGION NO. | STATE | PROJECT NO. | YEAR | SHEET NO. | TOTAL SHEETS |
|---|---|---|---|---|---|
| 7 | KANSAS | 54-87 K-6657-01 | 2002 | 658R | 1122 |

**ADDENDUM NO. 2:**
The following changes and additions shall be made to the plans and proposal. When this addendum conflicts with the specifications, plans, or special provisions, or Addendum # 1, **THIS ADDENDUM SHALL GOVERN**.

**Sheet 658**

1. Add a single 50mm PVC conduit from the Service Box at Sta. 15+598, 13m Lt. to the Service Box at Sta. 15+644, 11m Lt.

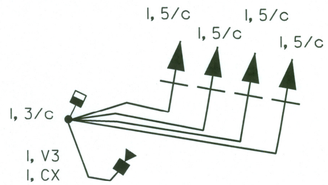


Pole 1

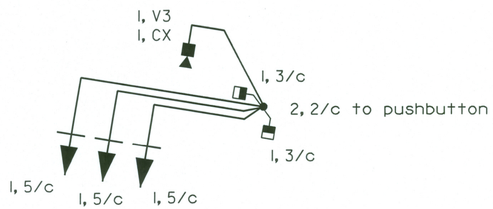


Pole 2 & 4

Pole 9 & 5

Pole 3 & 7

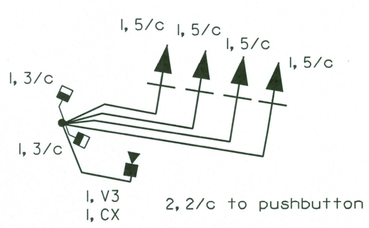


Pole 8

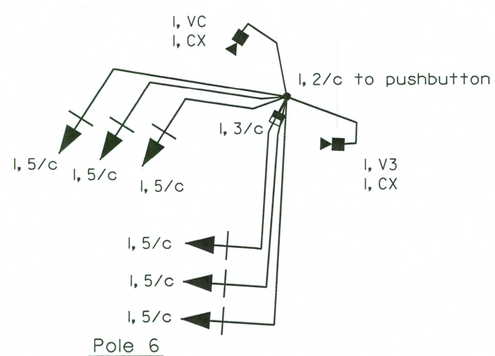


Pole 6

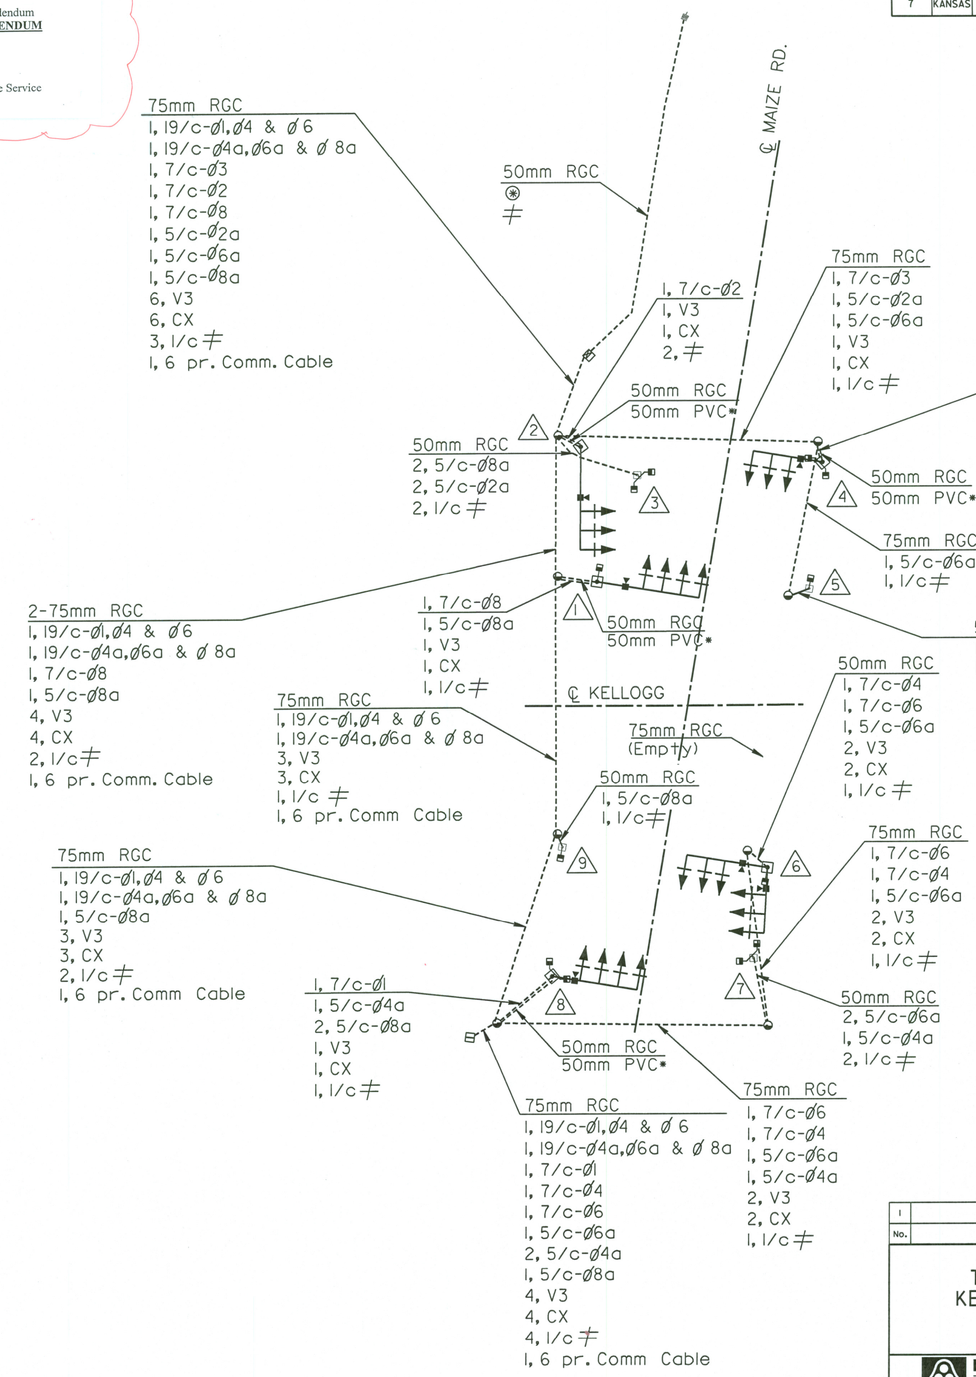


**LEGEND**

| | |
|---|---|
| * | See Lighting Plan |
| ≠ | Ground Wire No. 8 AWG, 1/c |
| (*) | Power Supply 2 No. 6 AWG, 1/c |
| V3 | Video Power Cable No. 16 AWG, 3/c |
| CX | 75 ohm Coax Video Cable |
| | 6 pr. Comm. Cable - PVC Jacketed No. 19 AWG Twisted Pair |

| No. | Revisions | By | Date |
|---|---|---|---|
| 1 | Changed to use one Controller | RPG | 5/24/05 |

CITY OF WICHITA

# TRAFFIC SIGNAL PLAN
# KELLOGG & MAIZE ROAD
# WIRING DIAGRAM

SEDGWICK COUNTY


Professional Engineering Consultants, P.A.
303 S. TOPEKA • WICHITA, KANSAS 67202
316-262-2691 • FAX 316-262-3003


| | | | |
|---|---|---|---|
| Designed by | RPG | Checked by | BER |
| Drawn by | JSB | Date April 2002 | Job No. 97362 |

| DATE | BY | |
|---|---|---|
| REFERENCES NOTED | | |
| REFERENCES CHECKED | | |

DSNR: RPG OPER: SDM SCALE: BY:
I:/1997/97362/MAIZEWIRING-REVISION.DGN 5-31-2005 8:24:21 LAST REV: