
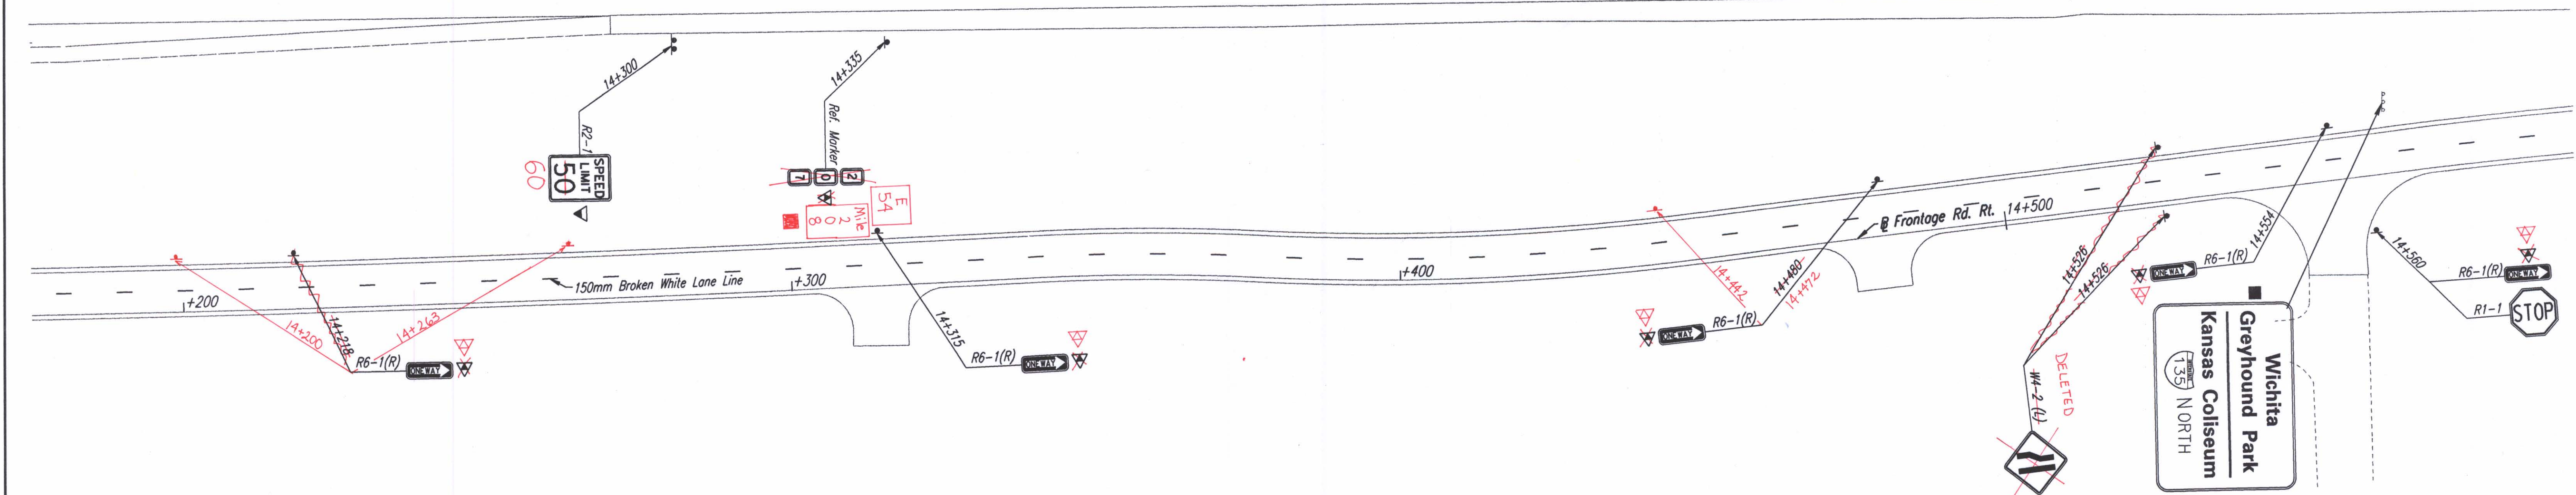


|                 |        |                 |      |           |              |
|-----------------|--------|-----------------|------|-----------|--------------|
| FHWA REGION NO. | STATE  | PROJECT NO.     | YEAR | SHEET NO. | TOTAL SHEETS |
| 7               | KANSAS | 54-87 K-6657-01 | 2002 | 682       | 1122         |

|                    |      |
|--------------------|------|
| REFERENCES NOTED   | DATE |
| REFERENCES CHECKED |      |
|                    |      |
|                    |      |
|                    |      |
|                    |      |

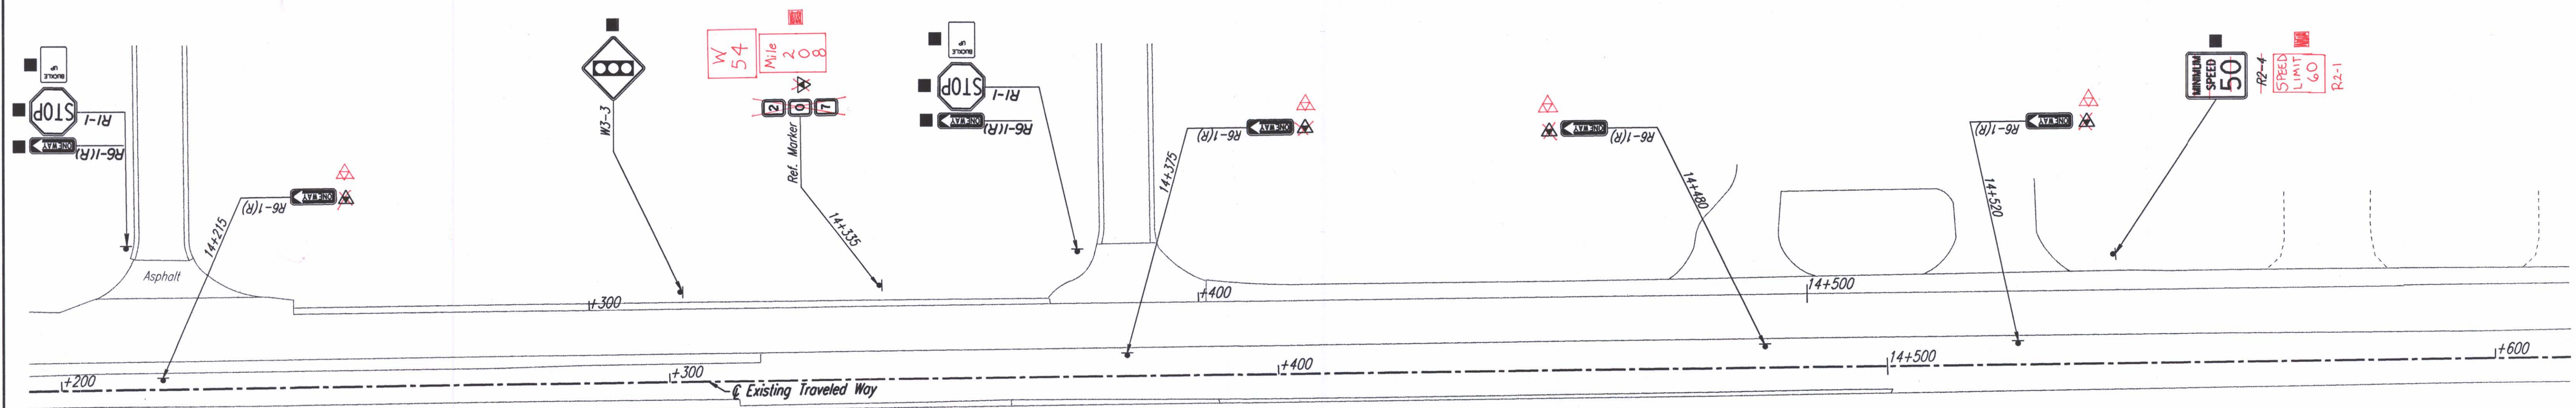

DSNR: WDH OPER: JGP SCALE: 1:500  
 I:/1997/97362/MARKING/PL142.DGN 4-02-2001 15:15:28 LAST REV: 1-24-2002 BY: svb

**Wichita**  
 Greyhound Park  
 Kansas Coliseum  
 NORTH  
 135

|  |           |            |                            |
|--|-----------|------------|----------------------------|
| No.  | Revisions | By         | Date                       |
| CITY OF WICHITA  |           |            |                            |
| SIGNING & MARKING PLAN<br>Sta. 14+200 TO Sta. 14+600   |           |            |                            |
| SEDGWICK COUNTY  |           |            |                            |
| <b>Professional Engineering Consultants, P.A.</b><br><small>303 S. TOPEKA • WICHITA, KANSAS 67202<br/>         316-262-2691 • FAX 316-262-3003</small> |           |            |                            |
| Designed by  | RPG       | Checked by | WDH                        |
| Drawn by   | SVB       | Date       | Apr-11, 2002 Job No. 97362 |