



REFERENCES NOTED	DATE
REFERENCES CHECKED	

DSNR: WDH OPER: JGP SCALE: 1:500  
 I:\1997\97362\OLD-METRIC-OLD\Marking\PL146REVISED\_07\_19\_2004.DGN 04-02-2004 7:19:49 LAST REV: 07-21-2004 BY: djb

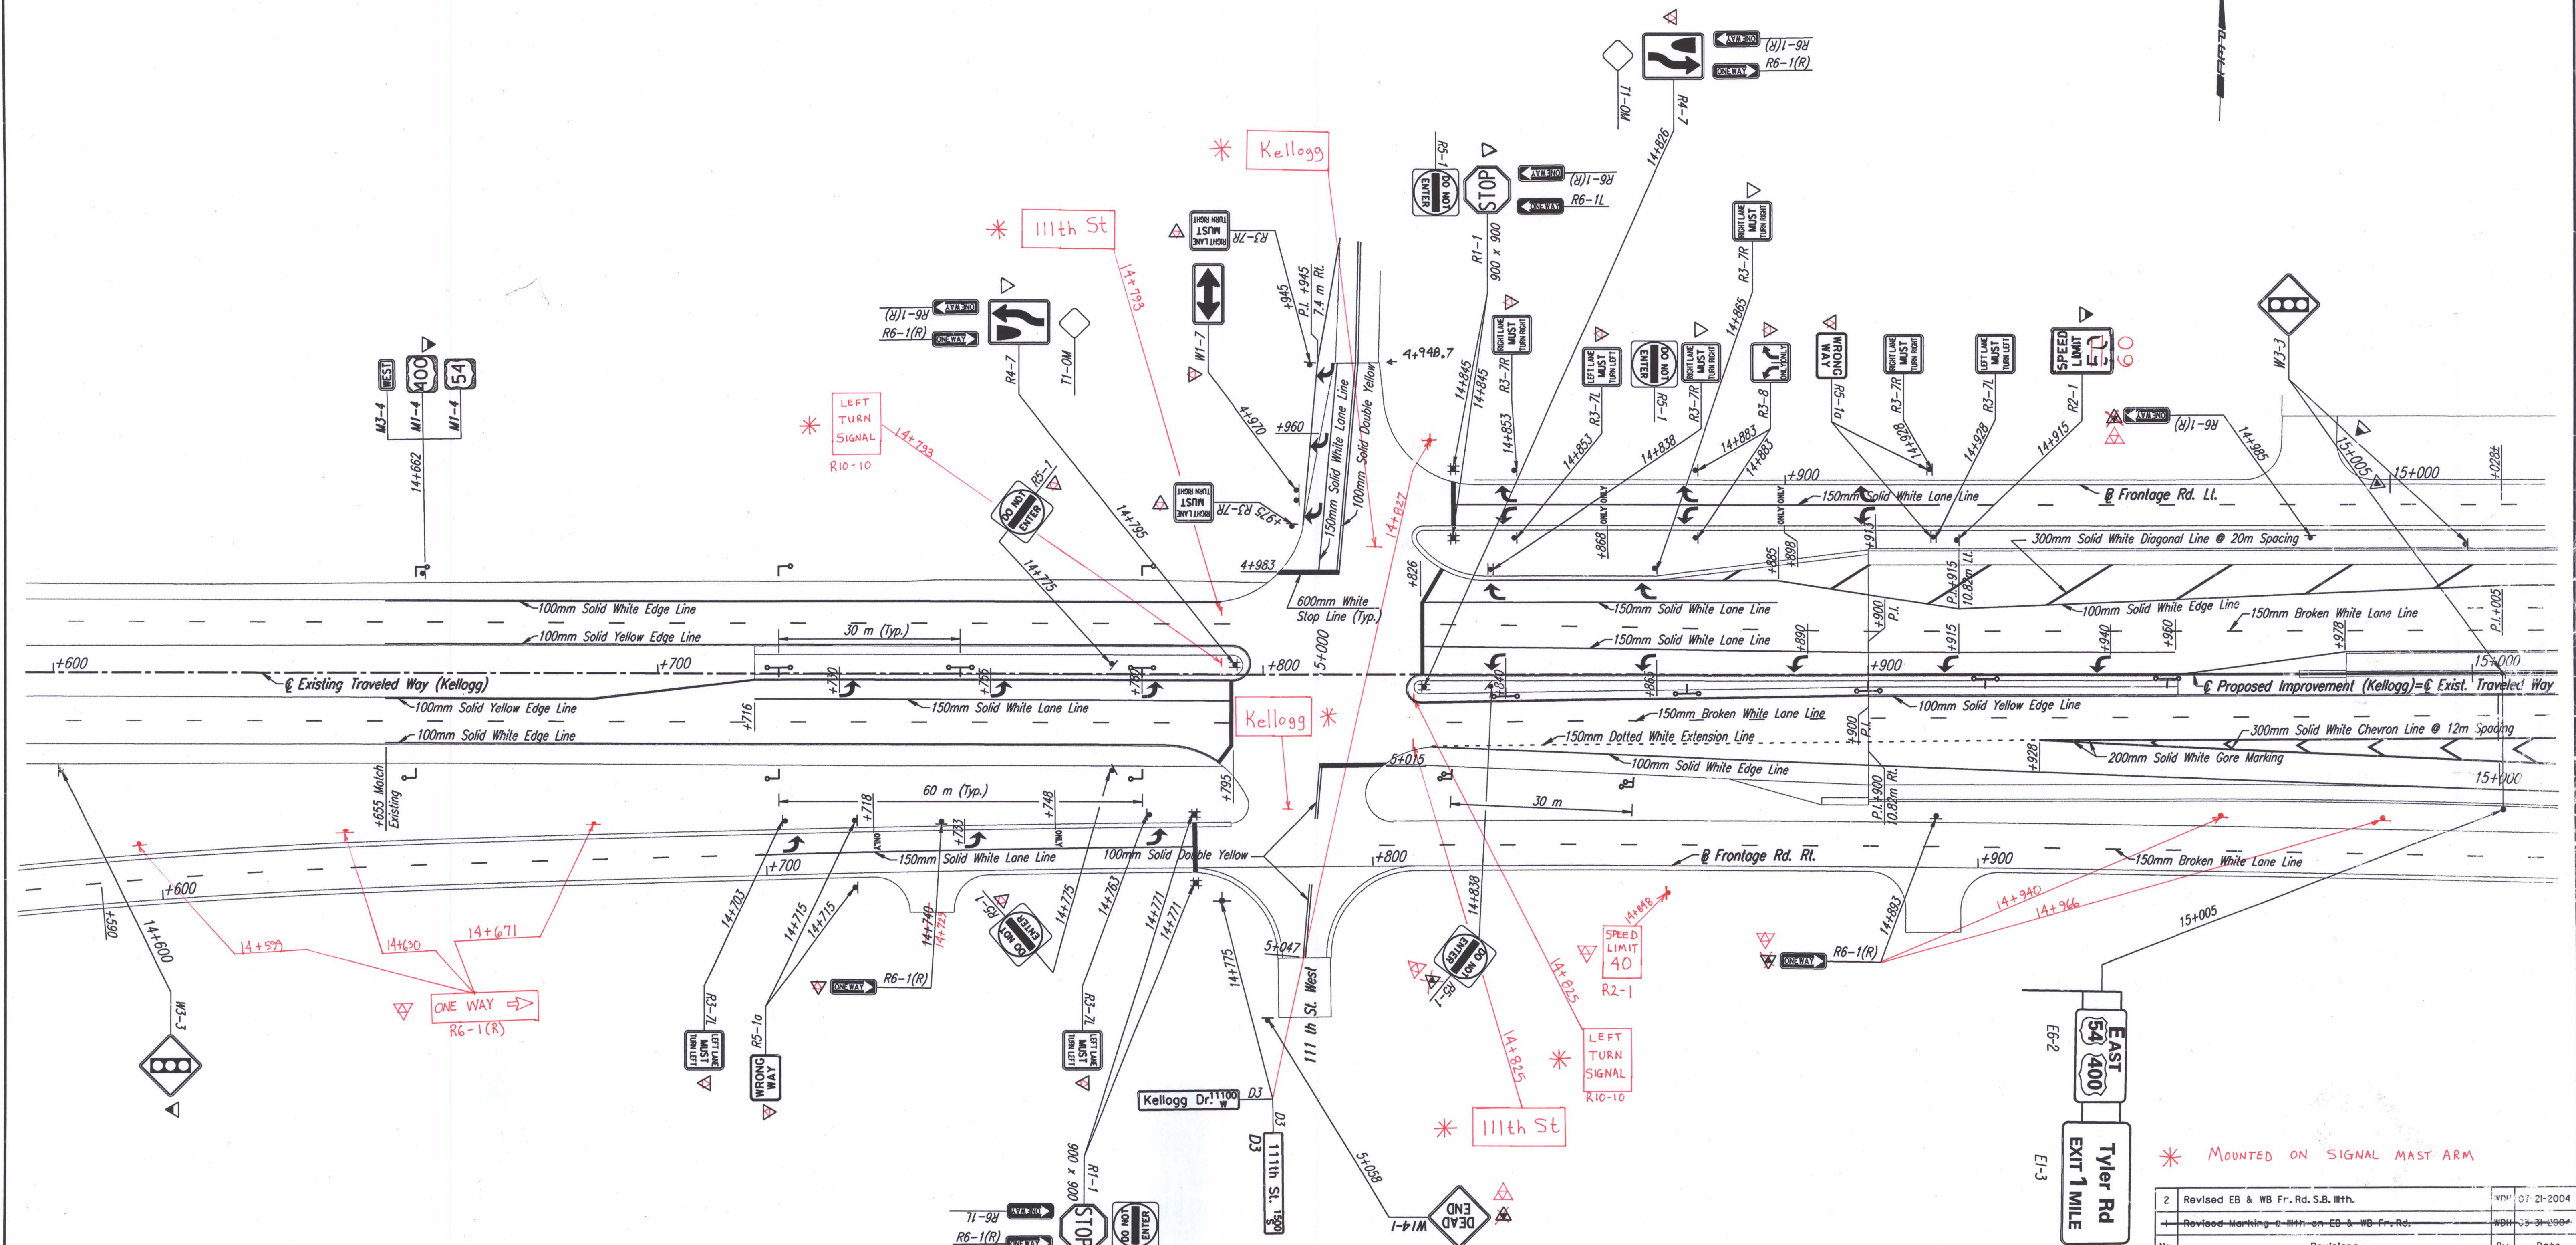

	Type A	Type B
White	6	2
Yellow (Back to Back)	8	

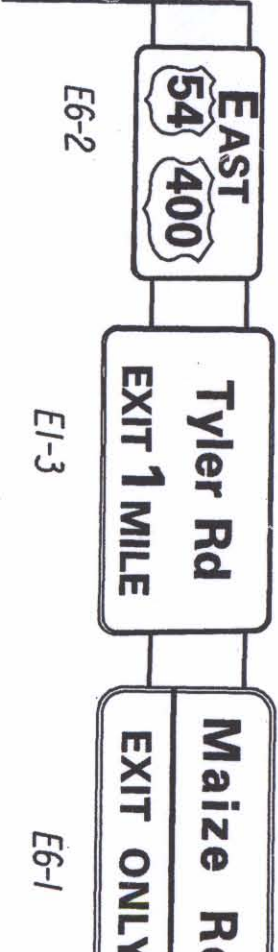

\* MOUNTED ON SIGNAL MAST ARM

2	Revised EB & WB Fr. Rd. S.B. 111th.	WDM	07-21-2004
1	Revised Marking & Signs on EB & WB Fr. Rd.	WDM	03-31-2004

No. \_\_\_\_\_ Revisions \_\_\_\_\_ By \_\_\_\_\_ Date \_\_\_\_\_

CITY OF WICHITA

**SIGNING & MARKING PLAN**  
 STA. 14+600 TO STA. 15+000

SEDGWICK COUNTY

**Professional Engineering Consultants, P.A.**  
 303 S. TOPEKA • WICHITA, KANSAS 67202  
 316-262-2691 • FAX 316-262-3003

Designed by	RPG	Checked by	WDH
Drawn by	SVB	Date	April, 2002
		Job No.	97362