


FHWA REGION NO.	STATE	PROJECT NO.	YEAR	SHEET NO.	TOTAL SHEETS
7	KANSAS	54-87 K-6657-01	2002	684	1122

DATE	
BY	
REFERENCES NOTED	
REFERENCES CHECKED	

DSNR: WDH OPER: JGP SCALE: 1:500  
 I:/1997/97362/Marking/PL150.DGN 11-05-1999 7:38:05 LAST REV: 1-24-2002 BY: svb

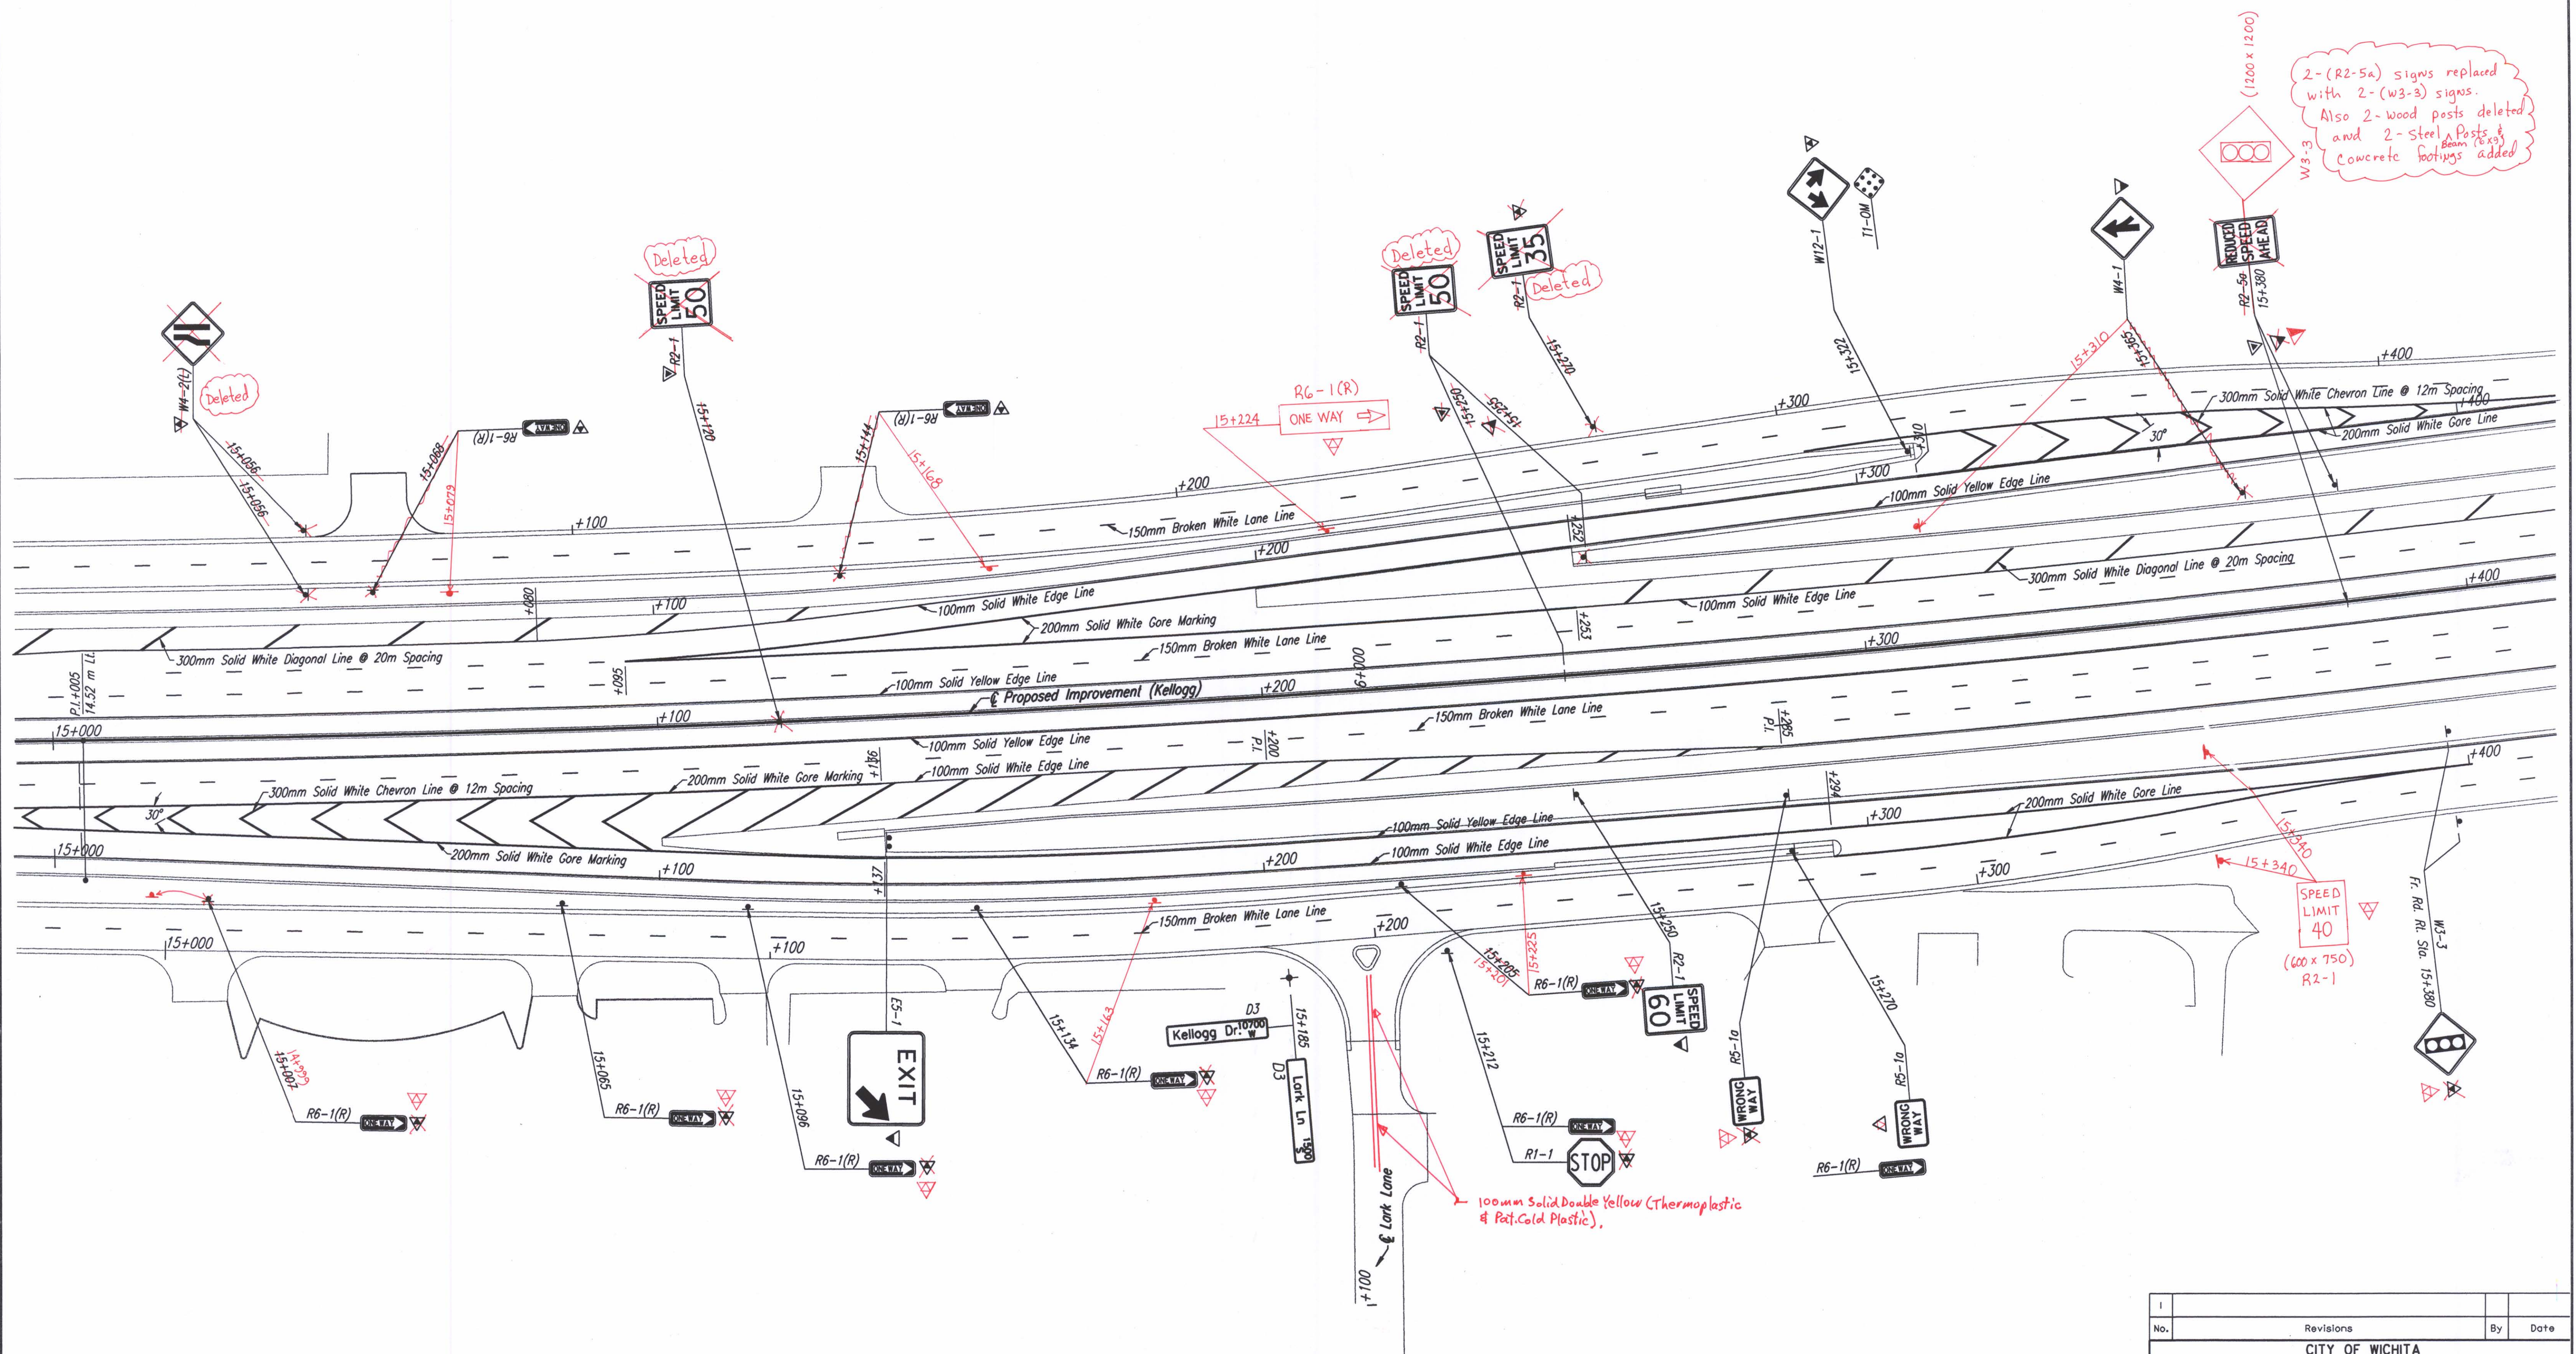

2-(R2-5a) signs replaced with 2-(W3-3) signs. Also 2-wood posts deleted and 2-Steel Posts & Beam (6x9) Concrete Footings added

100mm Solid Double Yellow (Thermoplastic & Pat. Cold Plastic),

1			
No.	Revisions	By	Date
CITY OF WICHITA			
SIGNING & MARKING PLAN			
STA. 15+000 TO STA. 15+400			
SEDGWICK COUNTY			
<b>Professional Engineering Consultants, P.A.</b> 303 S. TOPEKA • WICHITA, KANSAS 67202 316-262-2691 • FAX 316-262-3003			
Designed by	RPG	Checked by	WDH
Drawn by	SVB	Date	April, 2002
		Job No.	97362