


FHWA REGION NO.	STATE	PROJECT NO.	YEAR	SHEET NO.	TOTAL SHEETS
7	KANSAS	54-87 K-6657-01	2002	685	1122

NOTE:
Install 150mm Solid White Edge Lines (Pat. Cold Plastic) around all islands, except don't install on paving brick at cross-walks.

DATE	BY
REFERENCES NOTED	REFERENCES CHECKED

DSNR: WDH OPER: JGP SCALE: 1:500
i:/1997/97362/Marking/PL154.DGN 11-09-1999 8:49:44 LAST REV: 1-24-2002 BY: svb

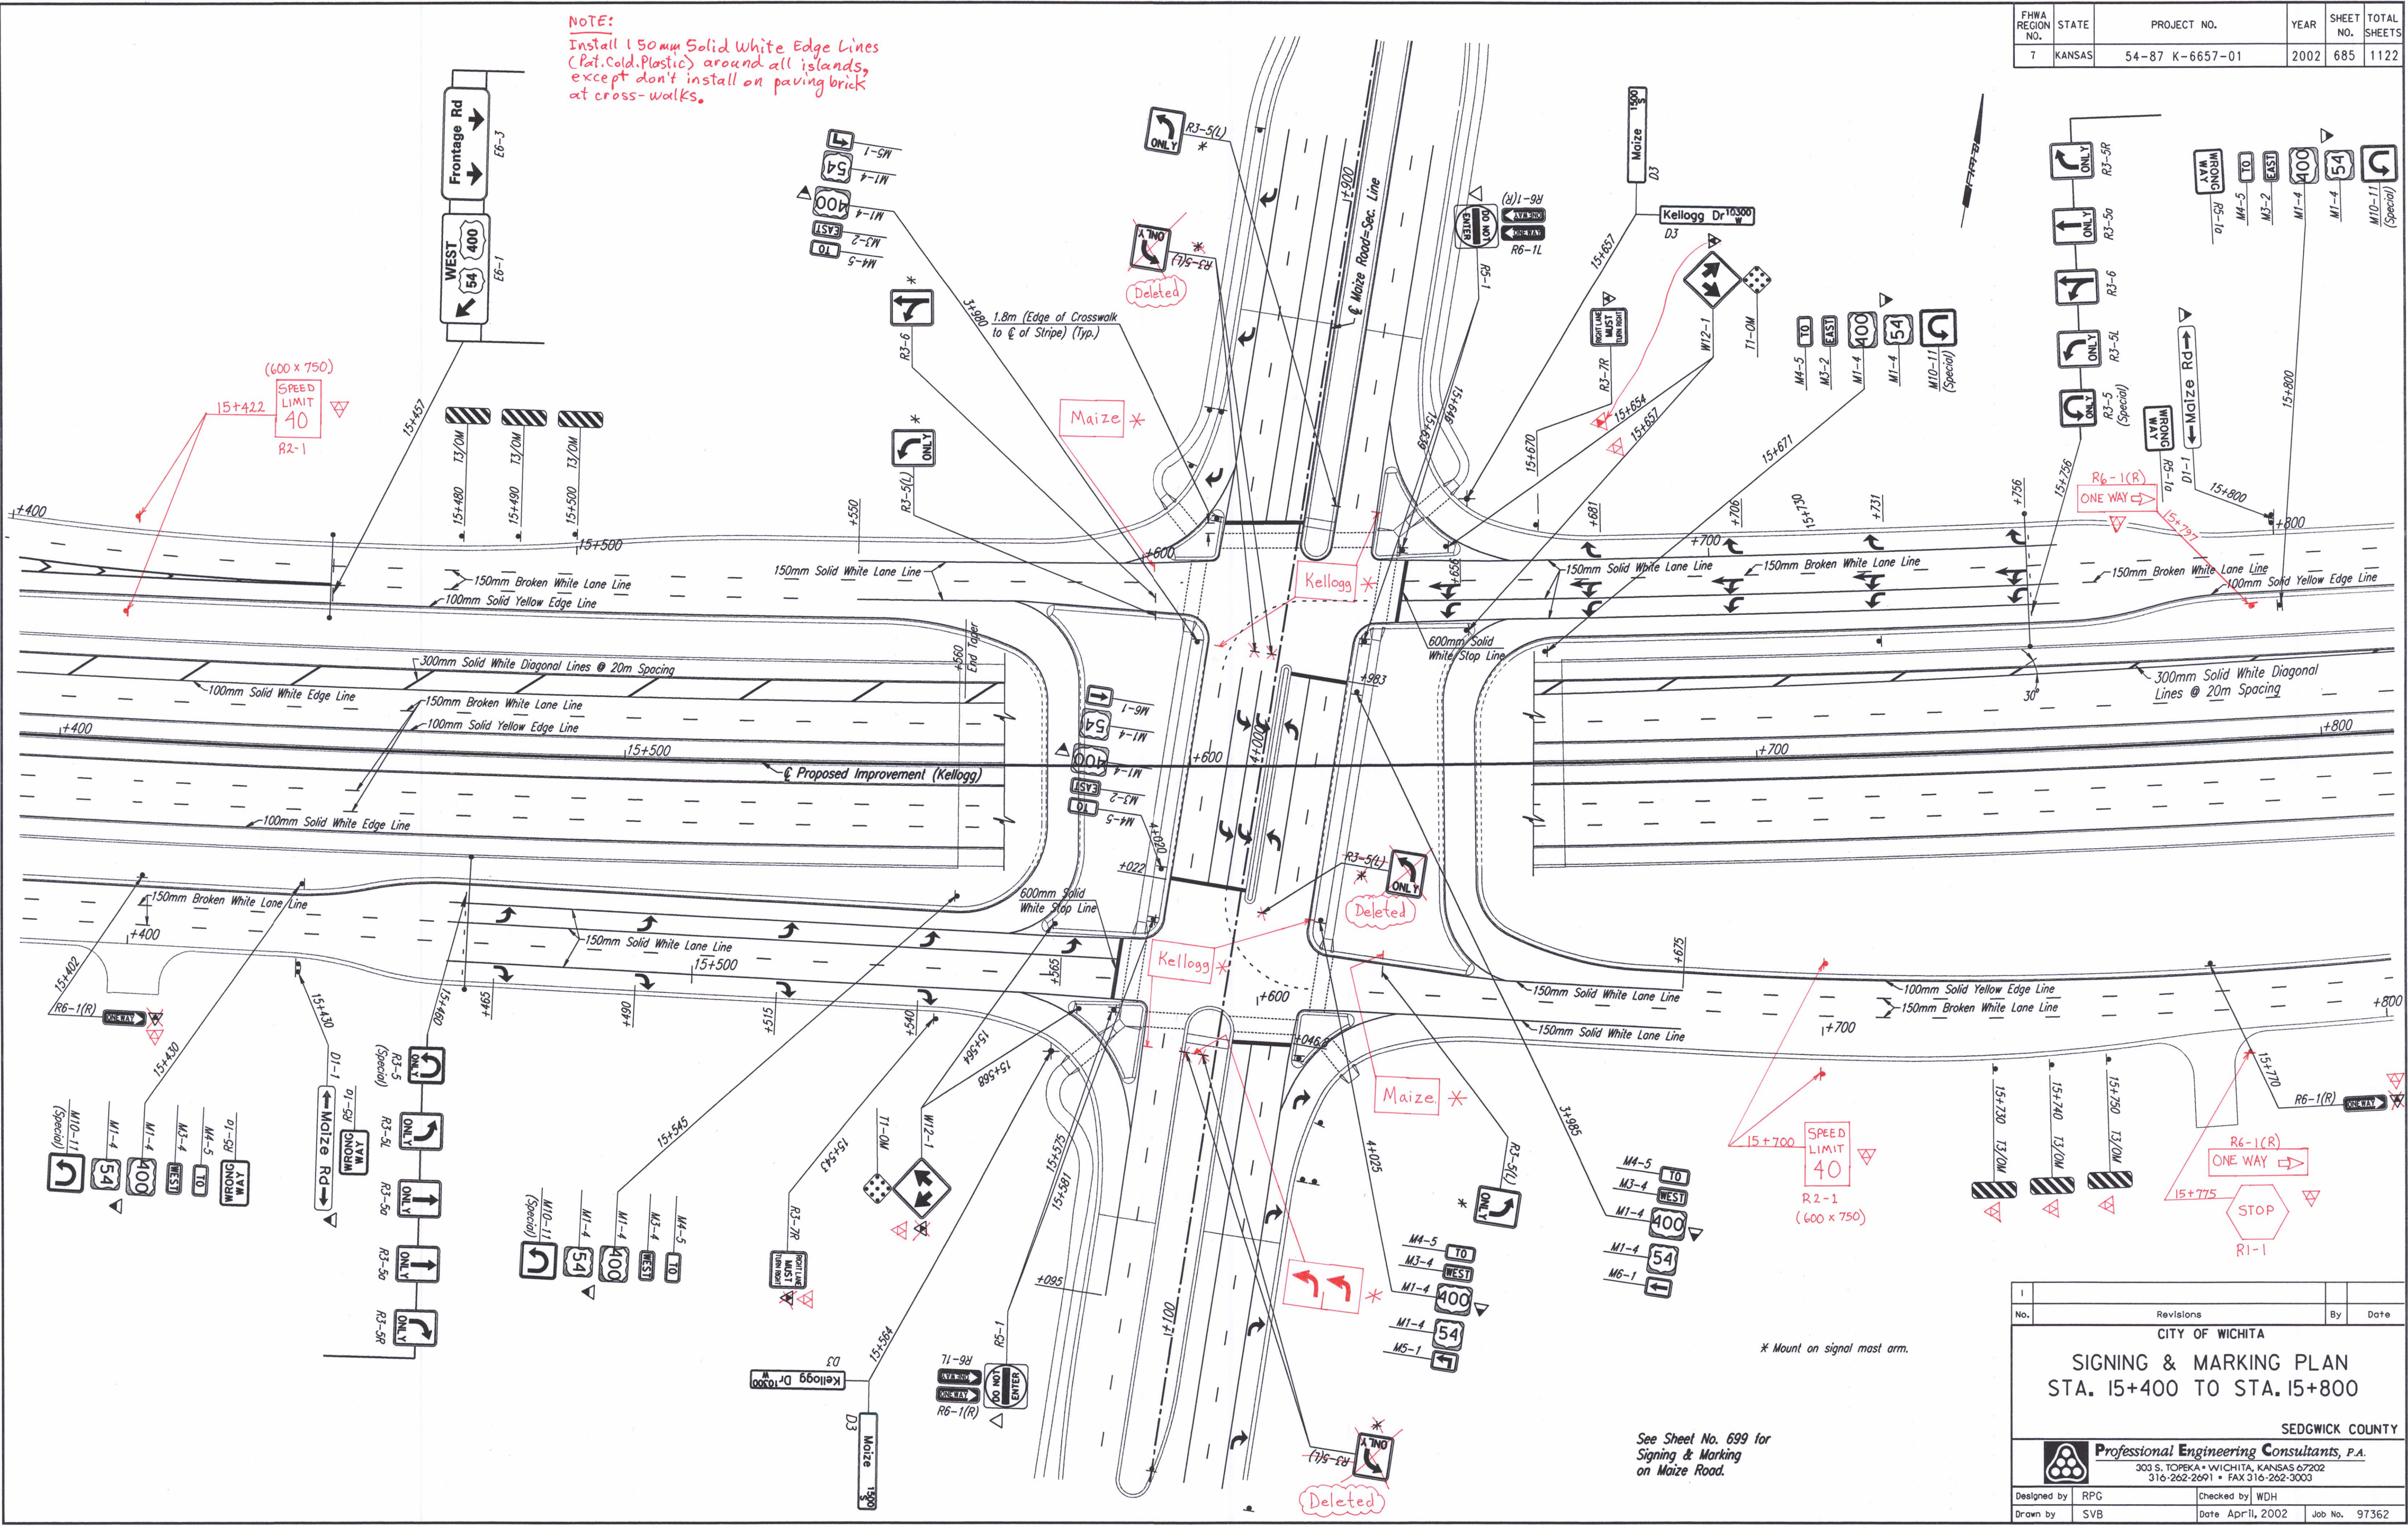

* Mount on signal mast arm.

See Sheet No. 699 for Signing & Marking on Maize Road.

No.	Revisions	By	Date

CITY OF WICHITA
SIGNING & MARKING PLAN
STA. 15+400 TO STA. 15+800

SEDGWICK COUNTY

Professional Engineering Consultants, P.A.
303 S. TOPEKA • WICHITA, KANSAS 67202
316-262-2691 • FAX 316-262-3003

Designed by	RPG	Checked by	WDH
Drawn by	SVB	Date	Apr 11, 2002
		Job No.	97362