FHWA REGION NO.	STATE	PROJECT NO.	YEAR	SHEET NO.	TOTAL SHEETS
7	KANSAS	54-87 K-6657-01	2002	689	1122

NOTE:
Install 150mm Solid White Edge Lines (Pat. Cold Plastic) around all islands, except don't install on paving brick at cross-walks.

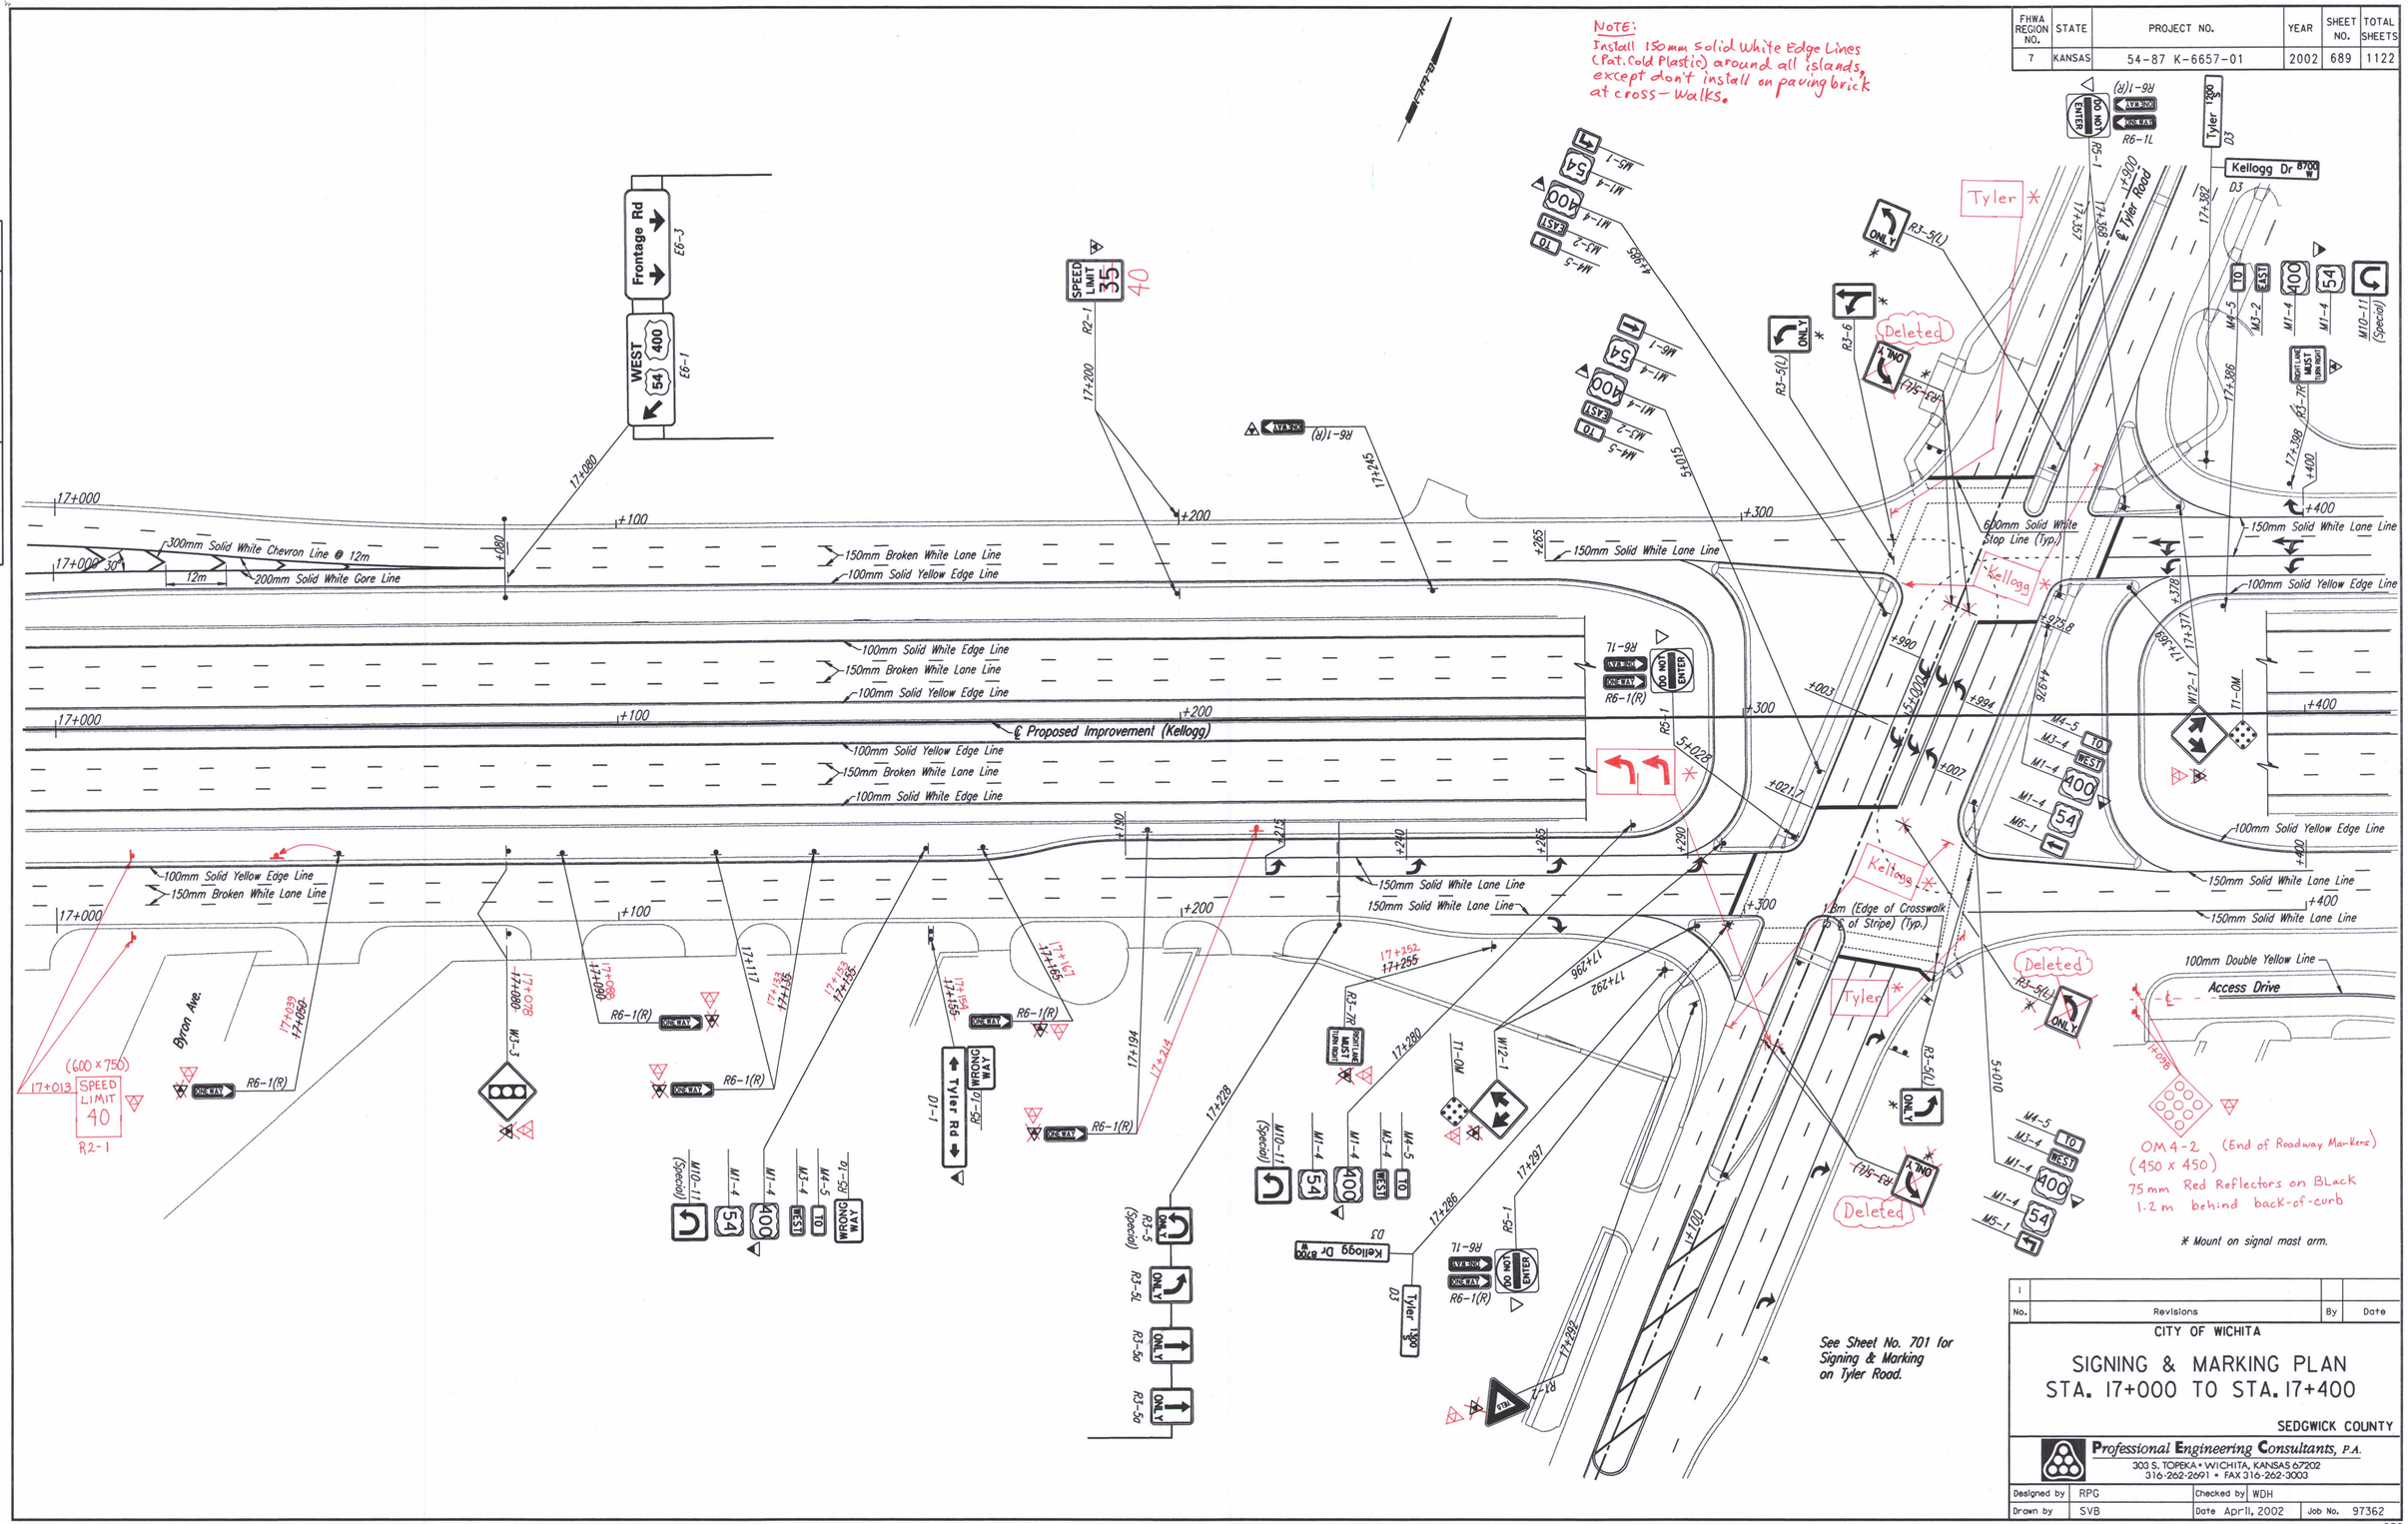

No.	Revisions	By	Date
1			

CITY OF WICHITA

SIGNING & MARKING PLAN
STA. 17+000 TO STA. 17+400

SEDGWICK COUNTY

Professional Engineering Consultants, P.A.
303 S. TOPEKA • WICHITA, KANSAS 67202
316-262-2691 • FAX 316-262-3003

Designed by	RPG	Checked by	WDH
Drawn by	SVB	Date April, 2002	Job No. 97362

REFERENCES NOTED	BY	DATE
REFERENCES CHECKED		

DSNR: WDH OPER: JGP SCALE: 1:500 BY: svb
I:/1997/97362/Marking/PL170.DGN 11-08-1999 13:24:16 LAST REV: 1-24-2002