


DATE	
BY	
REFERENCES NOTED	
REFERENCES CHECKED	

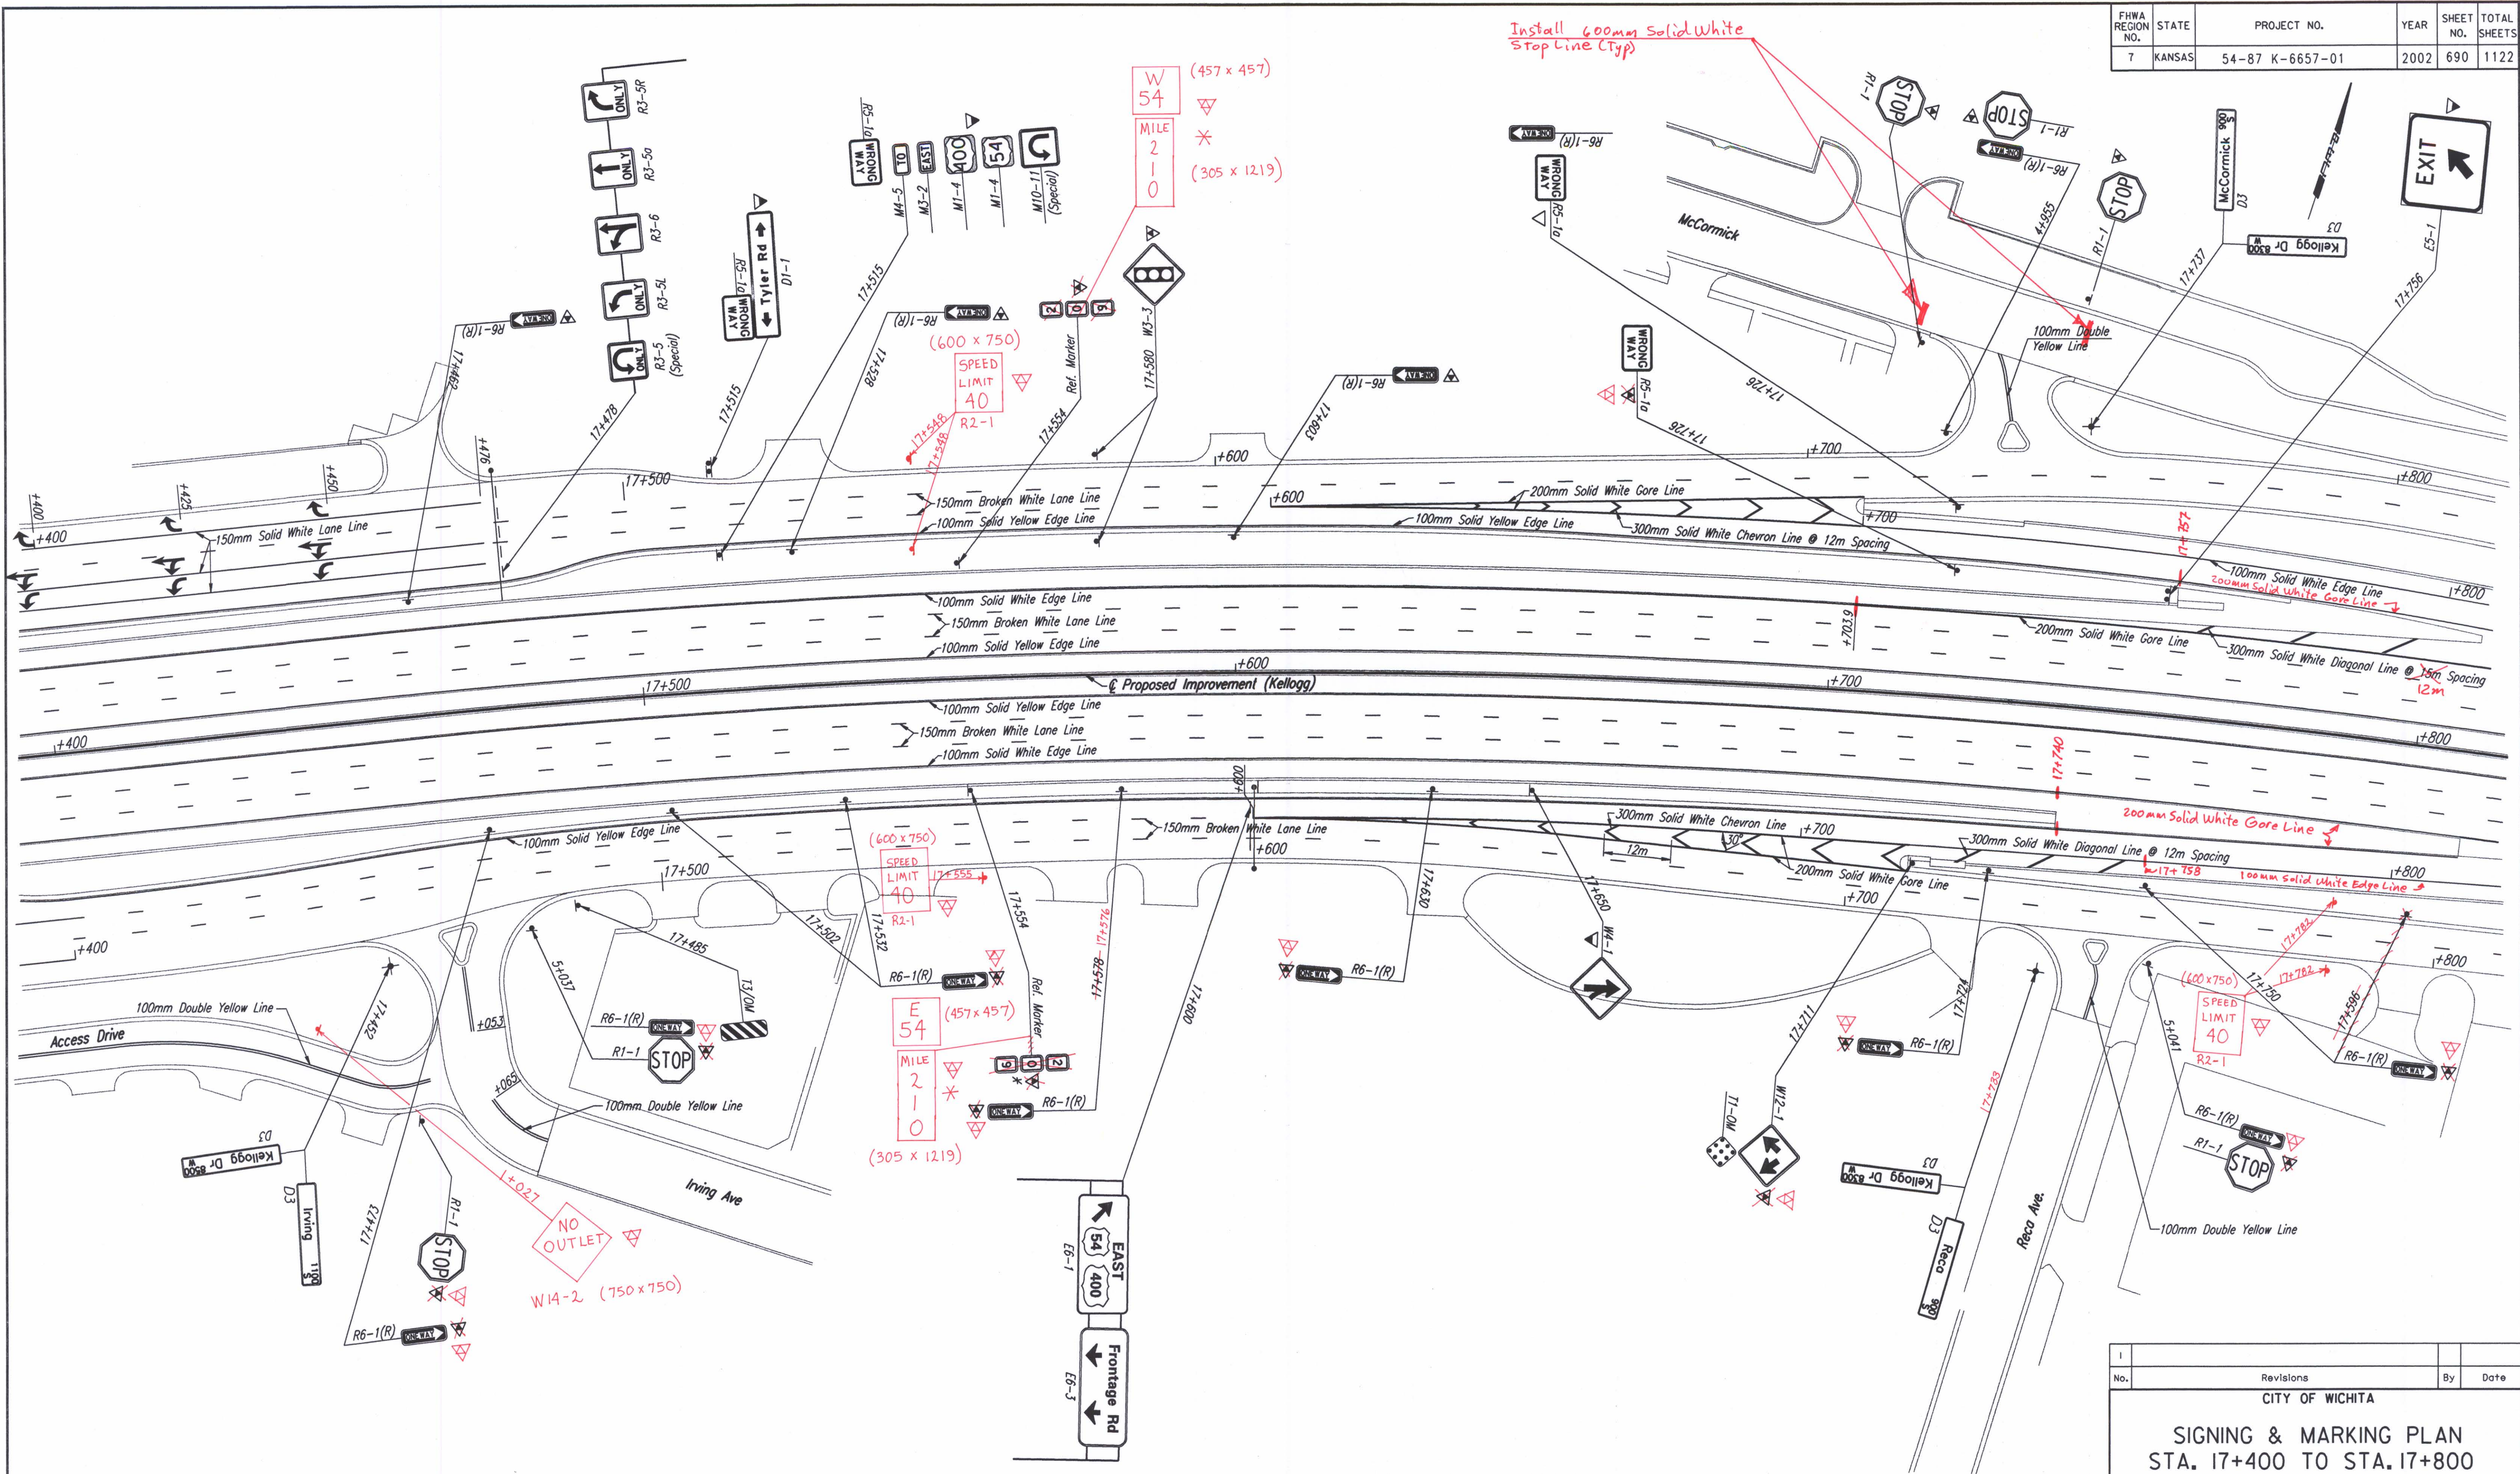

DSMR: WDH OPER: JGP SCALE: 1:500  
 i:/1997/97362/Marking/PL174.DGN 11-08-1999 9:05:41 LAST REV: 1-24-2002 BY: svb

\* Mount behind concrete safety barrier.  
 SQUARE STEEL POST WAS MOUNTED ON THE OUTSIDE FACE OF THE MSE WALL COPING BEHIND THE CONCRETE SAFETY BARRIER.

No.	Revisions	By	Date

CITY OF WICHITA

**SIGNING & MARKING PLAN**  
 STA. 17+400 TO STA. 17+800

SEDGWICK COUNTY

**Professional Engineering Consultants, P.A.**  
 303 S. TOPEKA • WICHITA, KANSAS 67202  
 316-262-2691 • FAX 316-262-3003

Designed by	RPG	Checked by	WDH
Drawn by	SVB	Date	April, 2002
		Job No.	97362