


FHWA REGION NO.	STATE	PROJECT NO.	YEAR	SHEET NO.	TOTAL SHEETS
7	KANSAS	54-87 K-6657-01	2002	848	1122

NOTE: FOR ACTUAL LOCATION OF IRRIGATION ITEMS, SEE IRRIGATION RECORD DRAWINGS, SHEET NO. 871A TO 871N.


DATE	
BY	
REFERENCES NOTED	
REFERENCES CHECKED	

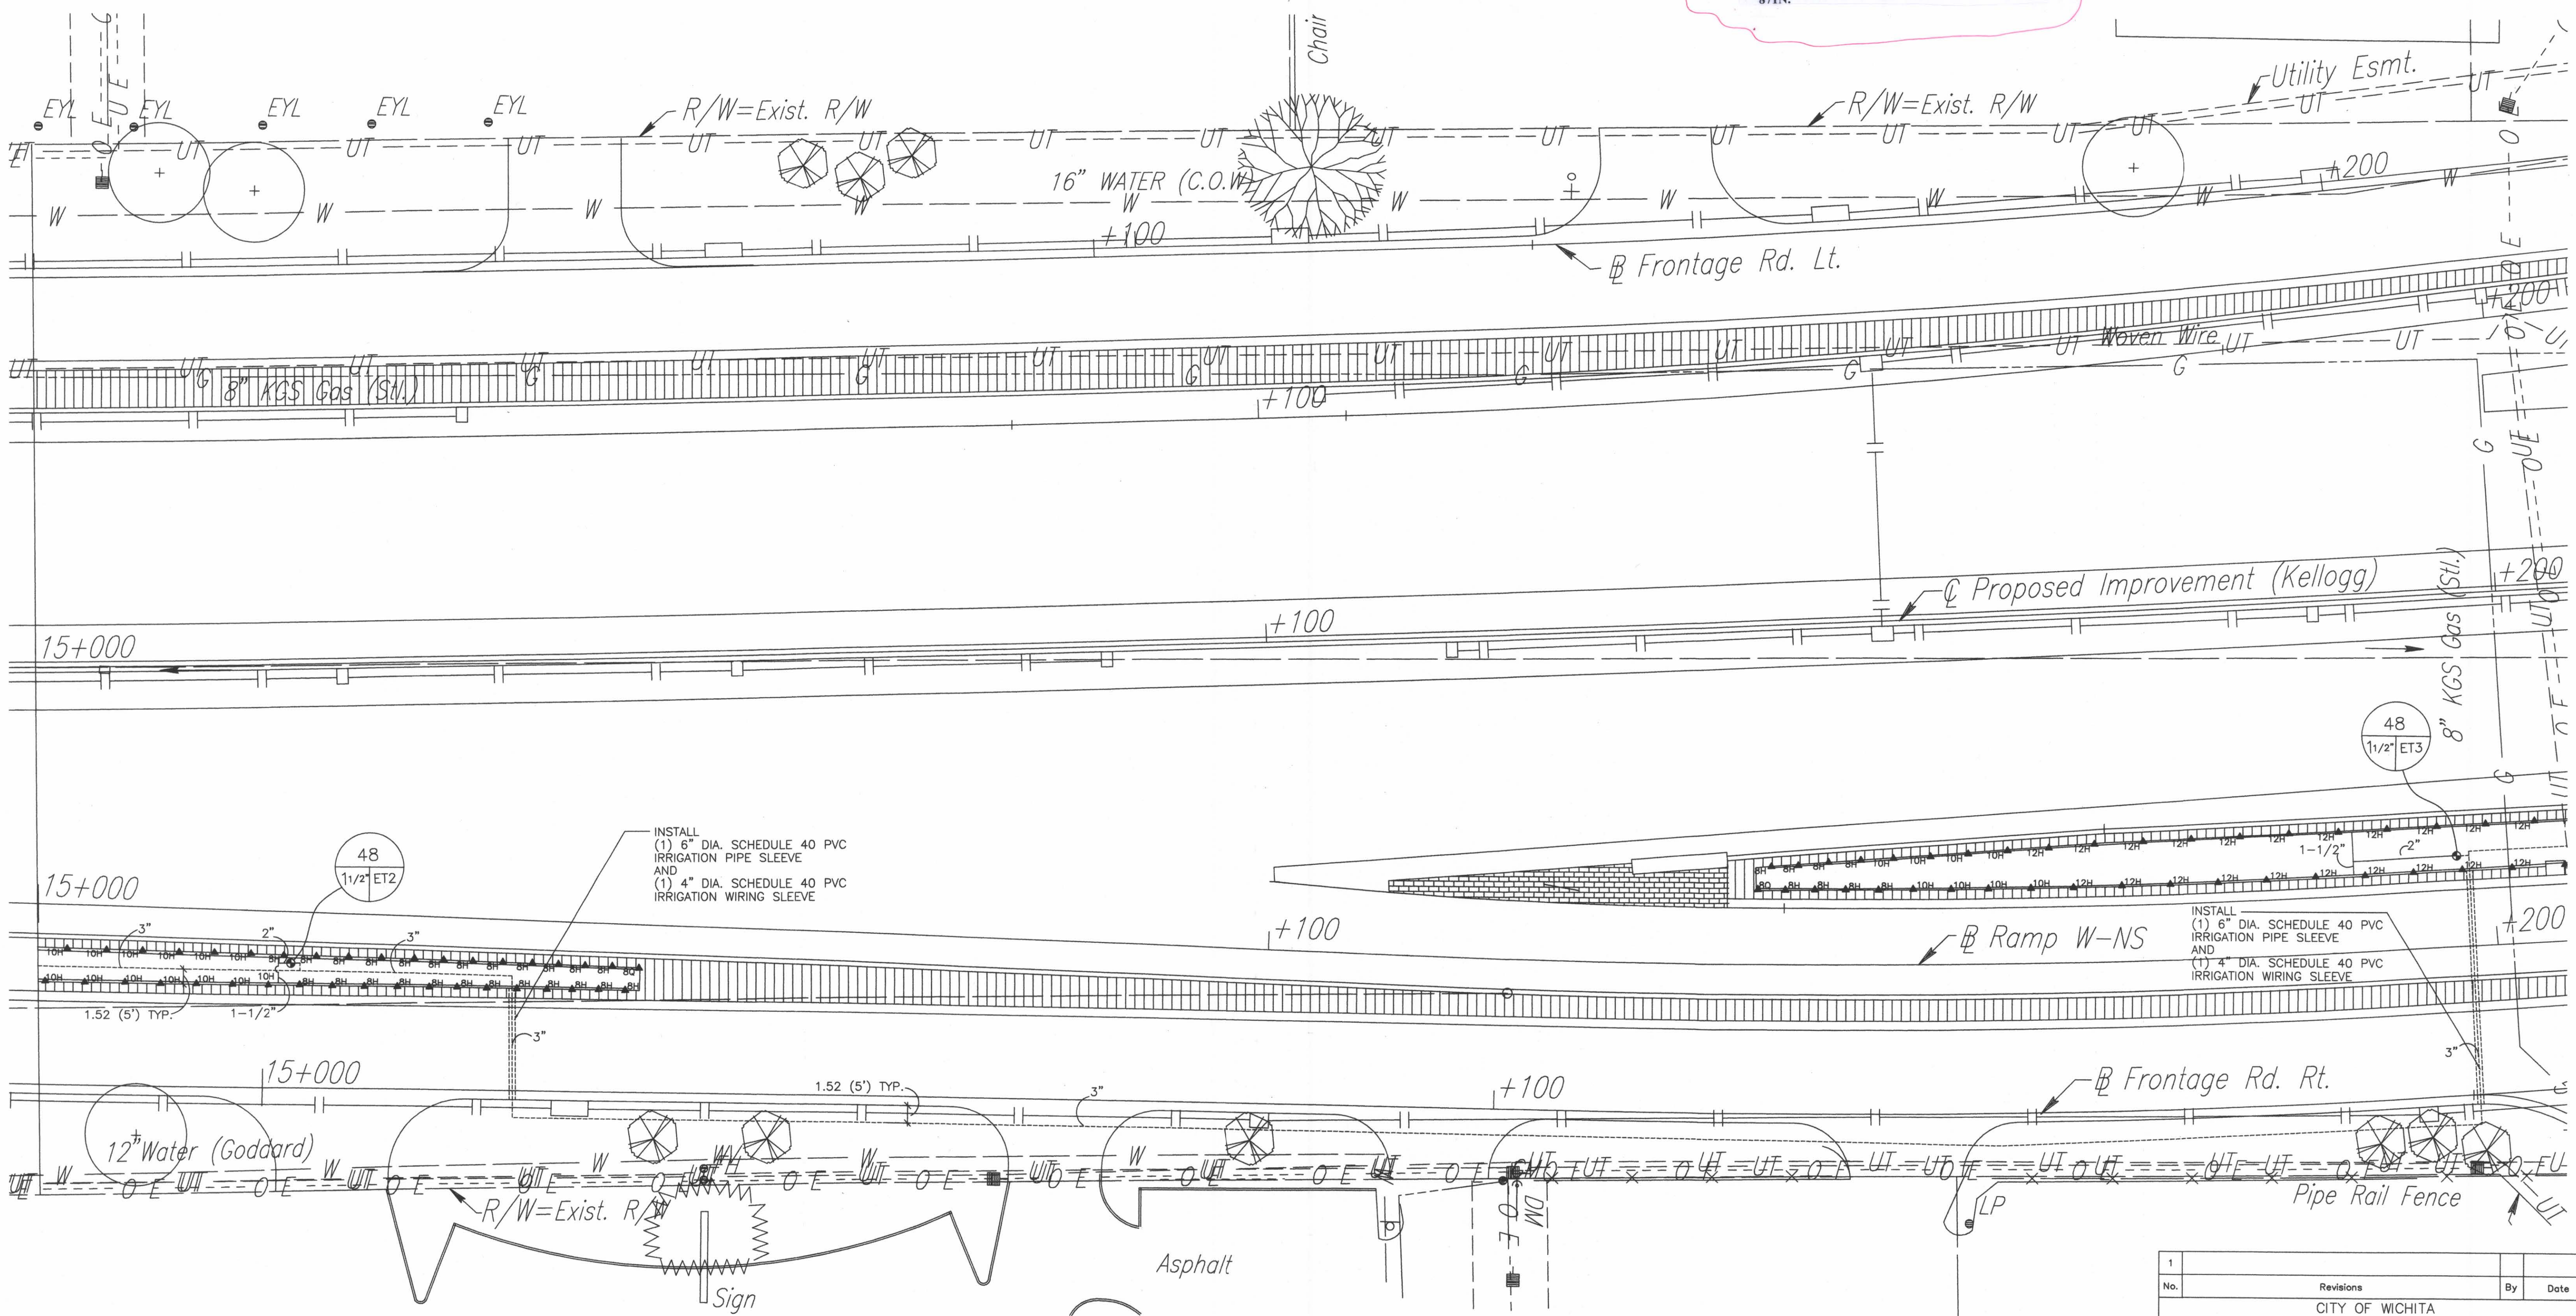

DSNR: OPER: DWR SCALE: 1:500  
 F:/9934/S150



**IRRIGATION PLAN**  
 METRIC SCALE: 1:250  
 CONVERSION RATIO: 1 METER = 3.281'

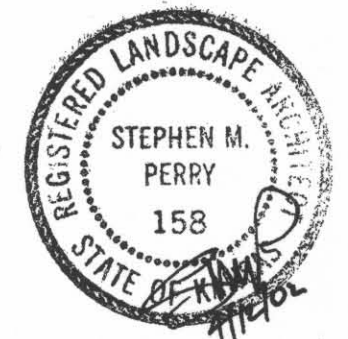

1			
No.	Revisions	By	Date
CITY OF WICHITA			
IRRIGATION PLAN STA. 15+000 TO STA. 15+200			
SEDGWICK COUNTY			
Professional Engineering Consultants, P.A. 303 S. TOPEKA • WICHITA, KANSAS 67202 316-262-2691 • FAX 316-262-3003			
Designed by	SMP	Checked by	
Drawn by	DWR	Date	April, 2002
			Job No. 97362