FHWA REGION NO.	STATE	PROJECT NO.	YEAR	SHEET NO.	TOTAL SHEETS
7	KANSAS	54-87 K-6657-01	2002	853	1122

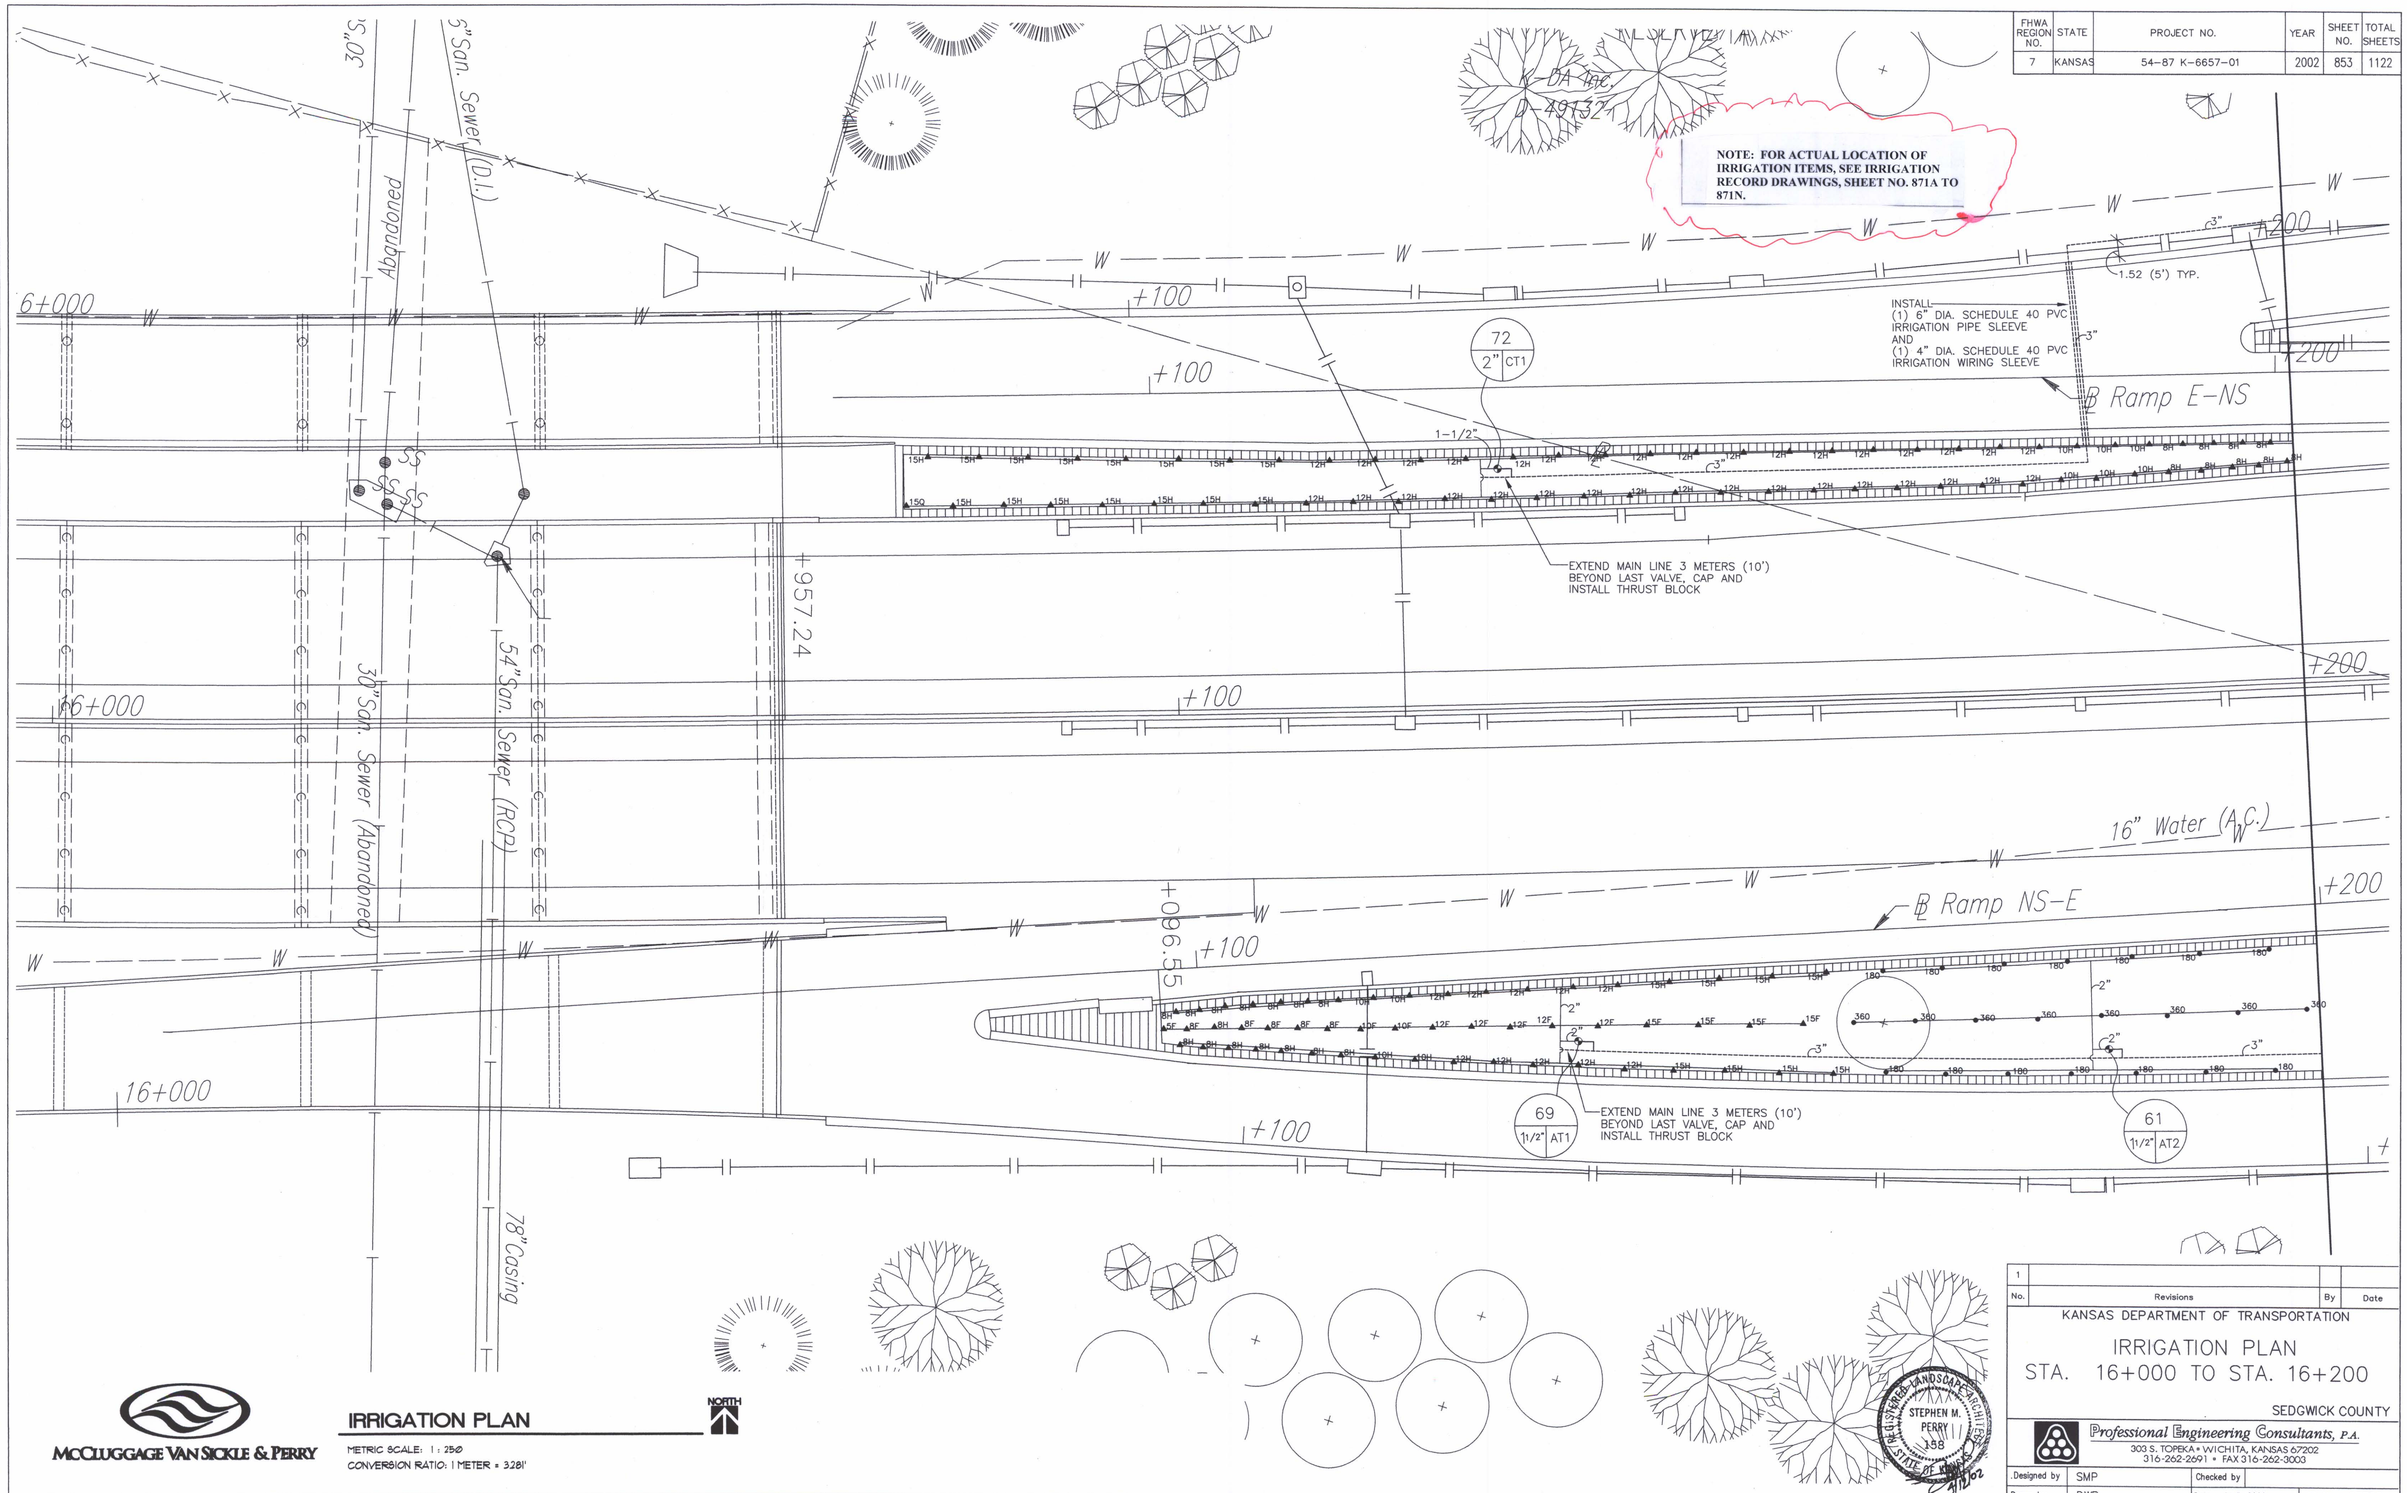

No.	Revisions	By	Date
1			

KANSAS DEPARTMENT OF TRANSPORTATION

IRRIGATION PLAN
STA. 16+000 TO STA. 16+200

SEDGWICK COUNTY

McCLUGGAGE VAN SICKLE & PERRY

IRRIGATION PLAN

METRIC SCALE: 1 : 250
CONVERSION RATIO: 1 METER = 3.281'

Professional Engineering Consultants, P.A.
303 S. TOPEKA • WICHITA, KANSAS 67202
316-262-2691 • FAX 316-262-3003

REGISTERED LANDSCAPE ARCHITECT STEPHEN M. PERRY 158 STATE OF KANSAS
4/12/02

Designed by	SMP	Checked by	
Drawn by	DWR	Date April, 2002	Job No. 97362

REFERENCES NOTED	BY	DATE
REFERENCES CHECKED		

DSNR: F:/9934/IS158 OPER: DWR SCALE: 1:500