


FHWA REGION NO.	STATE	PROJECT NO.	YEAR	SHEET NO.	TOTAL SHEETS
7	KANSAS	54-87 K-6657-01	2002	861	1122

NOTE: FOR ACTUAL LOCATION OF IRRIGATION ITEMS, SEE IRRIGATION RECORD DRAWINGS, SHEET NO. 871A TO 871N.

DATE	
BY	
REFERENCES NOTED	
REFERENCES CHECKED	

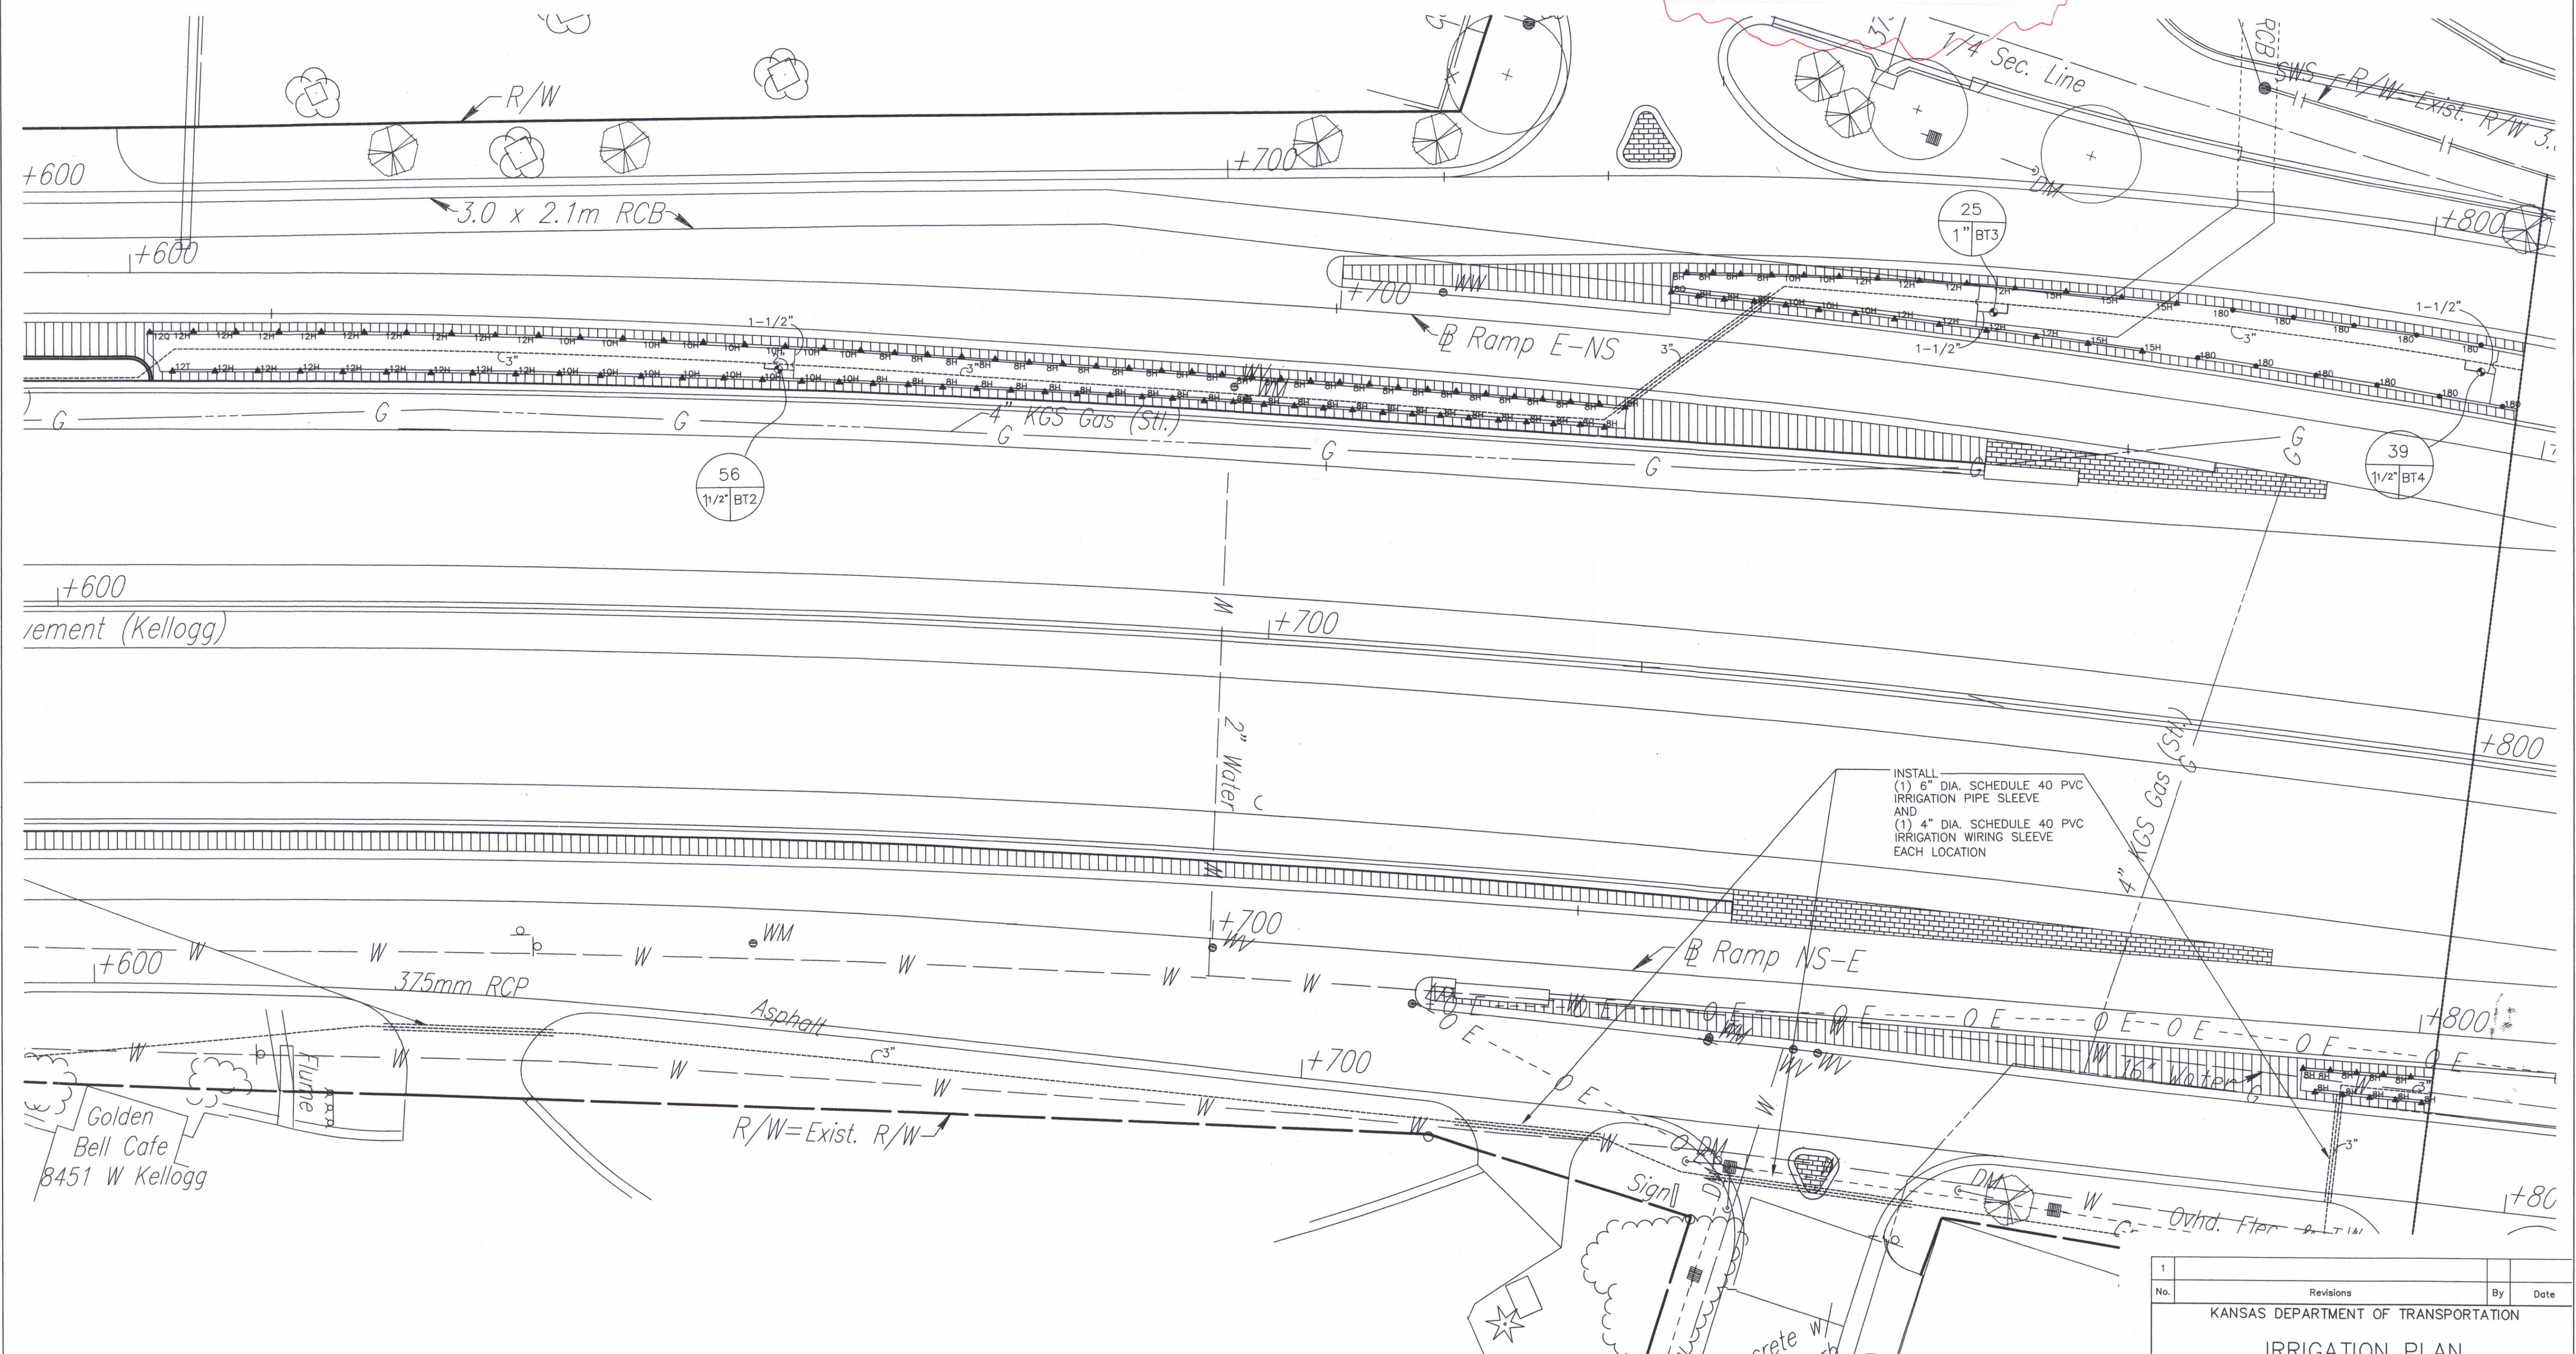


INSTALL
 (1) 6" DIA. SCHEDULE 40 PVC IRRIGATION PIPE SLEEVE
 AND
 (1) 4" DIA. SCHEDULE 40 PVC IRRIGATION WIRING SLEEVE
 EACH LOCATION

Golden Bell Cafe
 8451 W Kellogg



IRRIGATION PLAN

METRIC SCALE: 1 : 250
 CONVERSION RATIO: 1 METER = 3.281'

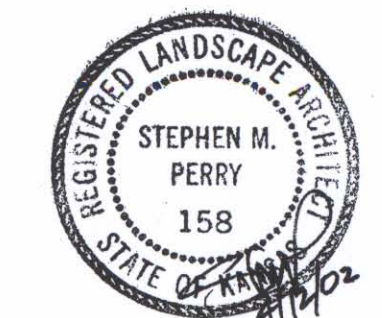

1	Revisions	By	Date
KANSAS DEPARTMENT OF TRANSPORTATION			
IRRIGATION PLAN STA. 17+600 TO STA. 17+800			
SEDGWICK COUNTY			
Professional Engineering Consultants, P.A.			
303 S. TOPEKA • WICHITA, KANSAS 67202 316-262-2691 • FAX 316-262-3003			
Designed by	SMP	Checked by	
Drawn by	DWR	Date April, 2002	Job No. 97362

DSNR: OPER: DWR SCALE: 1:500
 F: 9934/IS174