


DATE	
BY	
REFERENCES NOTED	
REFERENCES CHECKED	

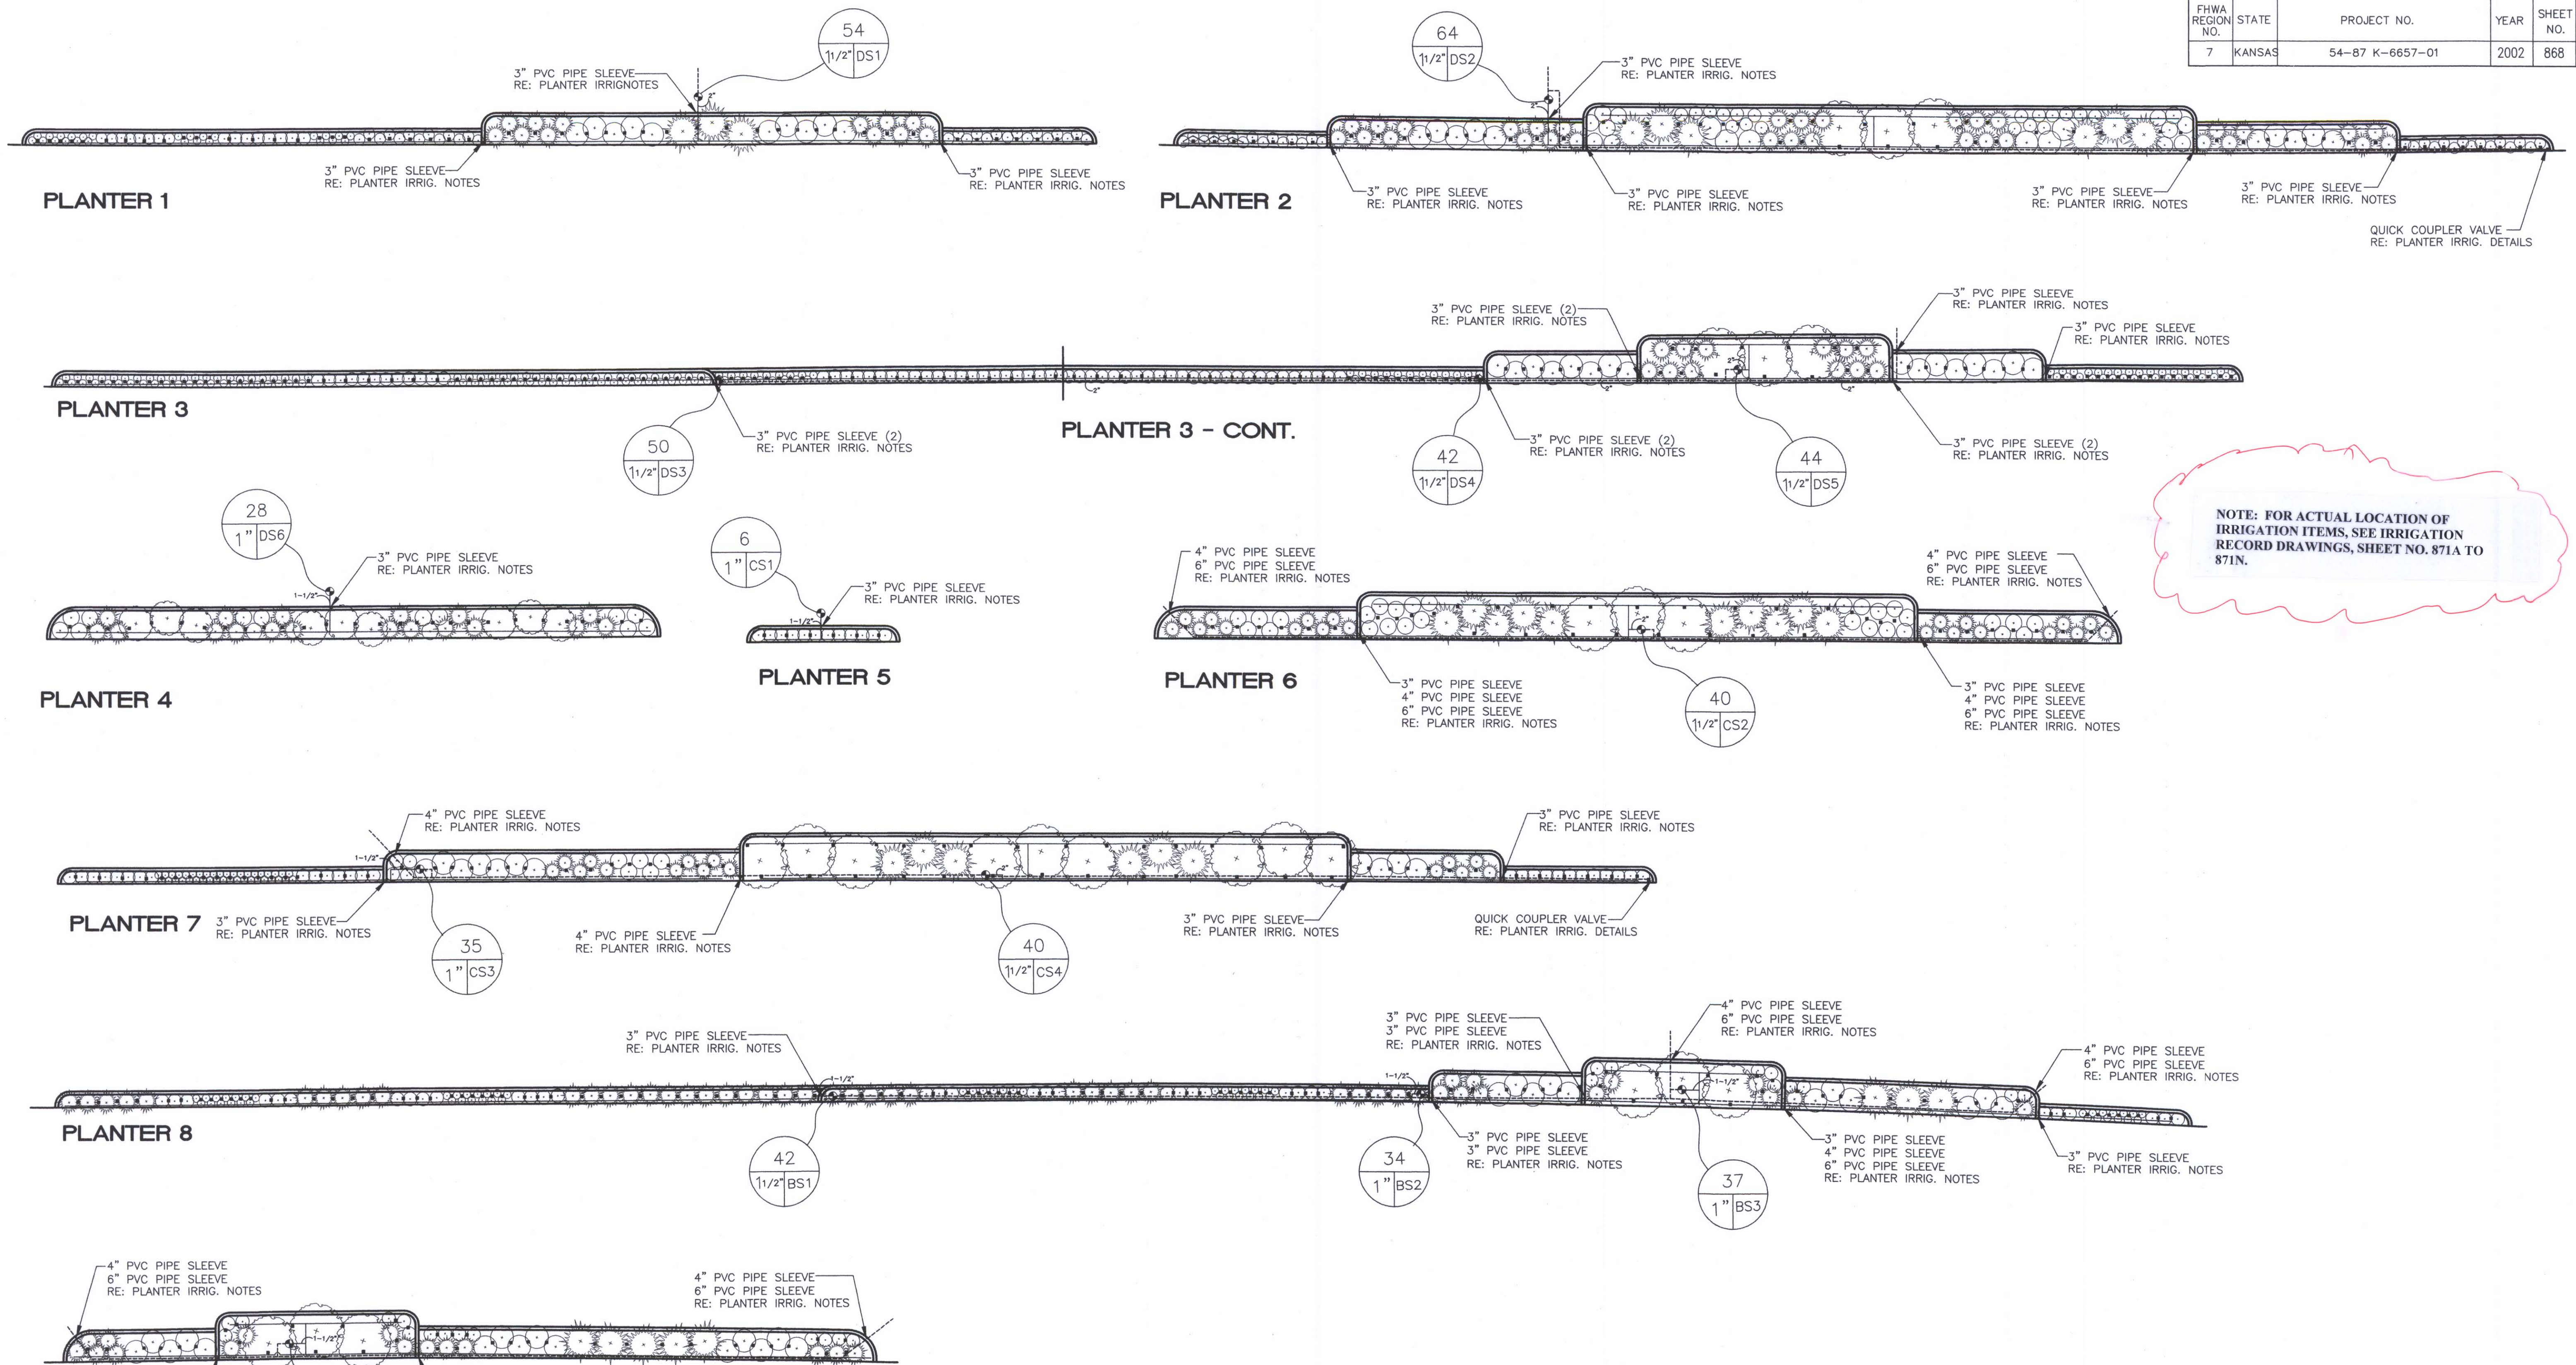

NOTE: FOR ACTUAL LOCATION OF IRRIGATION ITEMS, SEE IRRIGATION RECORD DRAWINGS, SHEET NO. 871A TO 871N.

DSNR: F/9934/15146 BY:DWR
 OPER: DWR
 SCALE: 1:500




PLANTER IRRIGATION PLANS

METRIC SCALE: 1:200
 CONVERSION RATIO: 1 METER = 3281'

LEGEND

- TORO 570Z 12" POP UP W/TORO PRESSURE COMPENSATING FLOOD BUBBLER SET AT 1 GPM
- IRRIGATION VALVE
- LATERAL LINE
- - - - - MAIN LINE

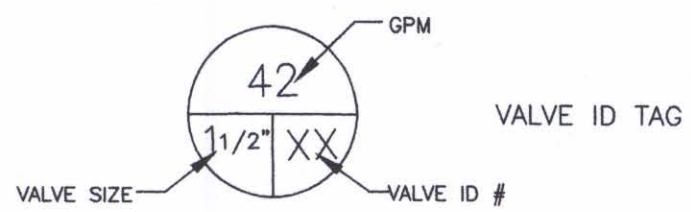

NOTES:

1. LANDSCAPE INDICATED IS FOR REFERENCE ONLY REFERENCE PLANTER LANDSCAPE PLANS FOR EXACT LOCATIONS.
2. ALL PIPE SLEEVES INTO PLANTERS SHALL BE LOCATED 18" MINIMUM BELOW ADJACENT GRADE. ALL PIPE SLEEVES WITHIN PLANTERS SHALL BE LOCATED 24" BELOW THE TOP OF THE SHORTEST ADJACENT PLANTER.
3. ALL IRRIGATION PIPE WITHIN PLANTERS SHALL BE INSTALLED 18" BELOW TOP OF SOIL.
4. IRRIGATION CONTRACTOR SHALL VERIFY ALL SLEEVES SIZES AND NUMBER OF SLEEVES TO PROVIDE.
5. QUICK COUPLER VALVES SHALL BE INSTALLED ON MAIN LINE AND ACTIVE AT ALL TIMES.



1			
No.	Revisions	By	Date
CITY OF WICHITA			
PLANTER IRRIGATION PLANS			
SEDGWICK COUNTY			
 Professional Engineering Consultants, P.A. 303 S. TOPKA • WICHITA, KANSAS 67202 316-262-2691 • FAX 316-262-3003			
Designed by	SMP	Checked by	
Drawn by	DWR	Date	April, 2002
		Job No.	97362