


DATE	
REFERENCES NOTED	
REFERENCES CHECKED	

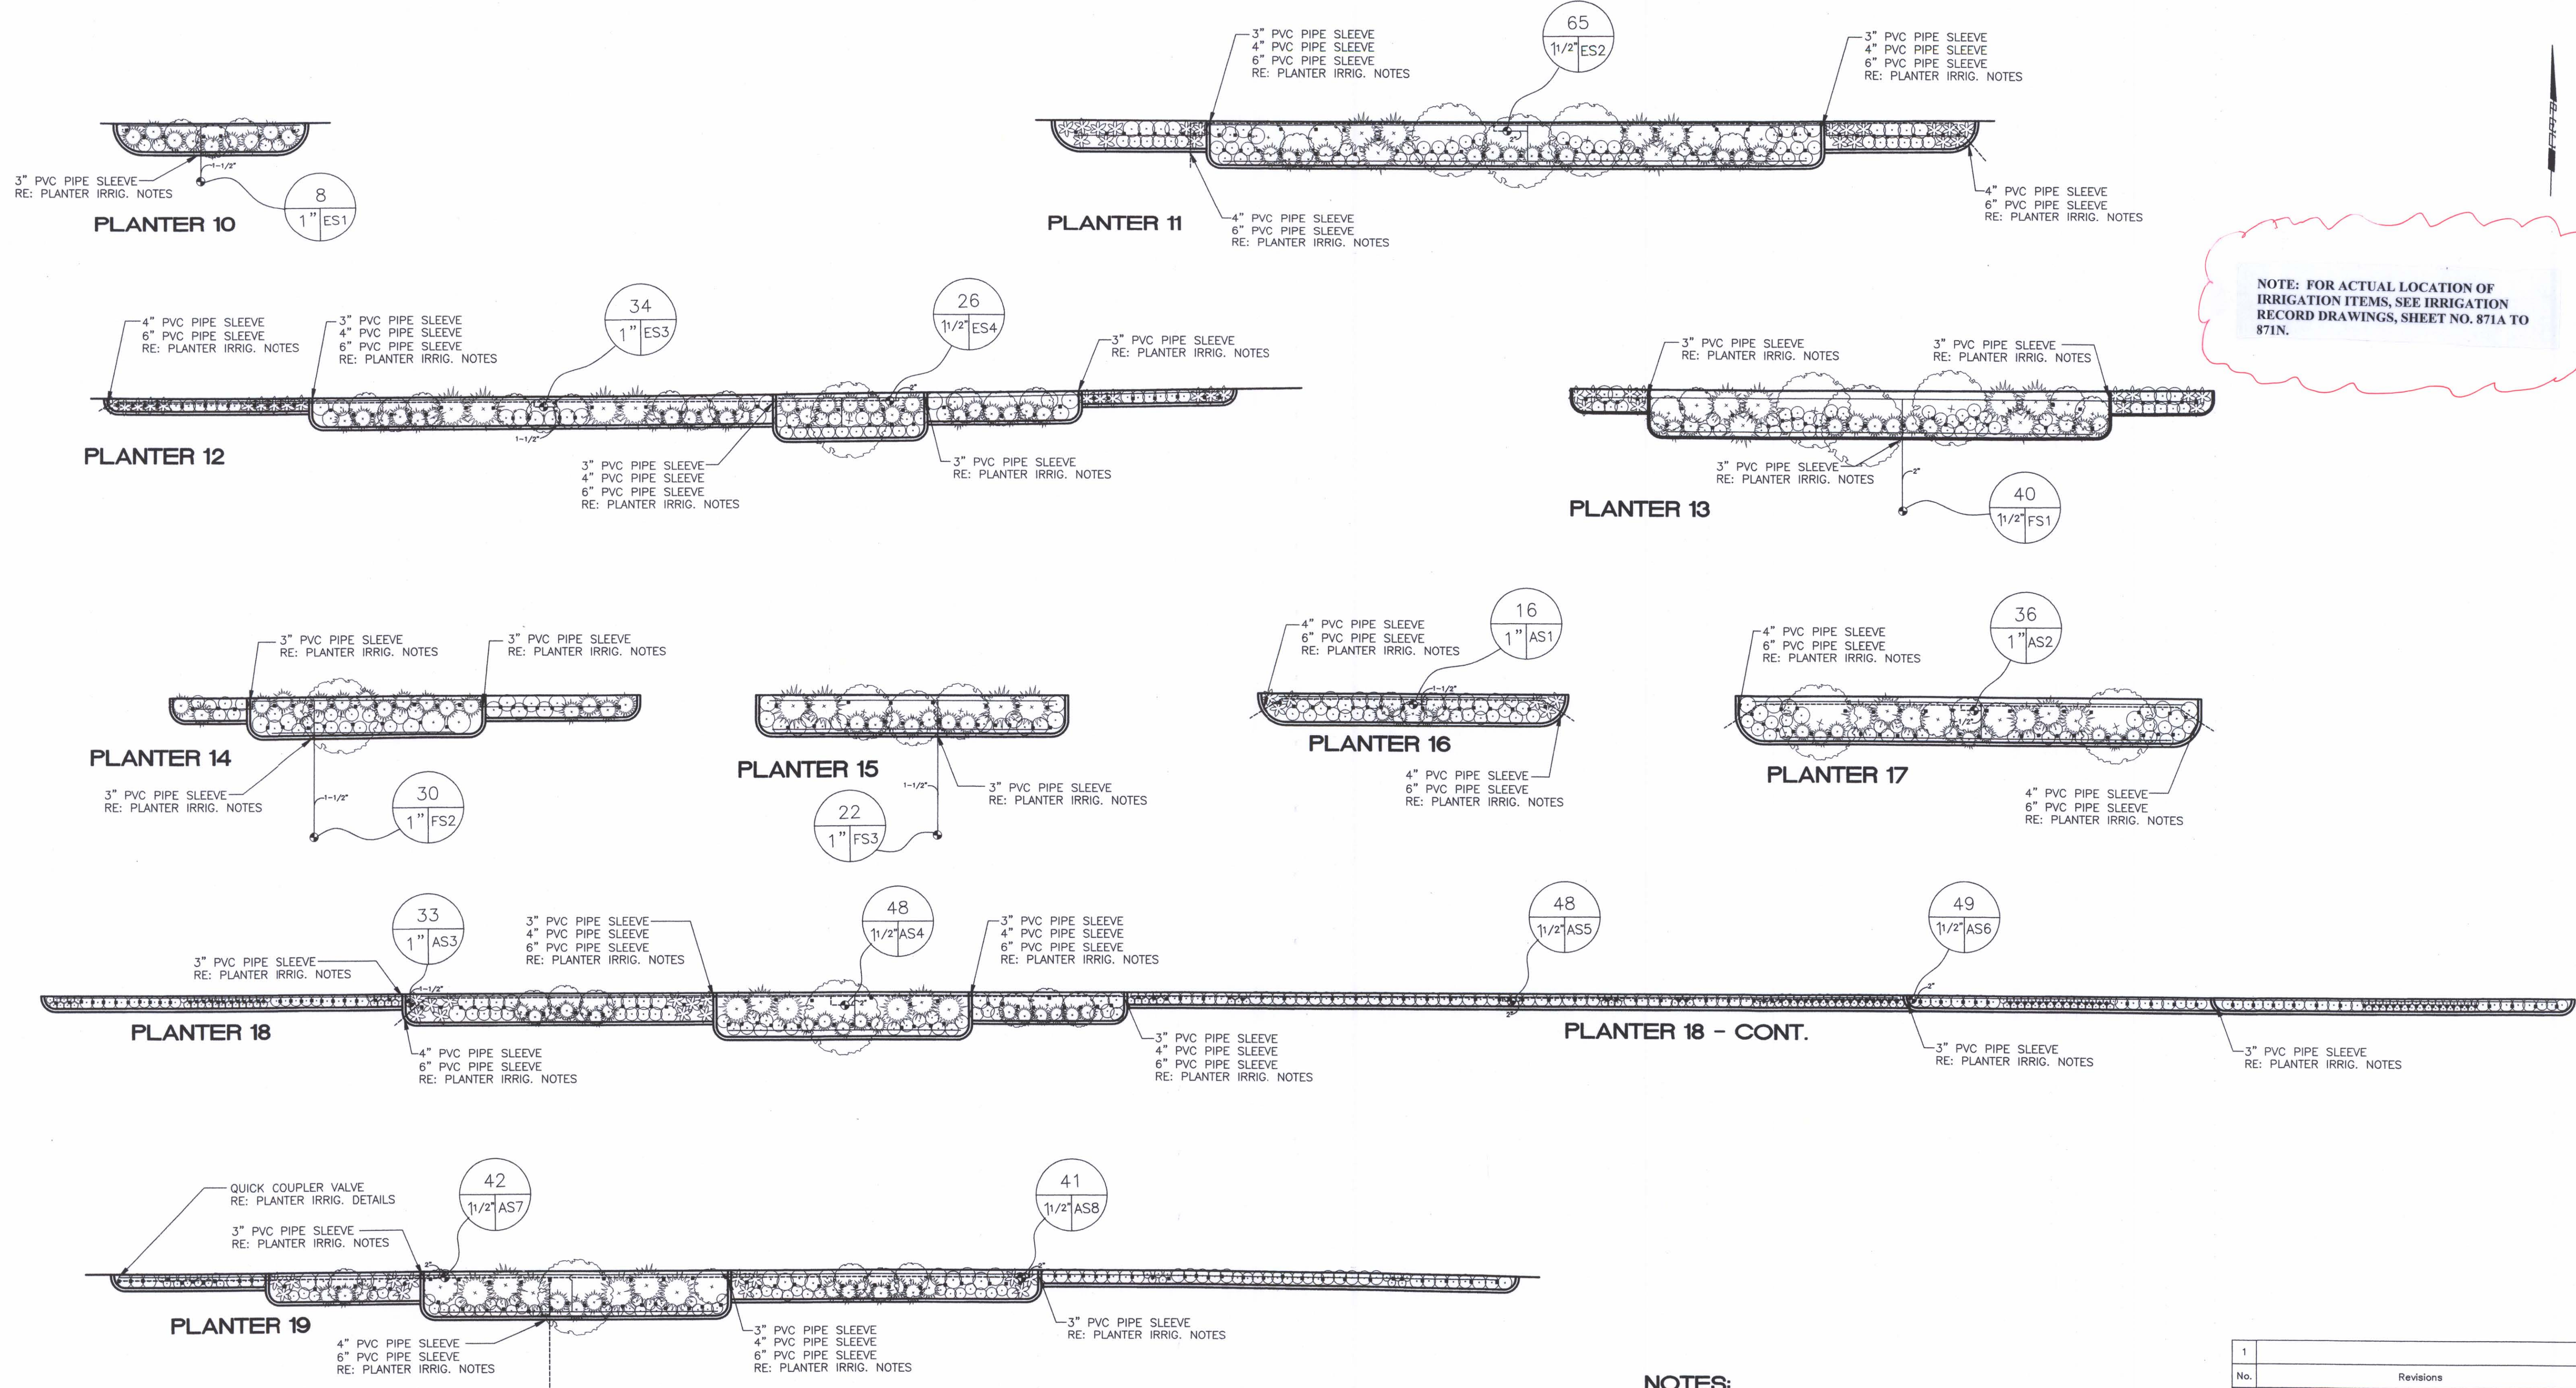

**NOTE: FOR ACTUAL LOCATION OF IRRIGATION ITEMS, SEE IRRIGATION RECORD DRAWINGS, SHEET NO. 871A TO 871N.**

DSNR: OPER: DWR SCALE: 1:500  
 F:19934/15146 BY:DWR




**PLANTER IRRIGATION PLANS**

METRIC SCALE: 1:200  
 CONVERSION RATIO: 1 METER = 3281'


**LEGEND**

- TORO 570Z 12" POP UP W/TORO PRESSURE COMPENSATING FLOOD BUBBLER SET AT 1 GPM
- IRRIGATION VALVE
- LATERAL LINE
- - - MAIN LINE

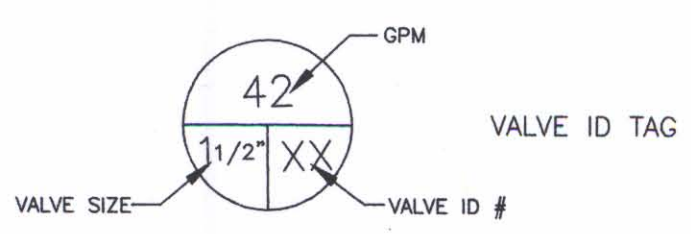

**NOTES:**

- LANDSCAPE INDICATED IS FOR REFERENCE ONLY REFERENCE PLANTER LANDSCAPE PLANS FOR EXACT LOCATIONS.
- ALL PIPE SLEEVES INTO PLANTERS SHALL BE LOCATED 18" MINIMUM BELOW ADJACENT GRADE. ALL PIPE SLEEVES WITHIN PLANTERS SHALL BE LOCATED 24" BELOW THE TOP OF THE SHORTEST ADJACENT PLANTER.
- ALL IRRIGATION PIPE WITHIN PLANTERS SHALL BE INSTALLED 18" BELOW TOP OF SOIL.
- IRRIGATION CONTRACTOR SHALL VERIFY ALL SLEEVES SIZES AND NUMBER OF SLEEVES TO PROVIDE.
- QUICK COUPLER VALVES SHALL BE INSTALLED ON MAIN LINE AND ACTIVE AT ALL TIMES.

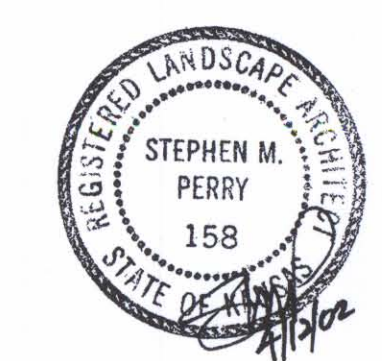

1			
No.	Revisions	By	Date
CITY OF WICHITA			
PLANTER IRRIGATION PLANS			
SEDGWICK COUNTY			
 <b>Professional Engineering Consultants, P.A.</b> 303 S. TOPEKA • WICHITA, KANSAS 67202 316-262-2691 • FAX 316-262-3003			
Designed by	SMP	Checked by	
Drawn by	DWR	Date	April, 2002
		Job No.	97362