FHWA REGION NO.	STATE	PROJECT NO.	YEAR	SHEET NO.	TOTAL SHEETS
7	KANSAS	54 - 87 K - 6657 - 01	2002	871N	1122

Symbol	Irrigation Equipment
	Toro 570Z 12" Pop-Up Series Spray Heads (1,038 Total)
	Toro 1" P-220 Electric Valves (18)
	Toro 1-1/2" P-220 Electric Valves (11)
	Toro 075-SLSC 473 Quick Couplers (3)
	PVC Laterals (Colors & Sizes Vary Per Zone)

Note: Actual number of sprinkler heads may vary from plan data.

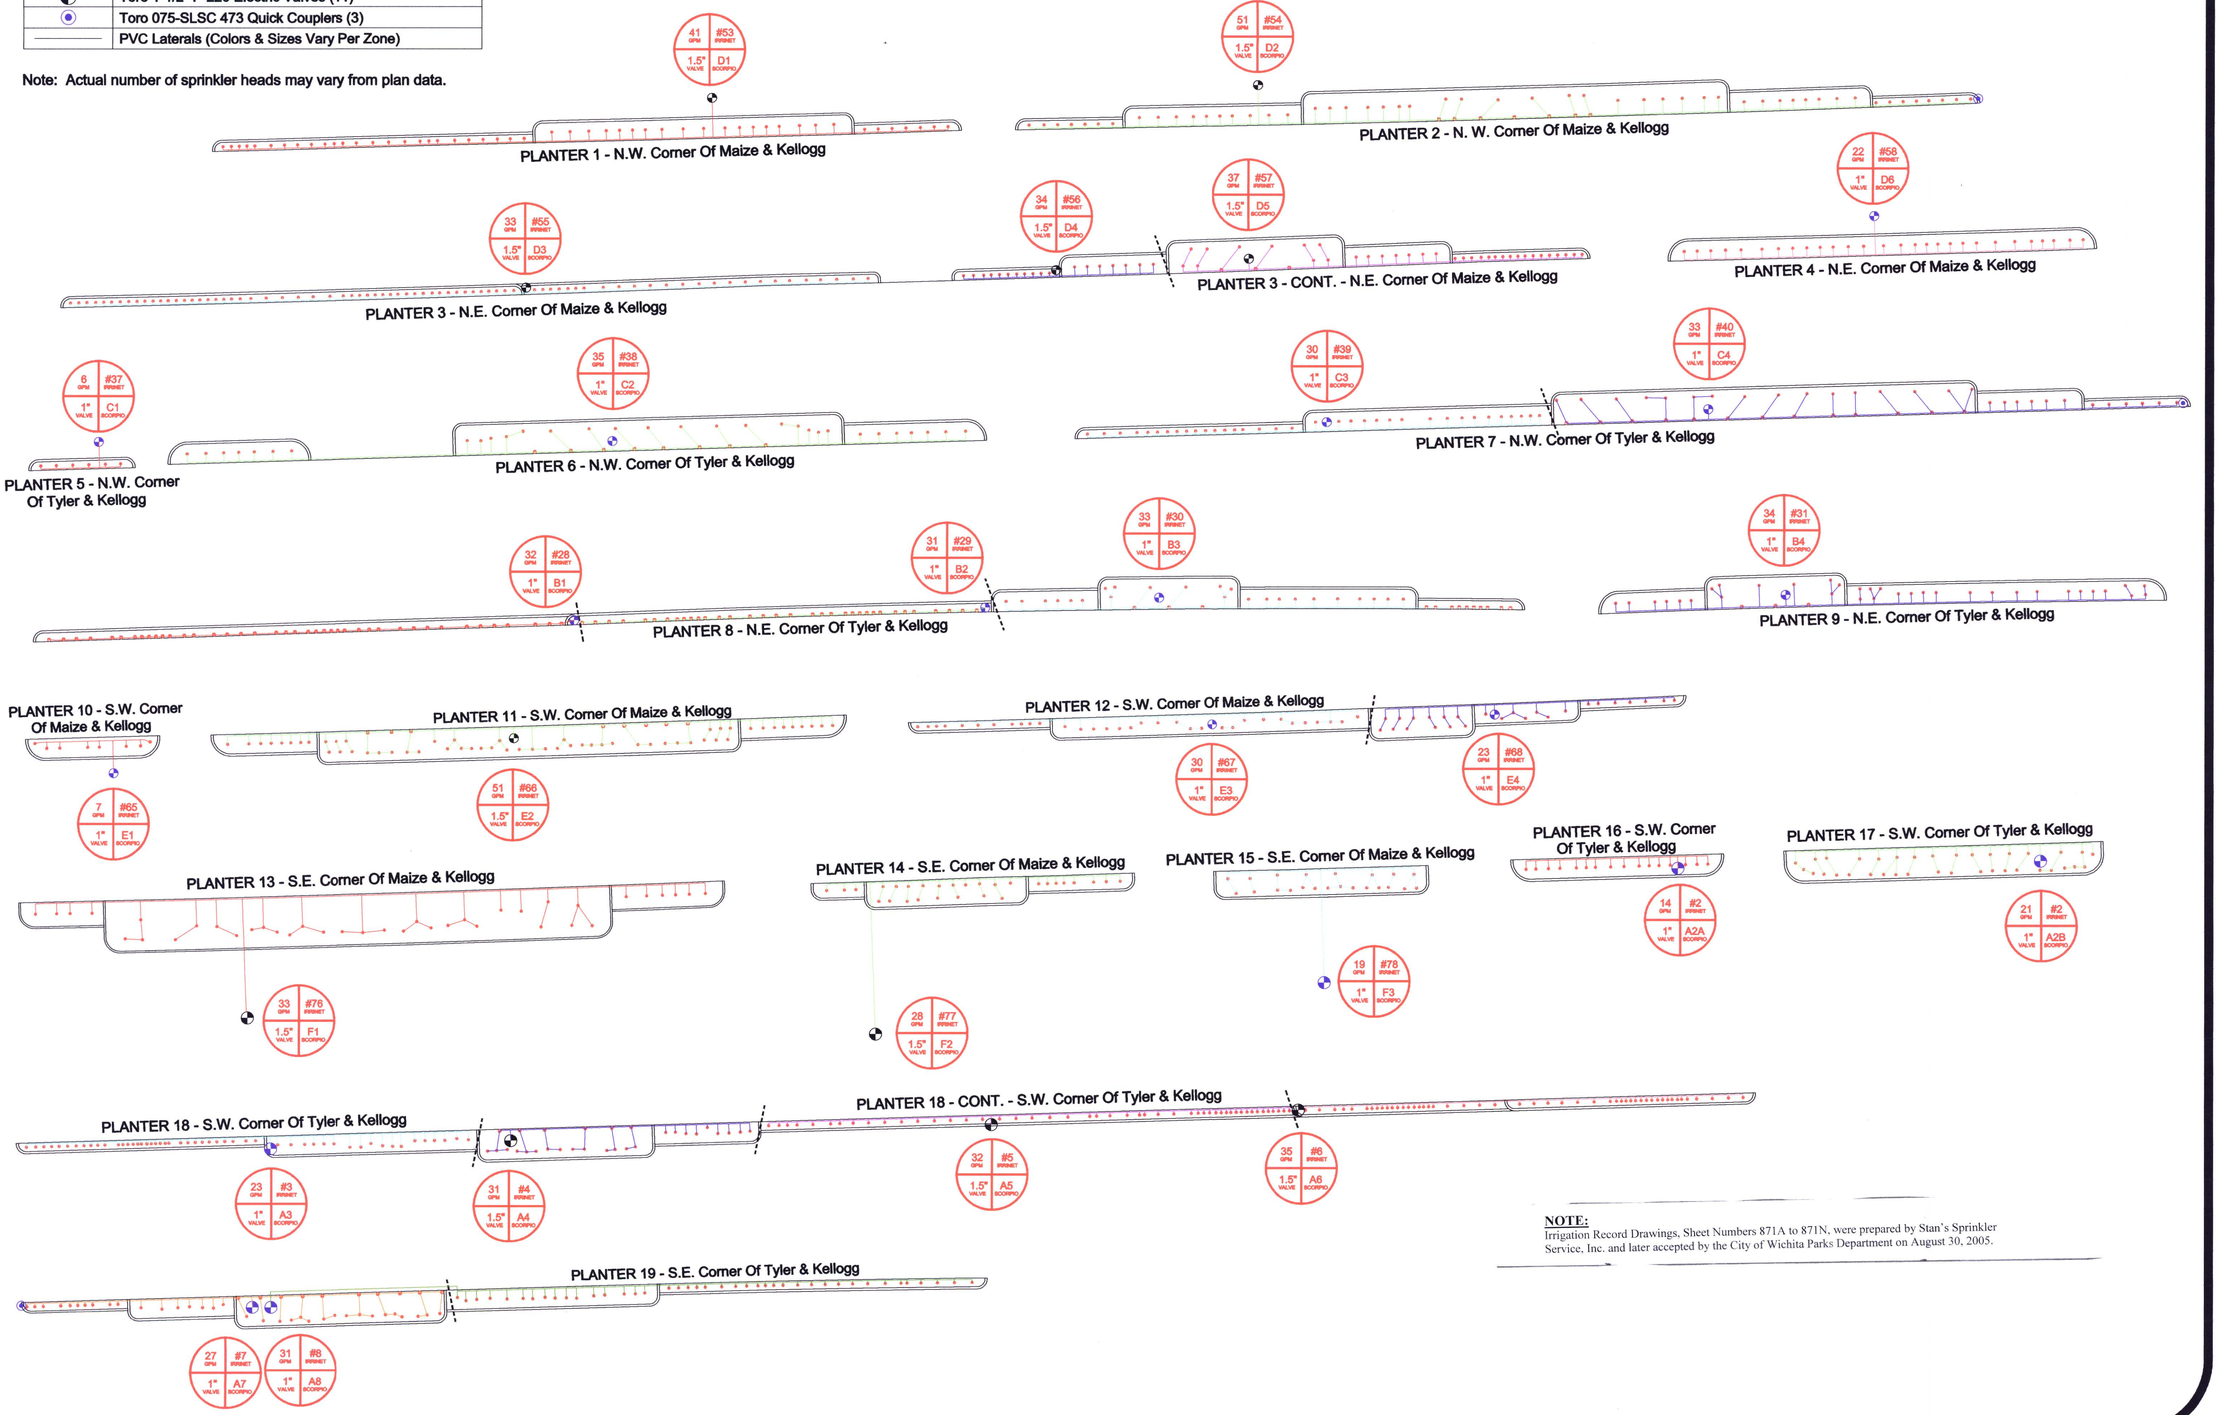

NOTE:
Irrigation Record Drawings, Sheet Numbers 871A to 871N, were prepared by Stan's Sprinkler Service, Inc. and later accepted by the City of Wichita Parks Department on August 30, 2005.

License #: 1840

RECEIVED
AUG 30 2005
P. E. C.
FIELD OFFICE
3rd Draft

Irrigation As-Built

Project: West Kellogg Flyover: Maize To Tyler - Shrub Areas

Drawn By: P.P.

Checked By: D.D.

Scale: 1"=20'

Date: 8/29/05