



FHWA REGION NO.	STATE	PROJECT NO.	YEAR	SHEET NO.	TOTAL SHEETS
7	KANSAS	54-87 K-6657-01	2002	878	1122

DATE	
BY	
REFERENCES NOTED	
REFERENCES CHECKED	

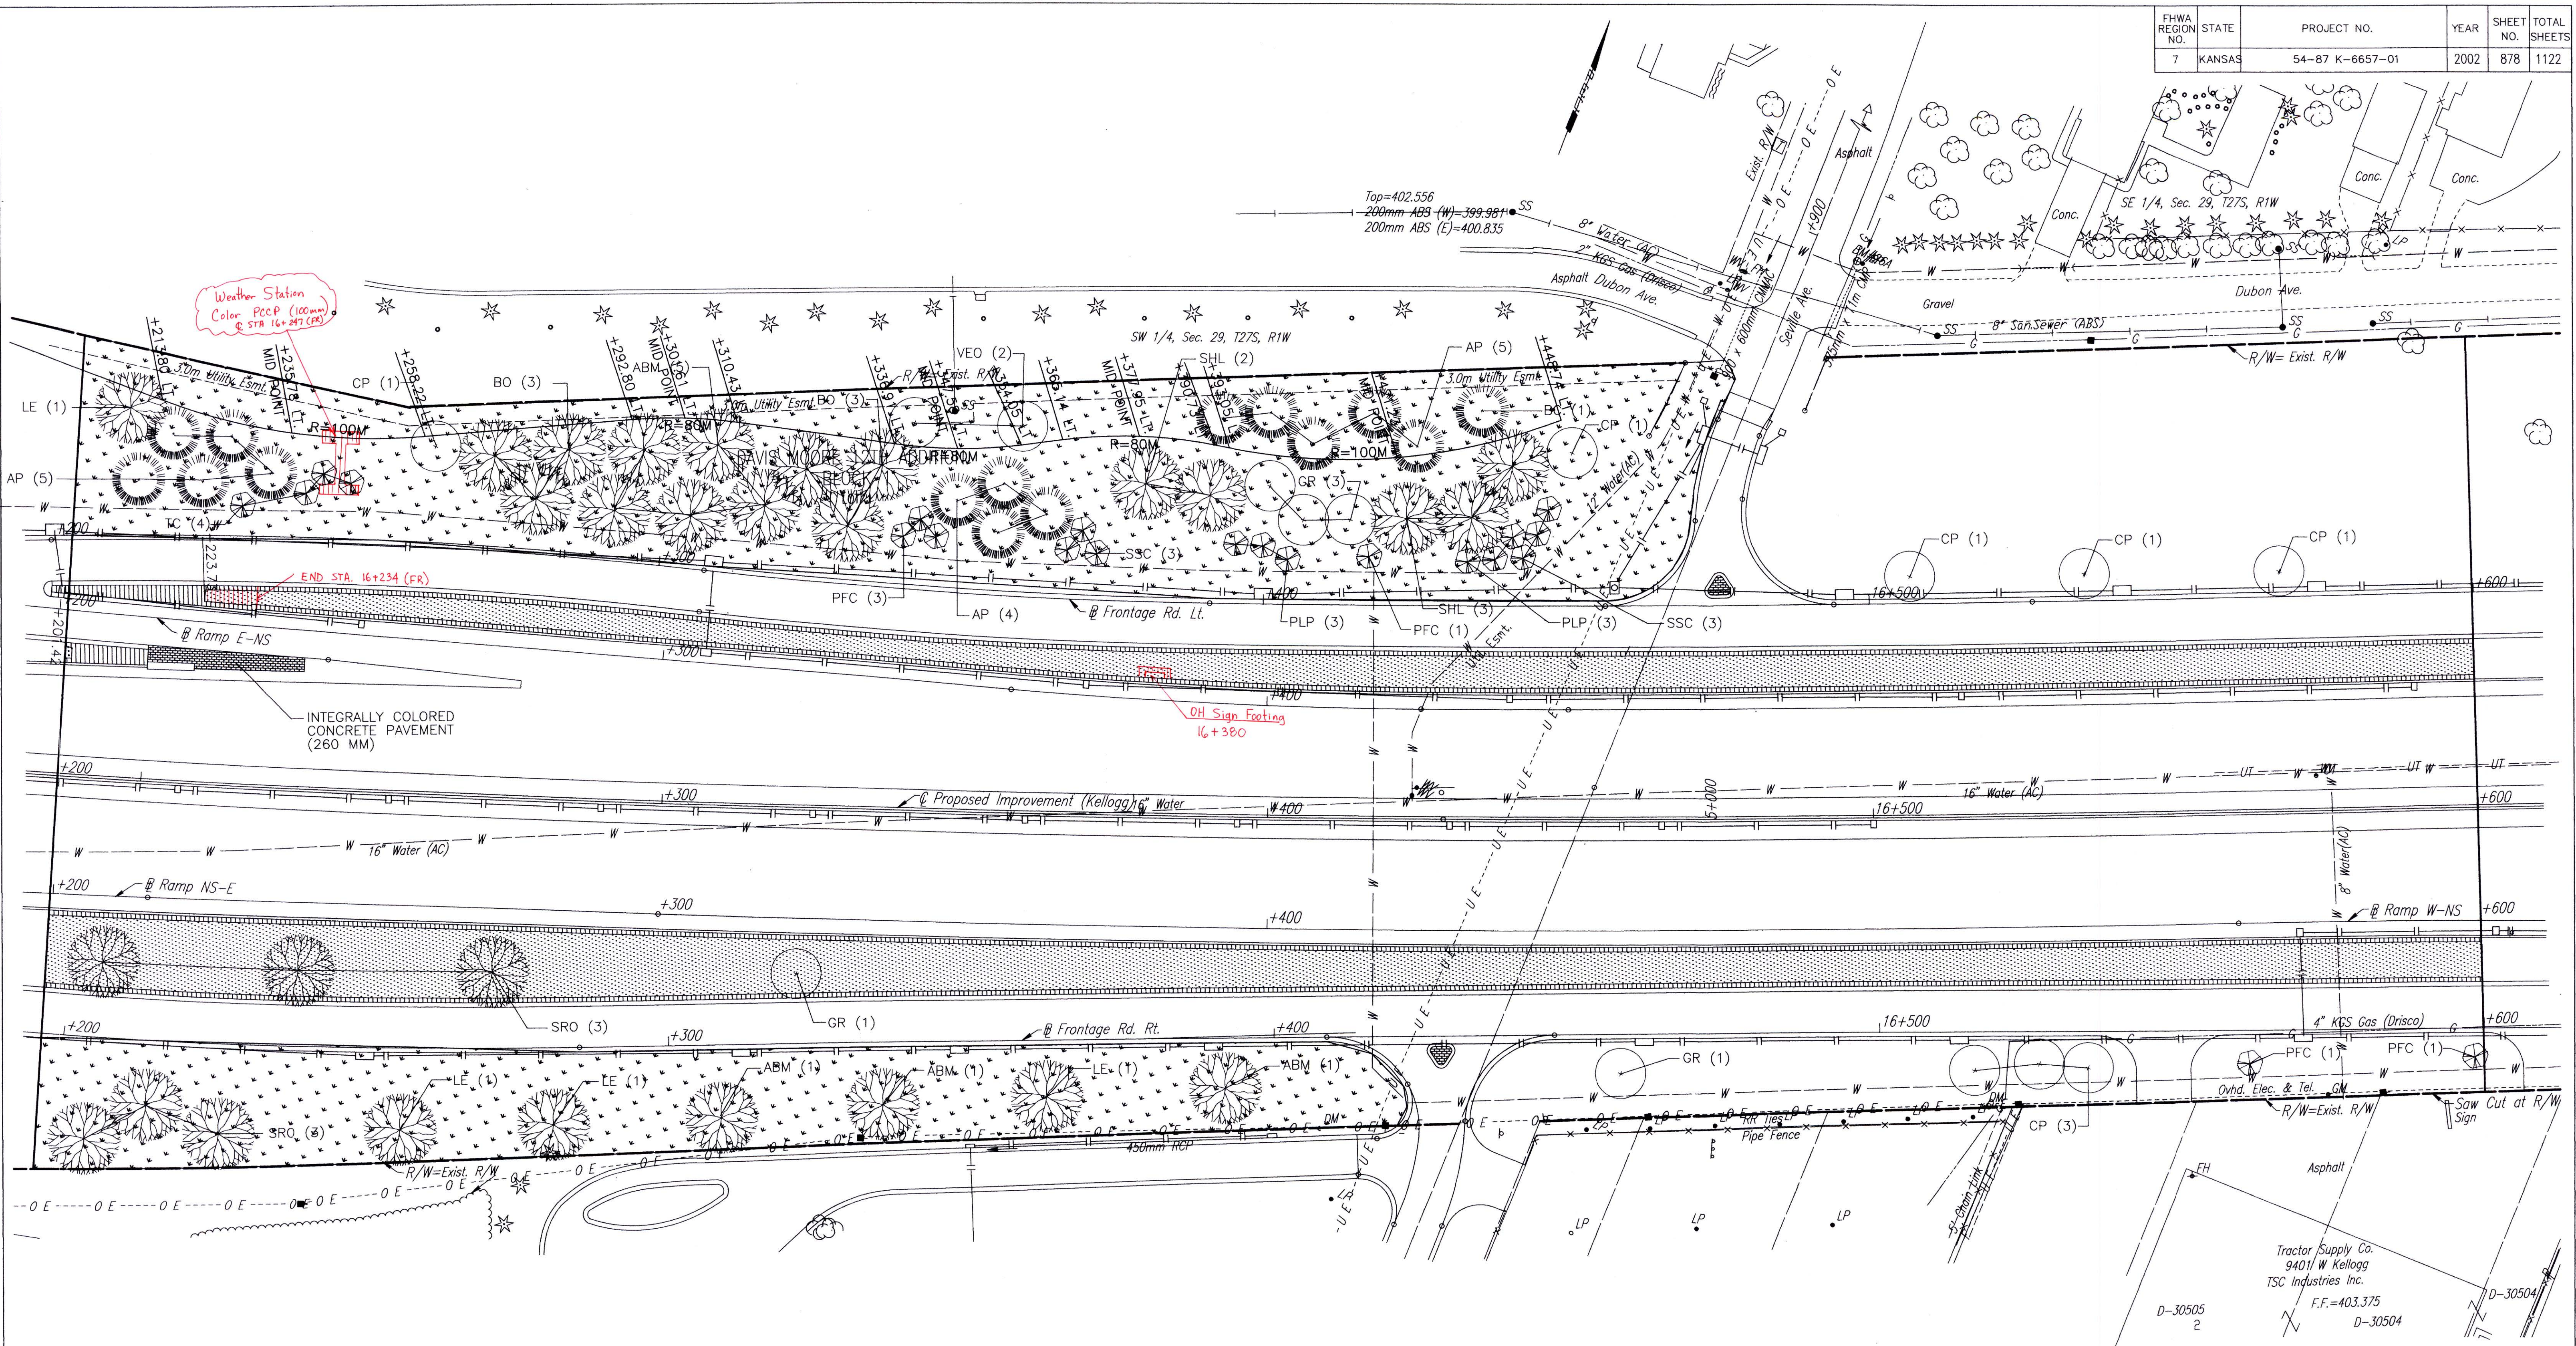

DSNR: F/9934/162  
 OPER: DWR  
 SCALE: 1:500

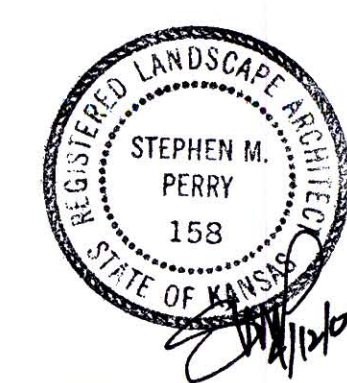

1			
No.	Revisions	By	Date
CITY OF WICHITA			
LANDSCAPE PLAN			
STA. 16+200 TO STA. 16+600			
SEDGWICK COUNTY			
Tractor Supply Co. 9401 W Kellogg TSC Industries Inc. F.F. = 403.375 D-30504			
Designed by	SMP	Checked by	
Drawn by	DWR	Date	April, 2002
		Job No.	97362