



FHWA REGION NO.	STATE	PROJECT NO.	YEAR	SHEET NO.	TOTAL SHEETS
7	KANSAS	54-87 K-6657-01	2002	878	1122

DATE	
BY	
REFERENCES NOTED	
REFERENCES CHECKED	

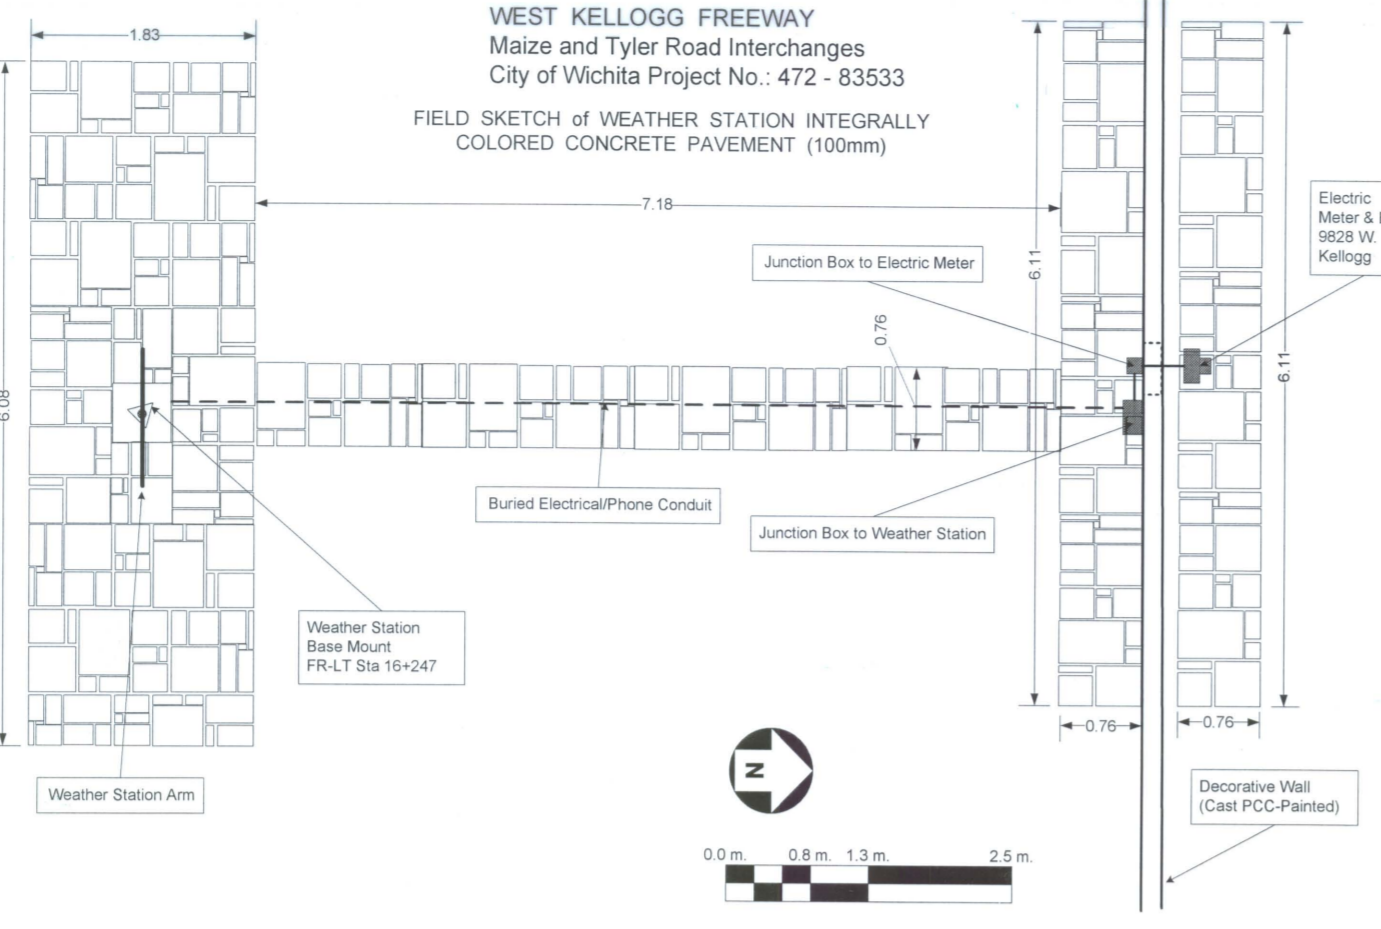


Added Color PCP (100mm) At Weather Station (FR-WB) Sta. 16+247

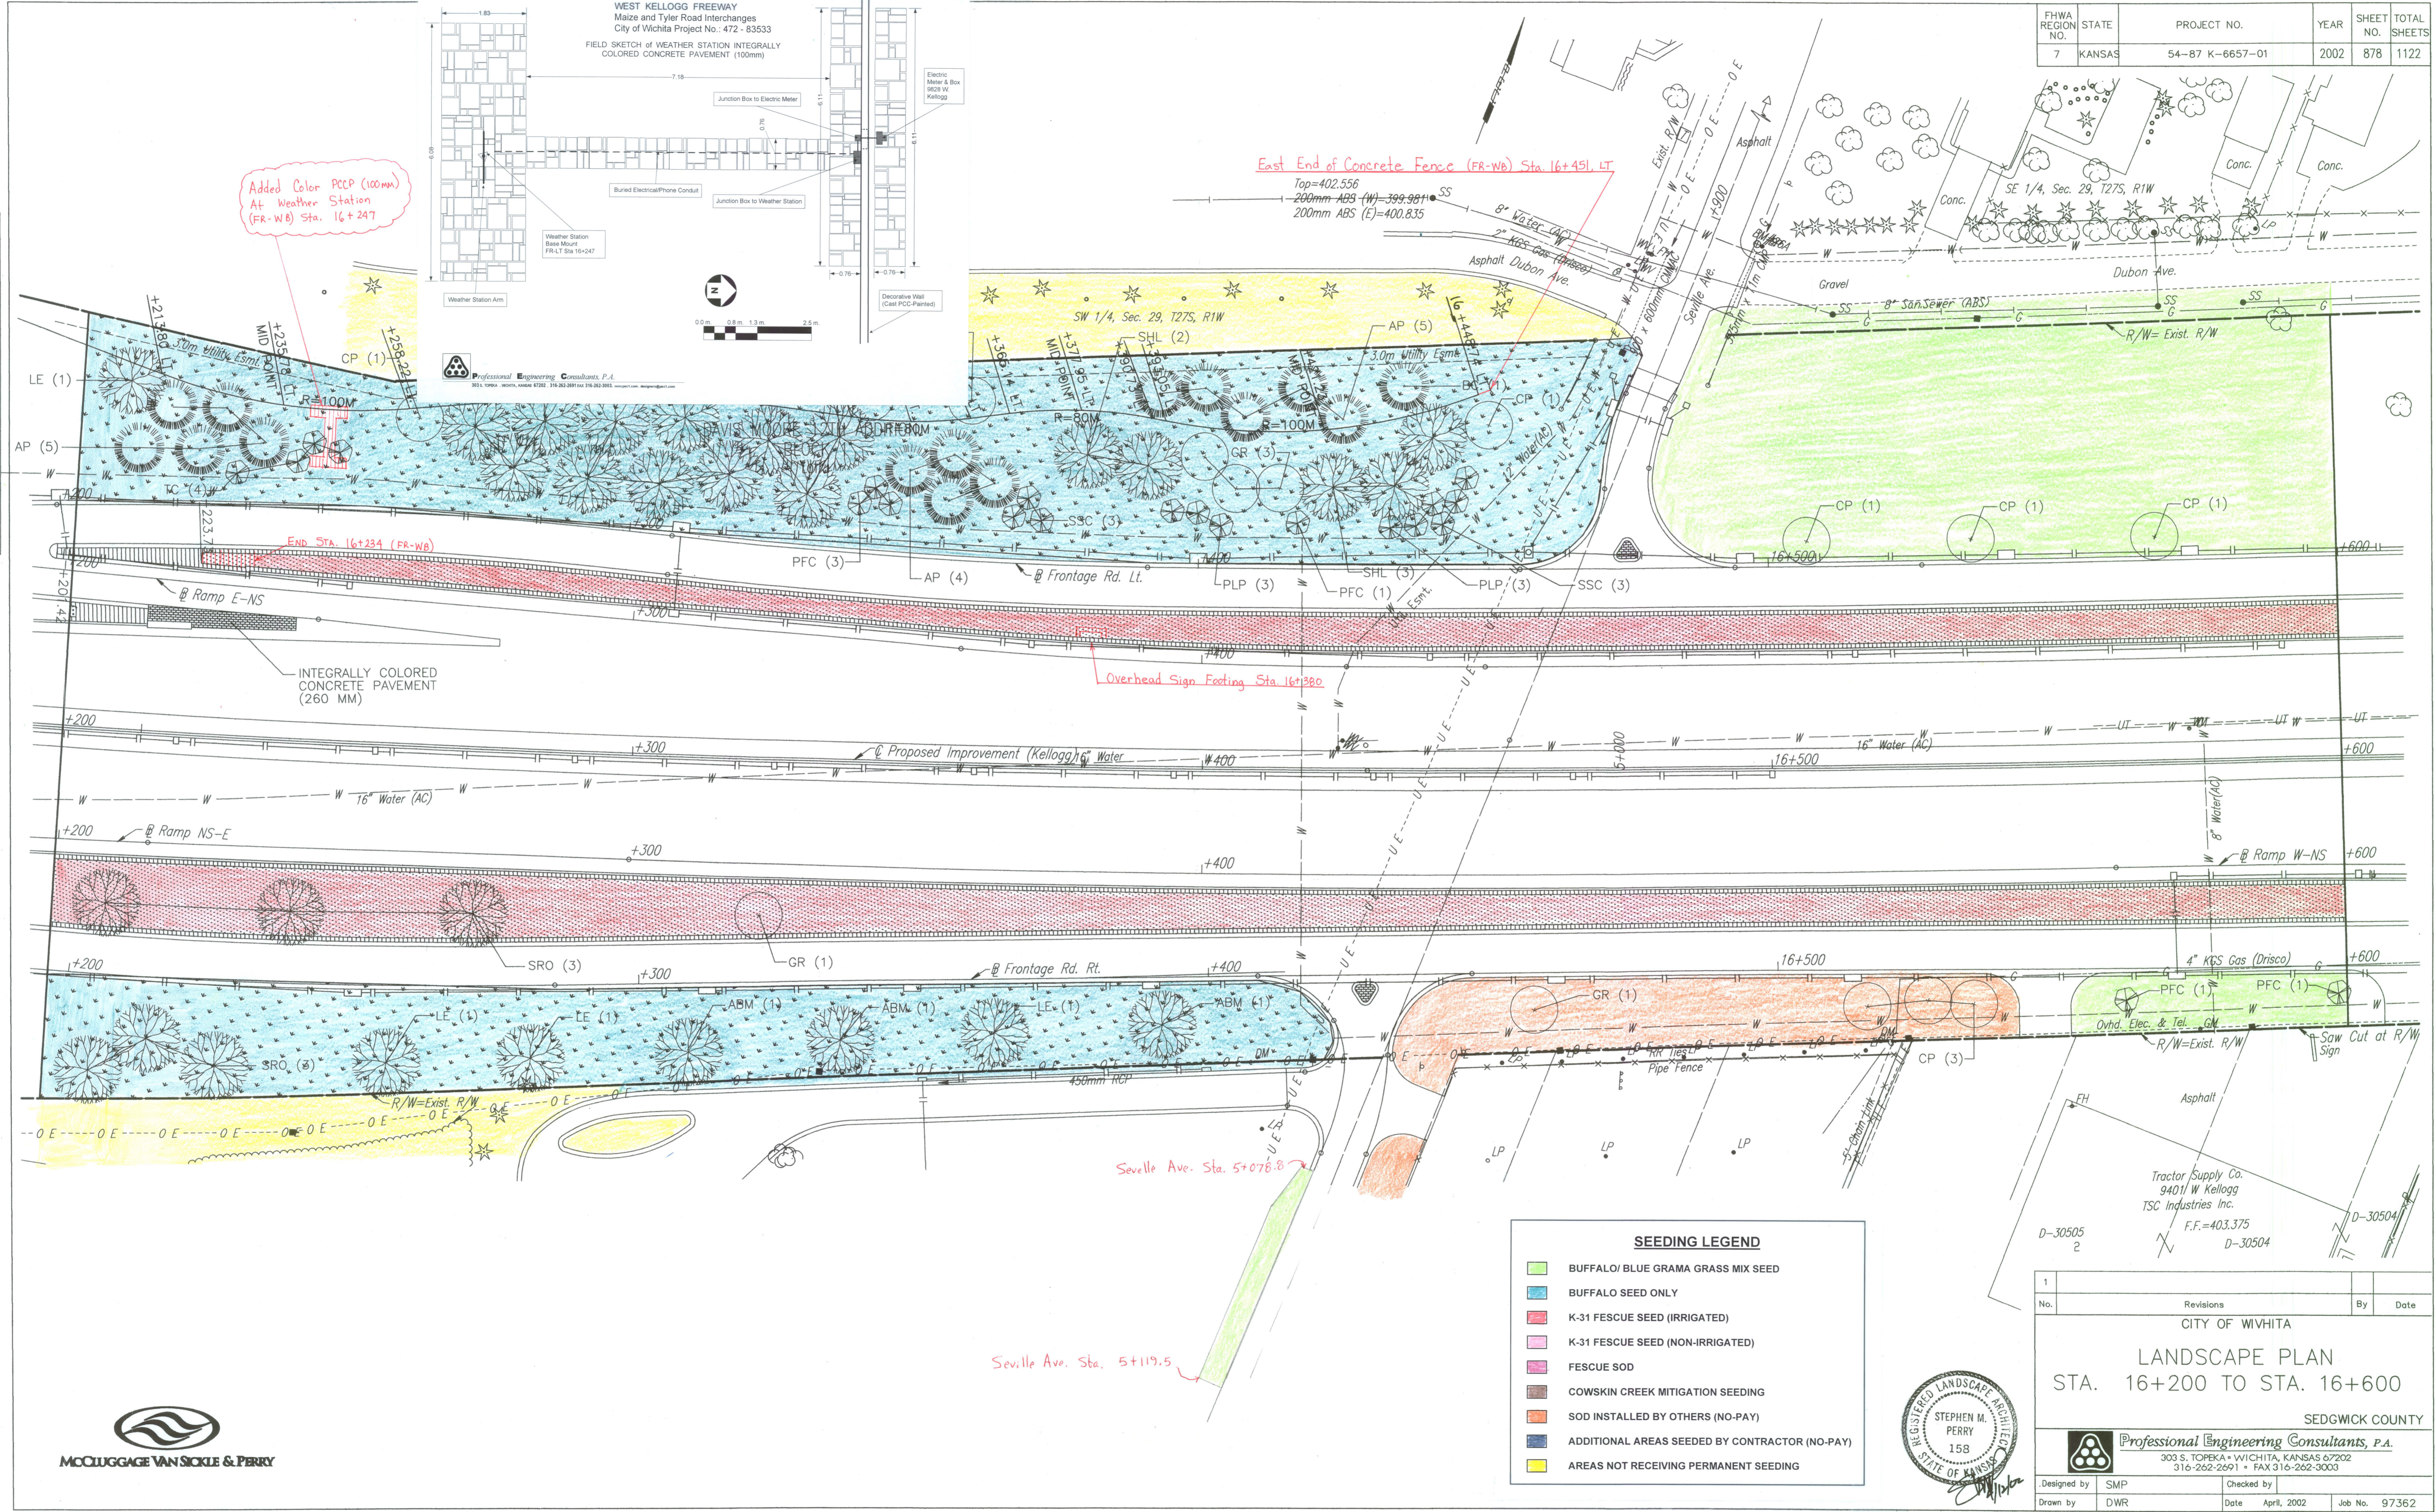

SEEDING LEGEND

- BUFFALO/ BLUE GRAMA GRASS MIX SEED
- BUFFALO SEED ONLY
- K-31 FESCUE SEED (IRRIGATED)
- K-31 FESCUE SEED (NON-IRRIGATED)
- FESCUE SOD
- COWSKIN CREEK MITIGATION SEEDING
- SOD INSTALLED BY OTHERS (NO-PAY)
- ADDITIONAL AREAS SEEDDED BY CONTRACTOR (NO-PAY)
- AREAS NOT RECEIVING PERMANENT SEEDING

1			
No.	Revisions	By	Date
CITY OF WICHITA			
LANDSCAPE PLAN			
STA. 16+200 TO STA. 16+600			
SEDGWICK COUNTY			
Professional Engineering Consultants, P.A.			
303 S. TOPEKA • WICHITA, KANSAS 67202 316-262-2691 • FAX 316-262-3003			
Designed by	SMP	Checked by	
Drawn by	DWR	Date	April, 2002
		Job No.	97362

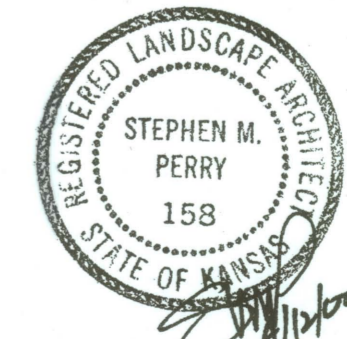

DSWR: OPER: DWR SCALE: 1:500 F: 9934/162