


FHWA REGION NO.	STATE	PROJECT NO.	YEAR	SHEET NO.	TOTAL SHEETS
7	KANSAS	54-87 K-6657-01	2002	879	1122

DATE	
BY	
REFERENCES NOTED	
REFERENCES CHECKED	

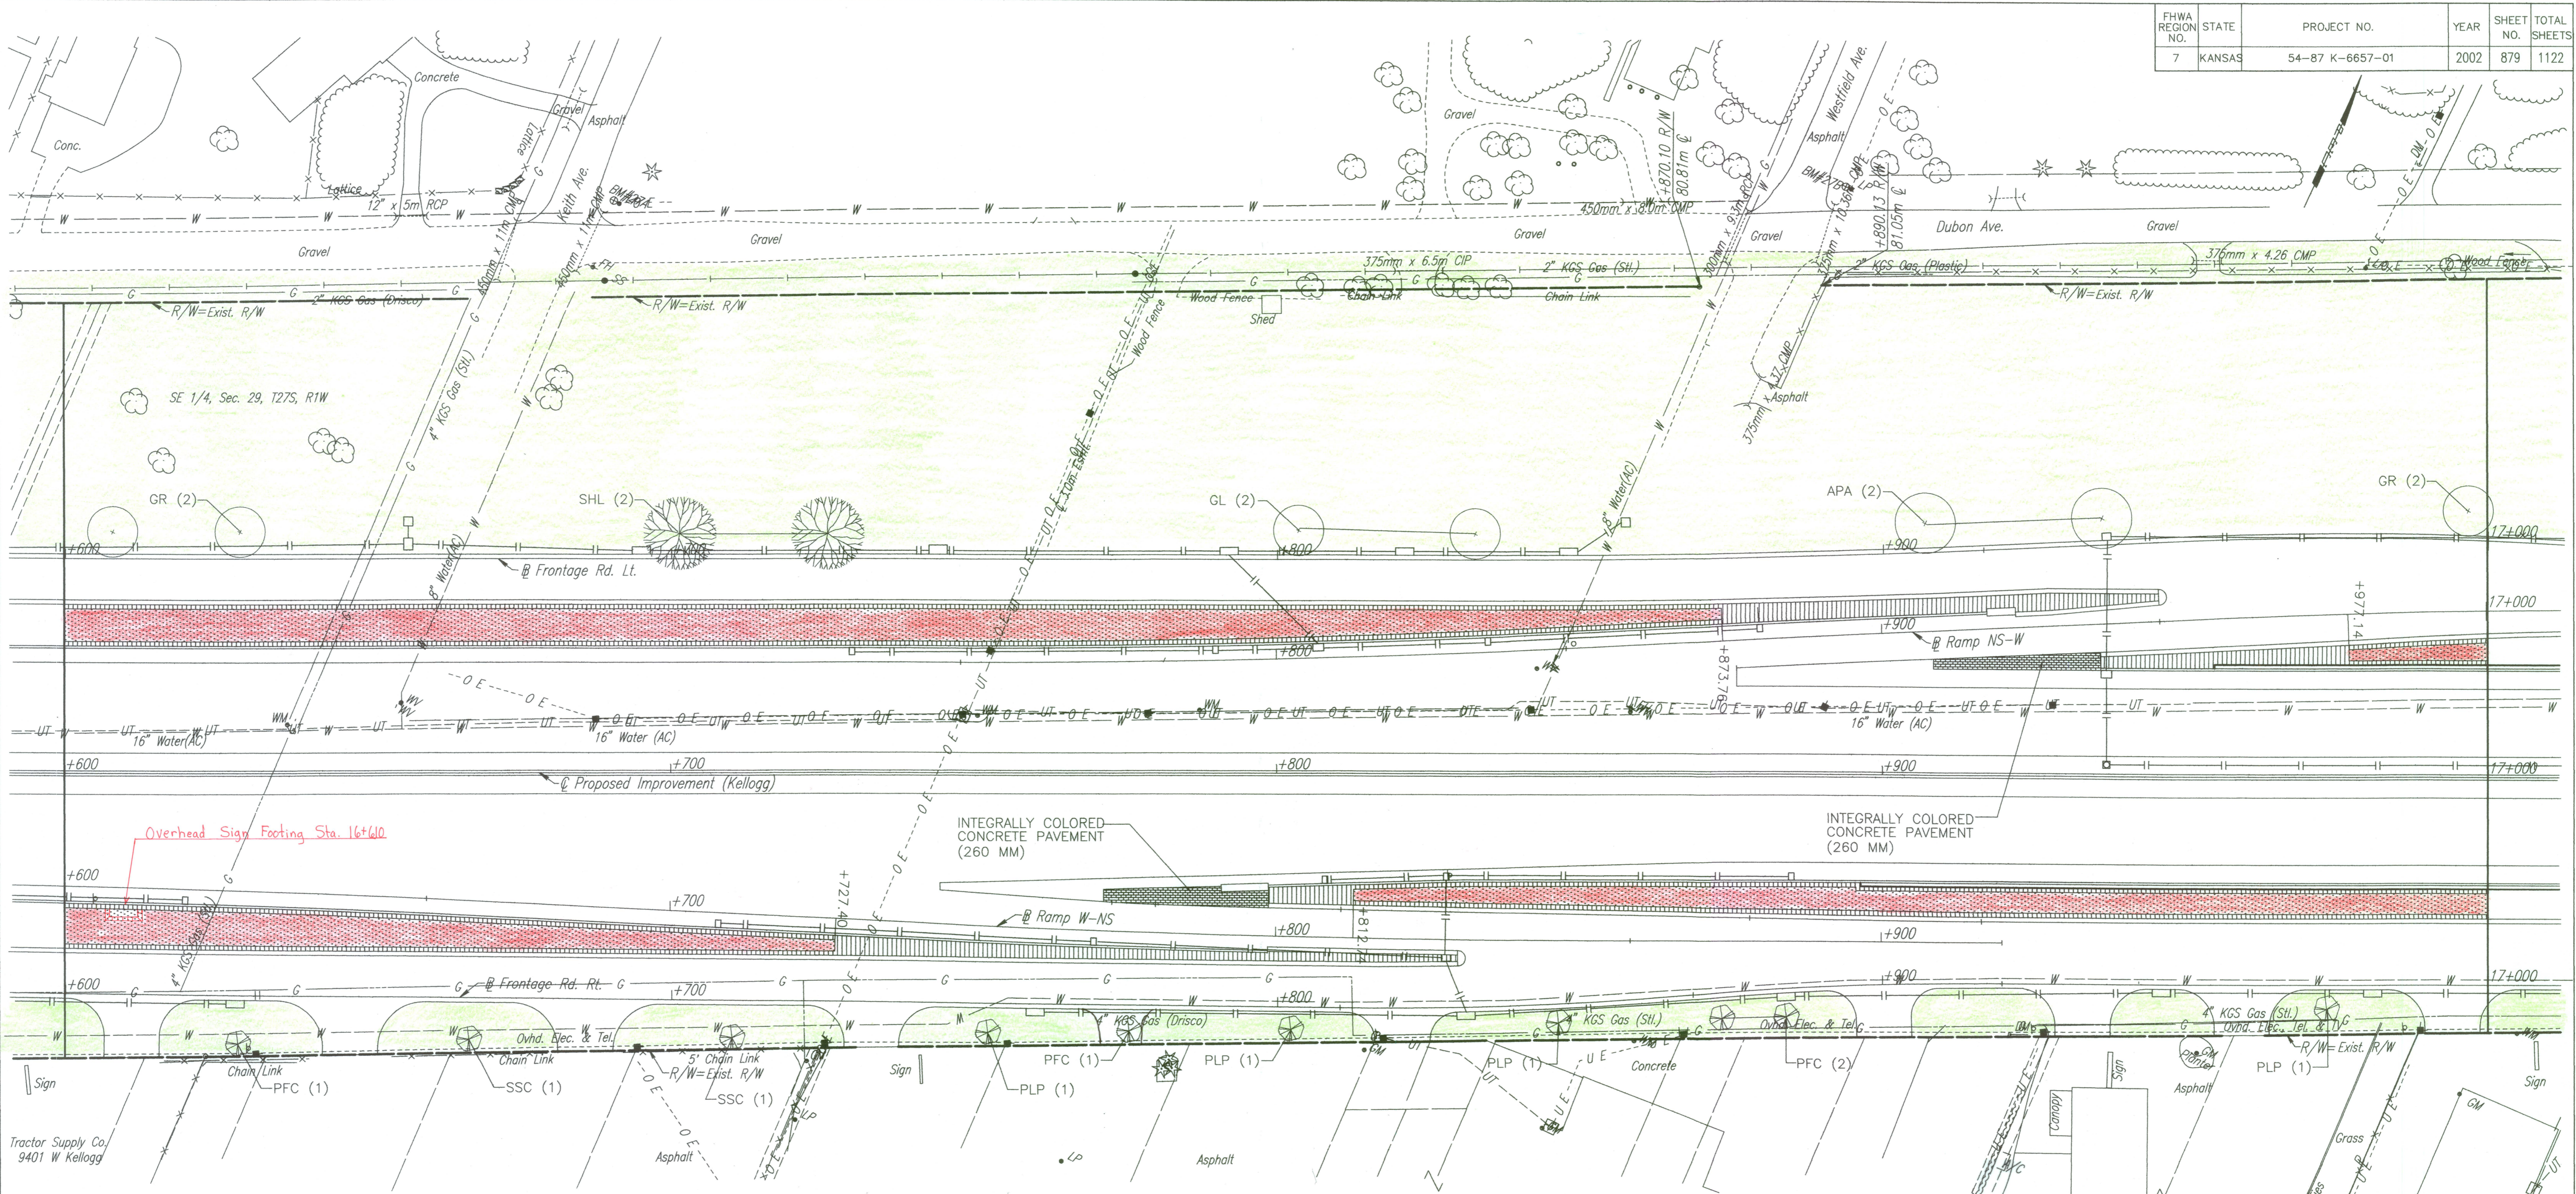


Overhead Sign Footing Sta. 16+610

INTEGRALLY COLORED CONCRETE PAVEMENT (260 MM)

INTEGRALLY COLORED CONCRETE PAVEMENT (260 MM)

SEEDING LEGEND

	BUFFALO/ BLUE GRAMA GRASS MIX SEED
	BUFFALO SEED ONLY
	K-31 FESCUE SEED (IRRIGATED)
	K-31 FESCUE SEED (NON-IRRIGATED)
	FESCUE SOD
	COWSIC CREEK MITIGATION SEEDING
	SOD INSTALLED BY OTHERS (NO-PAY)
	ADDITIONAL AREAS SEEDDED BY CONTRACTOR (NO-PAY)
	AREAS NOT RECEIVING PERMANENT SEEDING

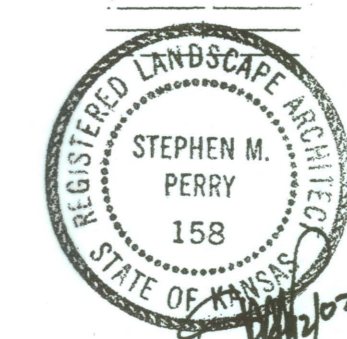

No.	Revisions	By	Date
1			

CITY OF WICHITA
LANDSCAPE PLAN
 STA. 16+600 TO STA. 17+000
 SEDGWICK COUNTY

Professional Engineering Consultants, P.A.
 303 S. TOPEKA • WICHITA, KANSAS 67202
 316-262-2691 • FAX 316-262-3003

Designed by	SMP	Checked by	
Drawn by	DWR	Date	April, 2002
		Job No.	97362

DSNR: OPER: DWR SCALE: 1:500 F: 9934/IS166

