


FHWA REGION NO.	STATE	PROJECT NO.	YEAR	SHEET NO.	TOTAL SHEETS
7	KANSAS	54-87 K-6657-01	2002	883	1122

Max L. Cole, et al  
c/o Daniel M. Carney  
D-38863

BY	DATE
REFERENCES NOTED	
REFERENCES CHECKED	

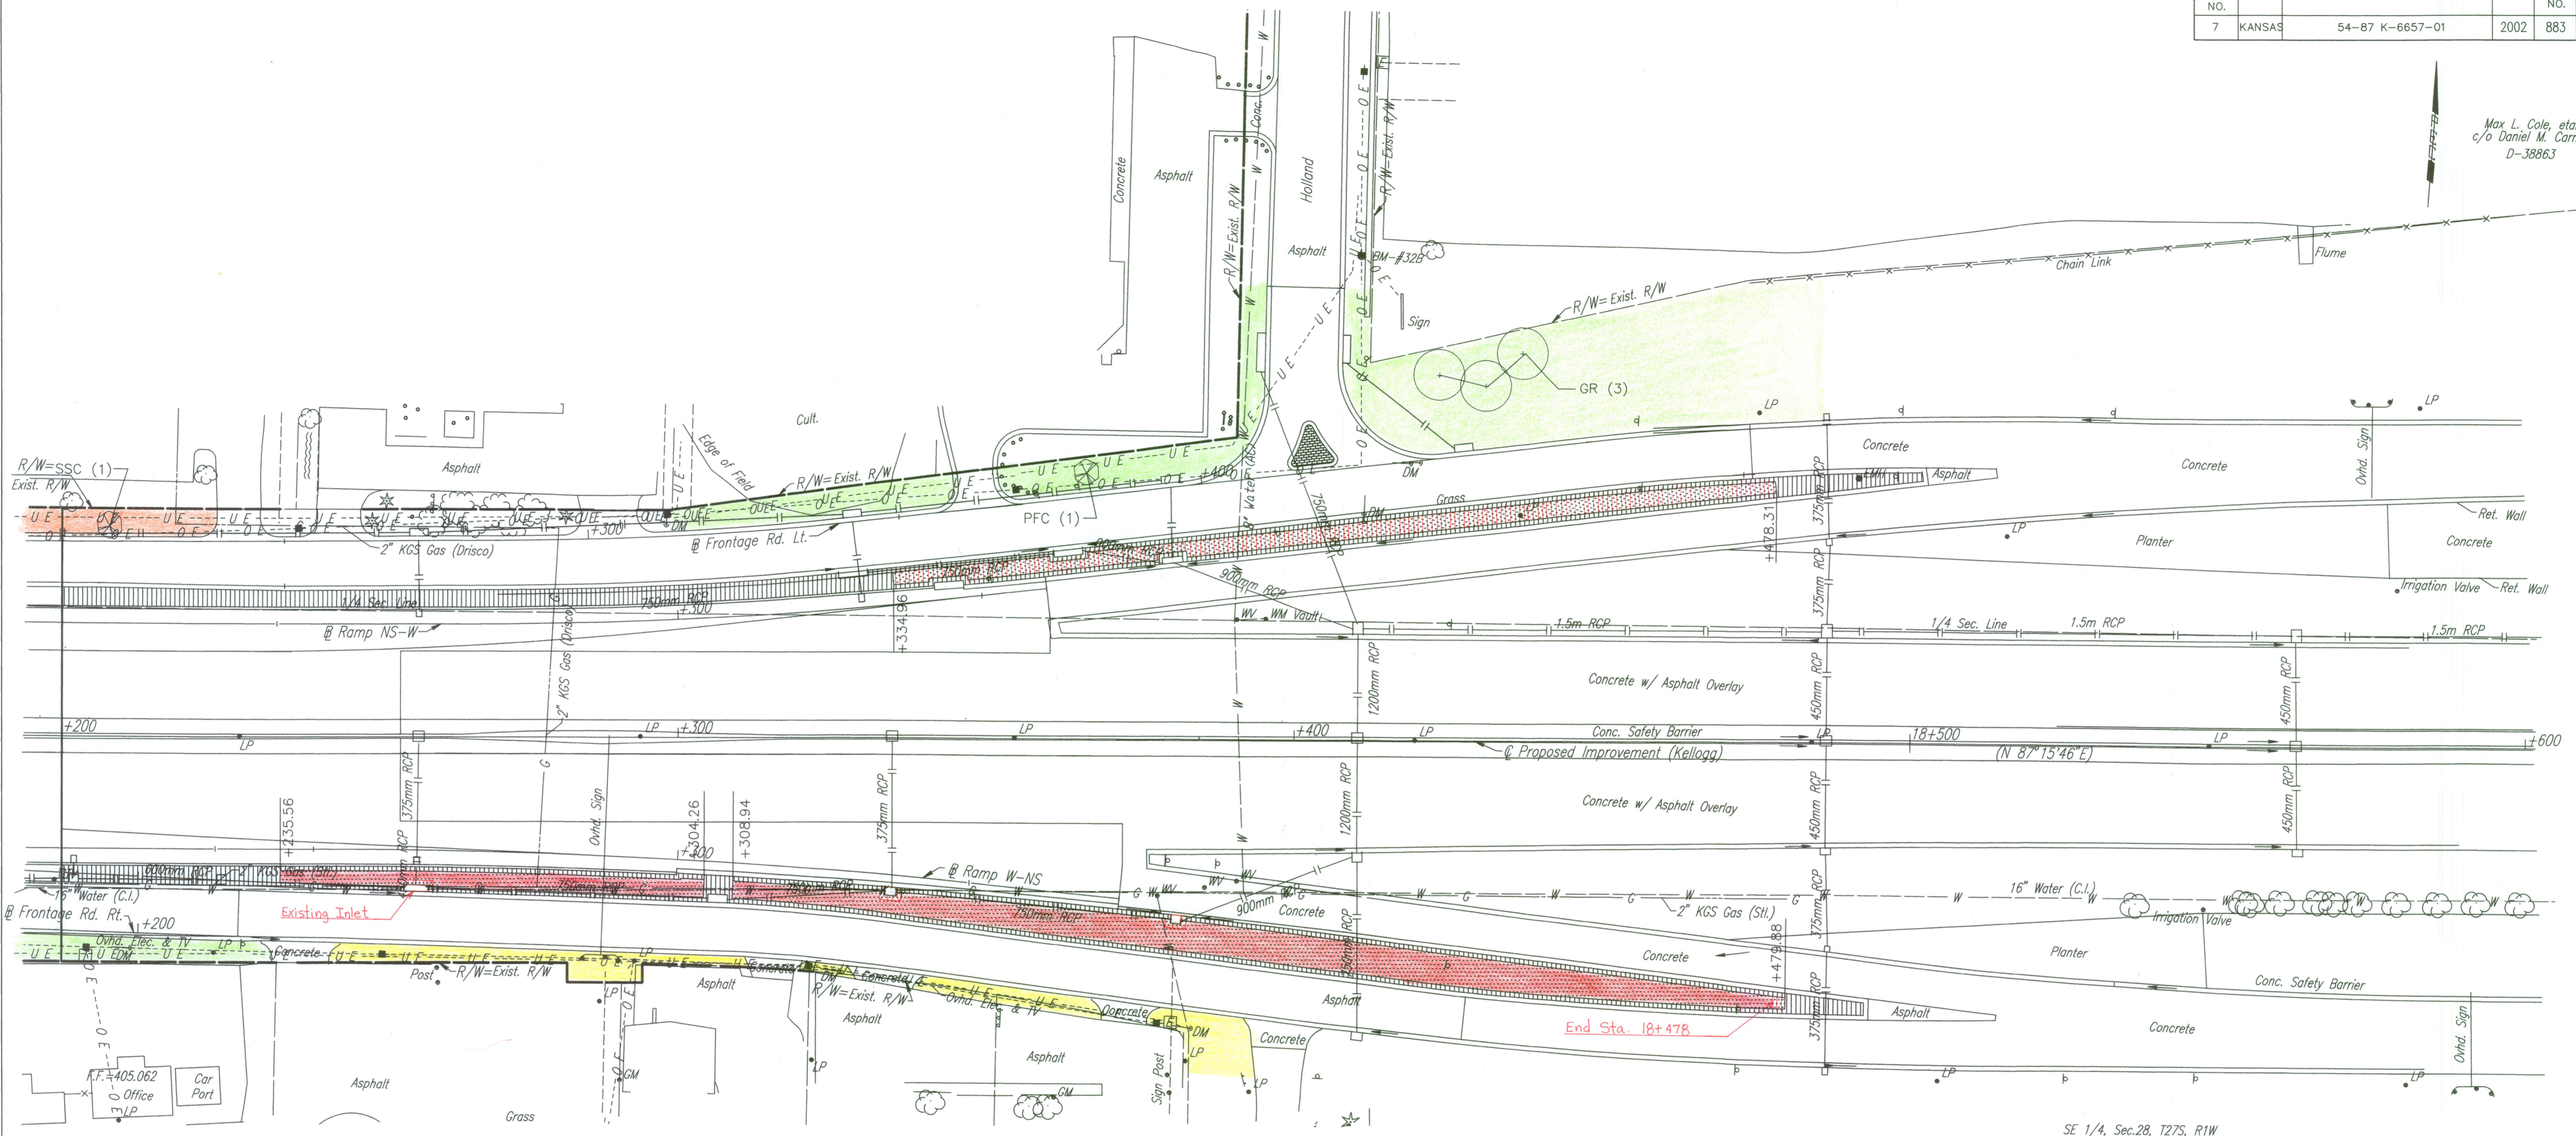


SE 1/4, Sec.28, T27S, R1W

DSNR: F/9934/1S182  
 OPER: DWR  
 SCALE: 1:500



SEEDING LEGEND	
<span style="display: inline-block; width: 15px; height: 10px; background-color: #90EE90; border: 1px solid black;"></span>	BUFFALO/ BLUE GRAMA GRASS MIX SEED
<span style="display: inline-block; width: 15px; height: 10px; background-color: #ADD8E6; border: 1px solid black;"></span>	BUFFALO SEED ONLY
<span style="display: inline-block; width: 15px; height: 10px; background-color: #FF69B4; border: 1px solid black;"></span>	K-31 FESCUE SEED (IRRIGATED)
<span style="display: inline-block; width: 15px; height: 10px; background-color: #FFB6C1; border: 1px solid black;"></span>	K-31 FESCUE SEED (NON-IRRIGATED)
<span style="display: inline-block; width: 15px; height: 10px; background-color: #FFC0CB; border: 1px solid black;"></span>	FESCUE SOD
<span style="display: inline-block; width: 15px; height: 10px; background-color: #D2B48C; border: 1px solid black;"></span>	COWSKIN CREEK MITIGATION SEEDING
<span style="display: inline-block; width: 15px; height: 10px; background-color: #FFD700; border: 1px solid black;"></span>	SOD INSTALLED BY OTHERS (NO-PAY)
<span style="display: inline-block; width: 15px; height: 10px; background-color: #ADD8E6; border: 1px solid black;"></span>	ADDITIONAL AREAS SEEDDED BY CONTRACTOR (NO-PAY)
<span style="display: inline-block; width: 15px; height: 10px; background-color: #FFFF00; border: 1px solid black;"></span>	AREAS NOT RECEIVING PERMANENT SEEDING

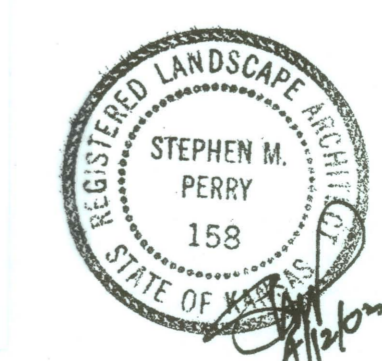

1	No.	Revisions	By	Date
CITY OF WICHITA				
LANDSCAPE PLAN				
STA. 18+200 TO STA. 18+600				
SEDGWICK COUNTY				
Professional Engineering Consultants, P.A.				
303 S. TOPEKA • WICHITA, KANSAS 67202 316-262-2691 • FAX 316-262-3003				
Designed by	SMP	Checked by		
Drawn by	DWR	Date	April, 2002	Job No. 97362