




DATE	
BY	
REFERENCES NOTED	
REFERENCES CHECKED	

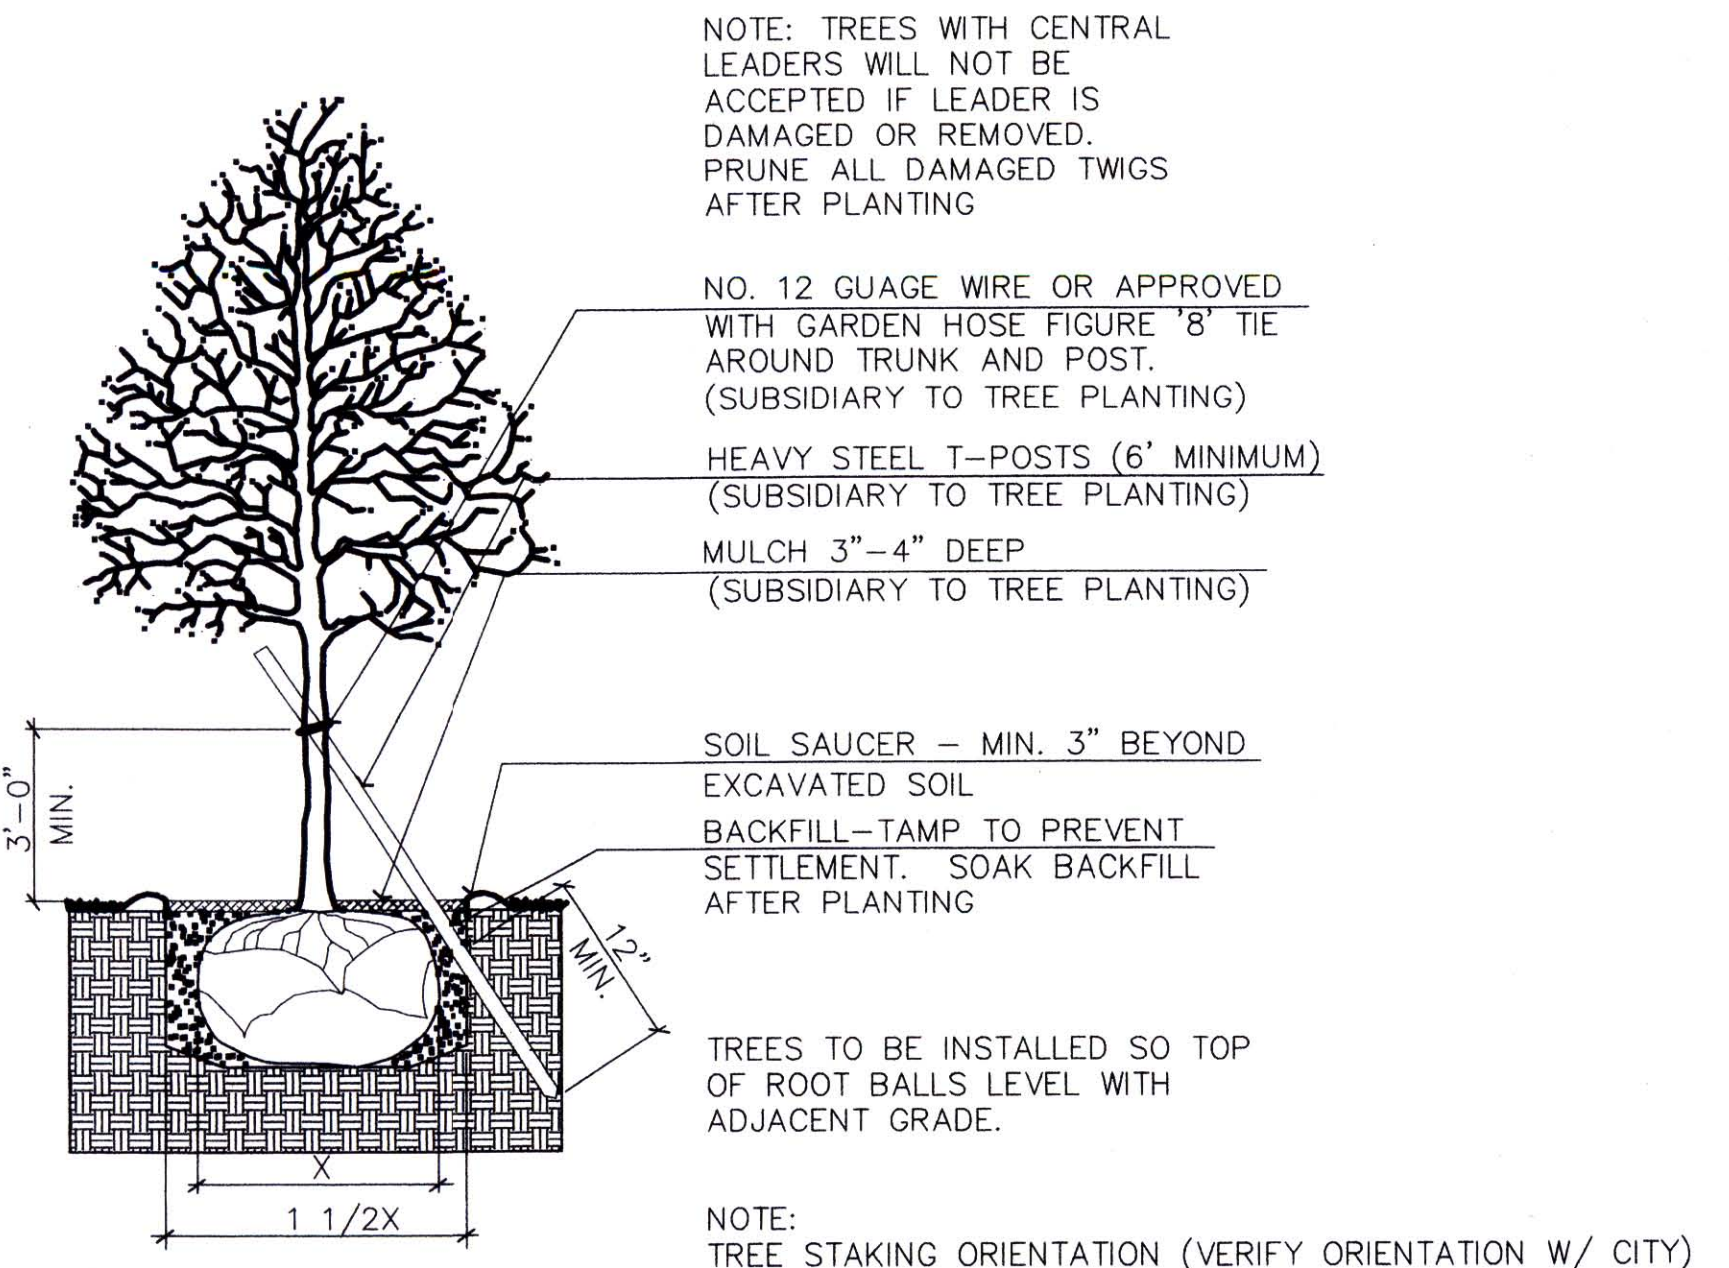


1 TREE PLANTING & STAKING DETAIL
1 3/4" CALIPER AND SMALLER NO SCALE

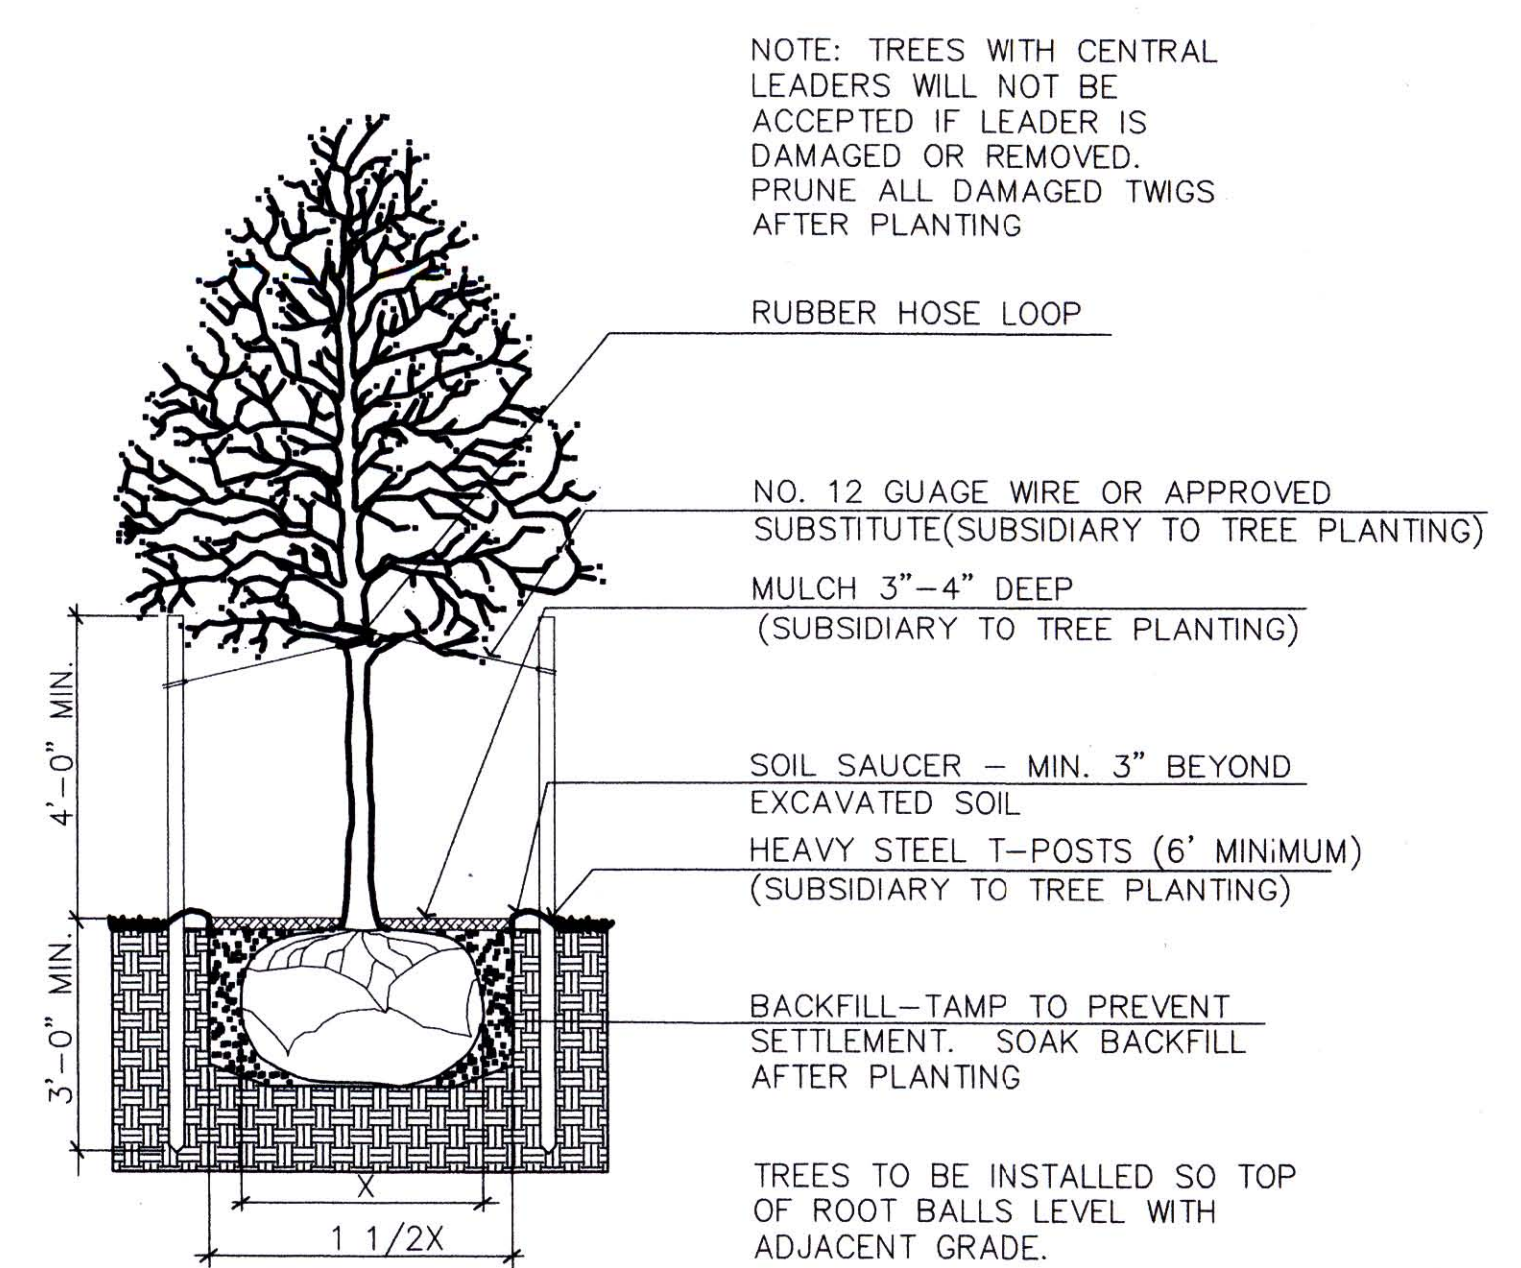


2 TREE PLANTING & STAKING DETAIL
2" CALIPER AND LARGER NO SCALE

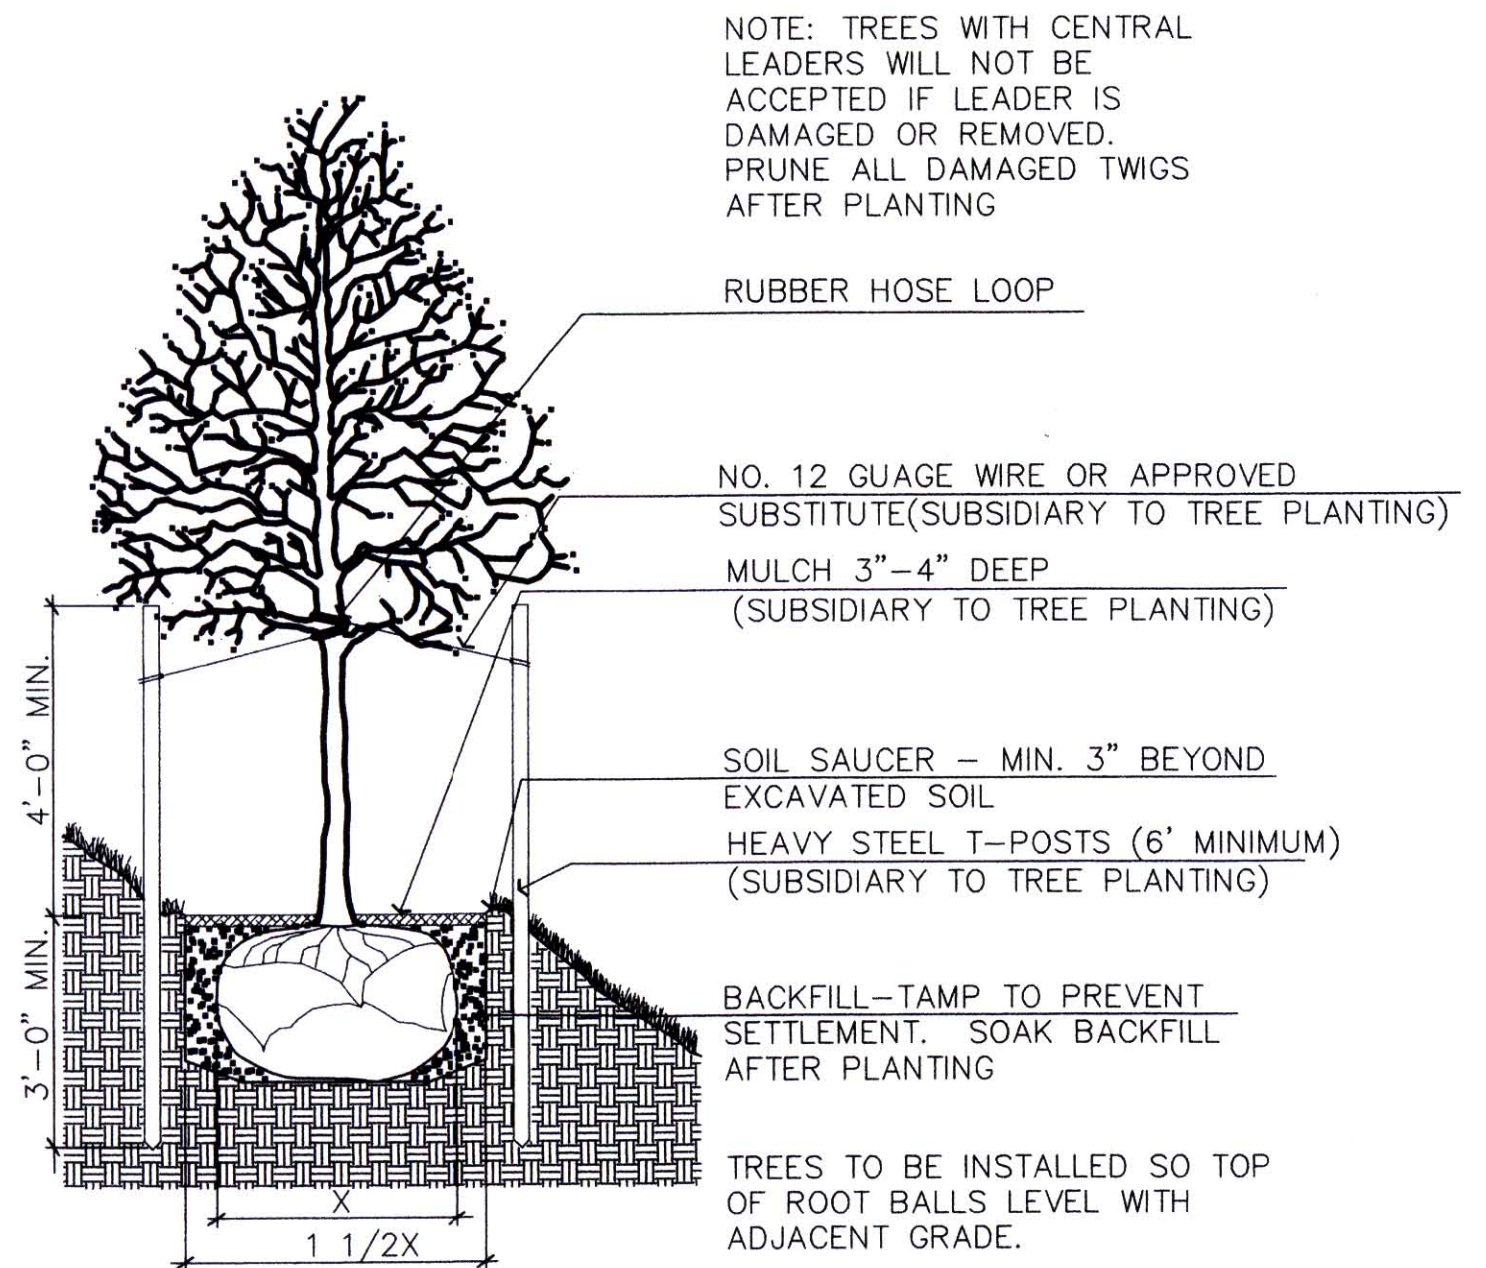


3 TREE PLANTING & STAKING DETAIL
SLOPE AREA PLANTING LARGER THAN 2" CALIPER NO SCALE

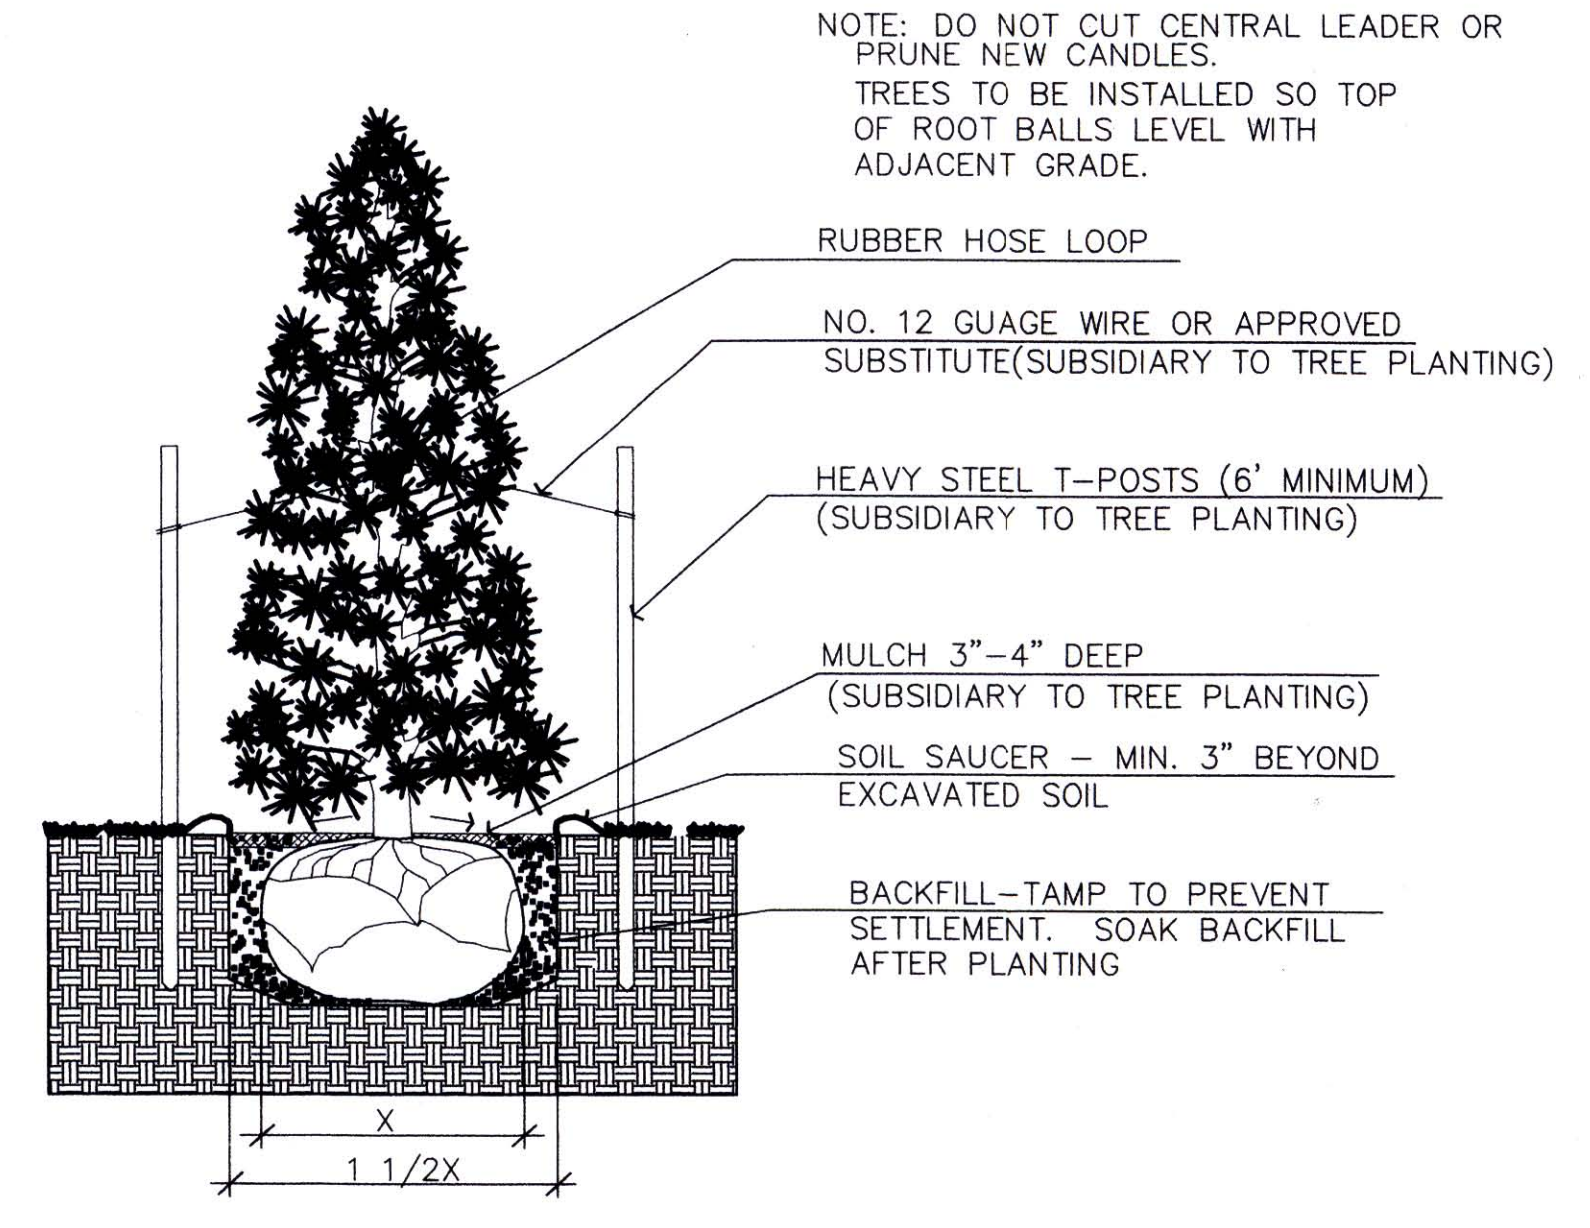

4 EVERGREEN PLANTING & STAKING DETAIL
NO SCALE

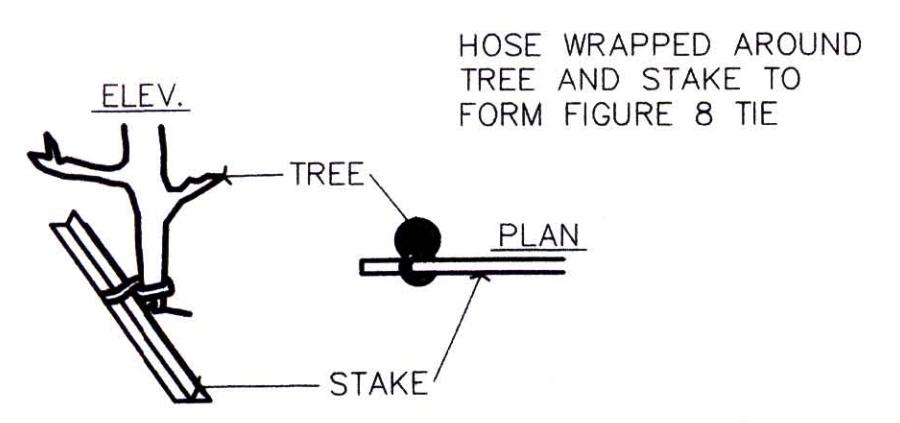

5 FIGURE '8' DETAIL
NO SCALE

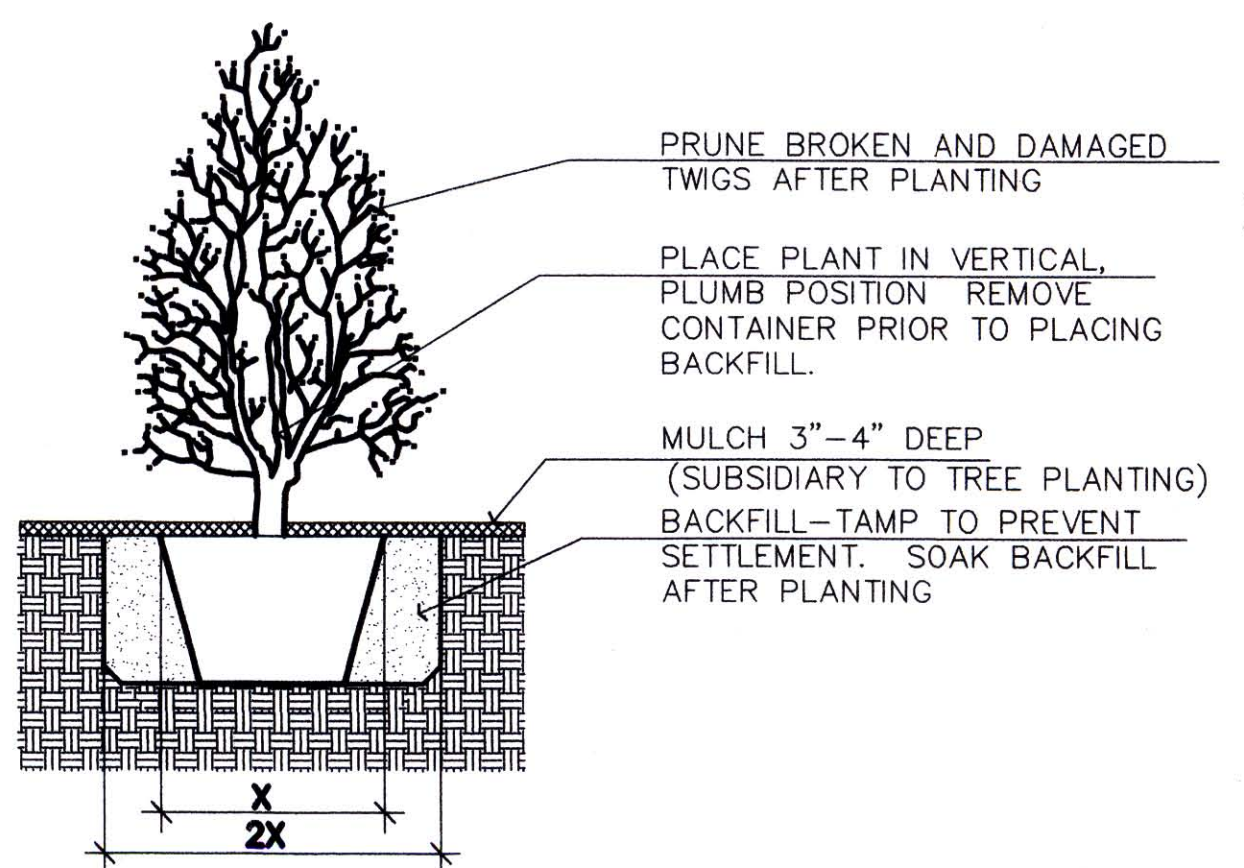

6 SHRUB PLANTING DETAIL
NO SCALE

PLANT LIST

KEY	QTY.	COMMON NAME	BOTANICAL NAME	SIZE	COND.
TREES TOTAL = 493- 179					
ABM	20	AUTUMN BLAZE MAPLE	ACER RUBRUM X FREEMANII 'AUTUMN BLAZE'	2" CAL.	B & B
APA	33	AUTUMN PURPLE ASH	FRAXINUS AMERICANA 'AUTUMN PURPLE'	2" CAL.	B & B
BC	6	BALDCYPRESS	TAXODIUM DISTICHUM	2" CAL.	B & B
BO	6	BURR OAK	QUERCUS MACROCARPA	2" CAL.	B & B
CM	18	CADDO MAPLE	ACER SACCHARUM 'CADDO'	2" CAL.	B & B
CP	49	CHINESE PISTACHE	PISTACHE CHINENSIS	2" CAL.	B & B
LE	12	LACEBARK ELM	ULMUS PARVIFOLIA	2" CAL.	B & B
LP	7	LONDON PLANETREE	PLATANUS X ACERIFOLIA 'BLOODGOOD'	2" CAL.	B & B
PPH	2	RAIRIE PRIDE HACKBERRY	CELTIS OCCIDENTALIS 'RAIRIE PRIDE'	2" CAL.	B & B
RSM	1	RED SUNSET MAPLE	ACER RUBRUM 'FRANKSRED'	2" CAL.	B & B
SHL	16	SHADEMASTER HONEYLOCUST	GLEDITSIA TRIACANTHOS INERMIS 'SHADEMASTER'	2" CAL.	B & B
SRO	21	SHUMARD RED OAK	QUERCUS SHUMARDII	2" CAL.	B & B
UEO	2	UPRIGHT ENGLISH OAK	QUERCUS ROBUR 'FASTIGIATA'	2" CAL.	B & B

KEY	QTY.	COMMON NAME	BOTANICAL NAME	SIZE	COND.
EVERGREEN TREES TOTAL = 4- 42					
AP	41	AUSTRIAN PINE	PINUS NIGRA	6' HT.	B & B

KEY	QTY.	COMMON NAME	BOTANICAL NAME	SIZE	COND.
ORNAMENTAL TREES TOTAL = 375- 365					
AM	6	AMUR MAPLE	ACER GINNALA	6" CLUMP	B & B
BCM	18	BAILEY COMPACT AMUR MAPLE	ACER GINNALA 'BAILEY COMPACT'	4" HT.	B & B
CAP	2	CAPITAL PEAR	PYRUS CALLERYANA 'CAPITAL'	1.5" CAL.	B & B
CHP	2	CHANTICLEER PEAR	PYRUS CALLERYANA 'CLEVELAND SELECT'	1.5" CAL.	B & B
ERB	18	EASTERN REDBUD	CERCIS CANADENSIS	1.5" CAL.	B & B
GR	70	GOLDENRAIN TREE	KOELREUTERIA PANICULATA	1.5" CAL.	B & B
HWC	3	HIGAN WEeping CHERRY	PRUNUS SUBHIRTELLA 'PENDULA'	1.5" CAL.	B & B
LC	3	LOUISA CRABAPPLE	MALUS 'LOUISA'	1.5" CAL.	B & B
OR	29	OKLAHOMA REDBUD	CERCIS RENIFORMIS 'OKLAHOMA'	1.5" CAL.	B & B
PFC	53	PRAIRIFIRE CRABAPPLE	MALUS X 'PRAIRIEFIRE'	1.5" CAL.	B & B
PLP	47	PURPLELEAF PLUM	PRUNUS CERASIFERA 'KRAUTER VESUVIUS'	1.5" CAL.	B & B
RBC	10	RED BARRON CRABAPPLE	MALUS X 'RED BARON'	1.5" CAL.	B & B
RJC	6	RED JADE CRABAPPLE	MALUS X 'RED JADE'	1.5" CAL.	B & B
SPD	6	STELLAR PINK DOGWOOD	CORNUS FLORIDA 'STELLAR PINK'	1.5" CAL.	B & B
SSC	66	SPRING SNOW CRABAPPLE	MALUS X 'SPRING SNOW'	1.5" CAL.	B & B
TC	26	THUNDERCLOUD CRABAPPLE	MALUS X 'THUNDERCLOUD'	1.5" CAL.	B & B
VEC	10	VAN ESELTIME CRABAPPLE	MALUS X 'VAN ESELTIME'	1.5" CAL.	B & B


KEY	QTY.	COMMON NAME	BOTANICAL NAME	SIZE	COND.
SHRUBS TOTAL = 1519- 1366					
ACV	65	ALFREDO COMPACT AMERICAN CRANBERRYBUSH	VIBURNUM TRILOBUM 'COMPACTUM'	5 GAL.	CONT.
ASY	27	ANDERSON SPREADING YEW	TAXUS CUSPIDATA 'ANDERSON'	5 GAL.	CONT.
AW	22	ANTHONY WATERER SPIREA	SPIREA X BUMALDA 'ANTHONY WATERER'	5 GAL.	CONT.
BB	8	BURNING BUSH	EUONYMUS ALATUS 'COMPACTUS'	5 GAL.	CONT.
BBH	1	BLUE BOY HOLLY	ILEX X MESERVEAE 'BLUE BOY'	5 GAL.	CONT.
BGH	2	BLUE GIRL HOLLY	ILEX X MESERVEAE 'BLUE GIRL'	5 GAL.	CONT.
BCJ	58	BLUE CHIP JUNIPER	JUNIPERUS HORIZONTALIS 'BLUE CHIP'	5 GAL.	CONT.
BE	224	BOXLEAF EUONYMUS	EUONYMUS JAPONICUS 'MICROPHYLLUS'	5 GAL.	CONT.
CC	22	CRANBERRY COTONEASTER	COTONEASTER APICULATUS	5 GAL.	CONT.
COP	13	CISTENA PLUM	PRUNUS X CISTENA	5 GAL.	CONT.
CPB	93	CRIMSON PIGMY BARBERRY	BERBERIS THUNBERGII 'ATROPURPUREA NANA'	5 GAL.	CONT.
FO	20	FORSYTHIA LYNWOOD GOLD	FORSYTHIA INTERMEDIA 'LYNWOOD GOLD'	5 GAL.	CONT.
DW	12	DWARF VARIATED WIEGELA	WIEGELA FLORIDA 'VARIGATED NANA'	5 GAL.	CONT.
GS	133	GOLDFLAME SPIREA	SPIREA X BUMALDA 'GOLDFLAME'	5 GAL.	CONT.
HJ	8	HILLSPIRE JUNIPER	JUNIPERUS CHINENSIS 'HILLSPIRE'	6' HT.	B & B
JGJ	48	JAPANESE GARDEN JUNIPER	JUNIPERUS PROCUMBENS	5 GAL.	CONT.
JV	65	JUDD VIBURNUM	VIBURNUM X JUDDII	5 GAL.	CONT.
ME	186	MANHATTAN EUONYMUS	EUONYMUS KIAUTSCHOVICUS 'MANHATTAN'	5 GAL.	CONT.
MJ	40	MINT JULEP JUNIPER	JUNIPERUS CHINENSIS 'MONLEP'	5 GAL.	CONT.
OG	162	OREGON GRAPEHOLLY MAHONIA	MAHONIA AQUIFOLIUM	5 GAL.	CONT.
RGB	22	ROSE GLOW BARBERRY	BERBERIS THUNBERGII ATROPURPUREA	5 GAL.	CONT.
RSR	76	DREAM RED HARDY SHRUB ROSE	ROSA 'DREAM RED SHRUB'	2 GAL.	CONT.
SGJ	33	SEA GREEN JUNIPER	JUNIPERUS CHINENSIS 'SEA GREEN'	5 GAL.	CONT.
SJ	40	SPARTAN JUNIPER	JUNIPERUS CHINENSIS 'SPARTAN'	6' HT.	B & B
TD	107	TATARIAN DOGWOOD	CORNUS ALBA 'SIBIRICA'	5 GAL.	CONT.
VS	4	VANHOUTTE SPIREA	SPIRAEA X VANHOUTTEI	5 GAL.	CONT.
YSR	28	DREAM YELLOW HARDY SHRUB ROSE	ROSA 'DREAM YELLOW SHRUB'	2 GAL.	CONT.

KEY	QTY.	COMMON NAME	BOTANICAL NAME	SIZE	COND.
GROUNDCOVERS/PERENNIALS/GRASSES TOTAL = 577- 505					
BES	36	BLACK-EYED SUSAN (RUDBECKIA)	RUDBECKIA FULGIDA	2 GAL.	CONT.
DKC	95	DARK KNIGHT CARYOPTERIS	CARYOPTERIS X CLANDONENSIS 'DARK KNIGHT'	3 GAL.	CONT.
DL	16	"HAPPY DAYS" DAYLILY	HEMEROCALLIS 'HAPPY DAYS'	1 GAL.	CONT.
HS	9	HONEY SUCKLE	LONICERA 'HALLS PURPLE LEAF'	1 GAL.	CONT.
KG	20	KANSAS GAYFEATHER	LIATRIS SPICATA	2 GAL.	CONT.
MG	44	MAIDEN GRASS	MISCANTHUS SINENSIS 'GRACILLIMUS'	5 GAL.	CONT.
ML	220	MAJESTIC LIRIOPE	LIRIOPE MUSCARI	1 GAL.	CONT.
PC	21	PURPLE CONEFLOWER	ECHINACEA PURPUREA 'MAGNUS'	2 GAL.	CONT.
PG	31	HARDY PAMPAS GRASS	ERIANTHUS RAVENNAE	5 GAL.	CONT.
RS	15	RUSSIAN SAGE	PEROVSKIA ATRIPLICIFOLIA	2 GAL.	CONT.
SDO	29	STELLA DE ORO DAYLILY	HEMEROCALLIS 'STELLA DE ORO'	2 GAL.	CONT.

LMPVRS X LIMESTONE PAVERS 2" THICK CUT LIMESTONE PAVER 18" SQUARE ROUGH SHAPE *SUBSIDIARY TO GROUND COVER

1			
No.	Revisions	By	Date

CITY OF WICHITA
LANDSCAPE DETAILS
SEDGWICK COUNTY

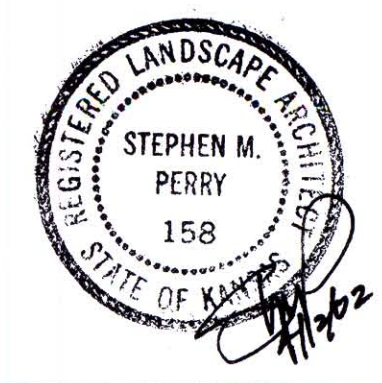

Designed by	SMP	Checked by	
Drawn by	DWR	Date	April, 2002
		Job No.	97362

DSNR: F-9934/IS146 OPER: DWR BY:DWR SCALE: 1:500

