
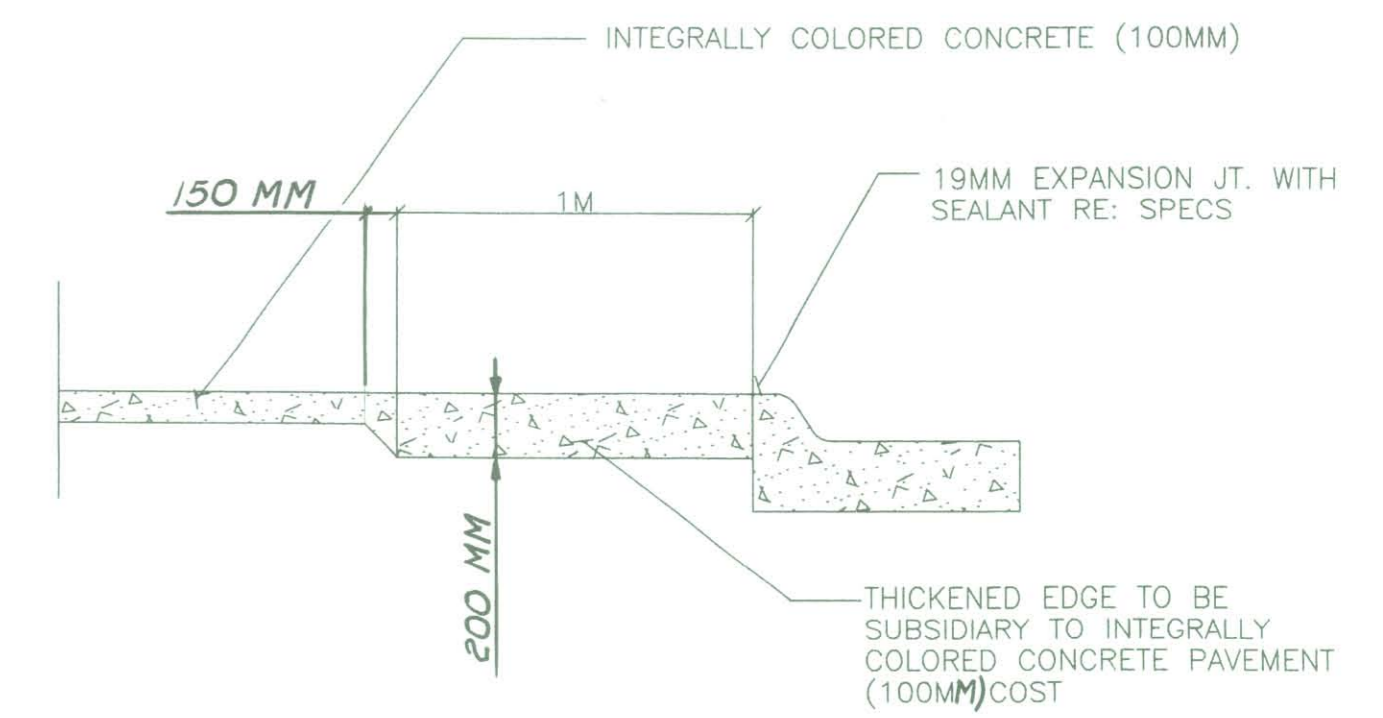


FHWA REGION NO.	STATE	PROJECT NO.	YEAR	SHEET NO.	TOTAL SHEETS
7	KANSAS	54-87 6657-01	2002	891	1122

DATE	
BY	
REFERENCES NOTED	
REFERENCES CHECKED	

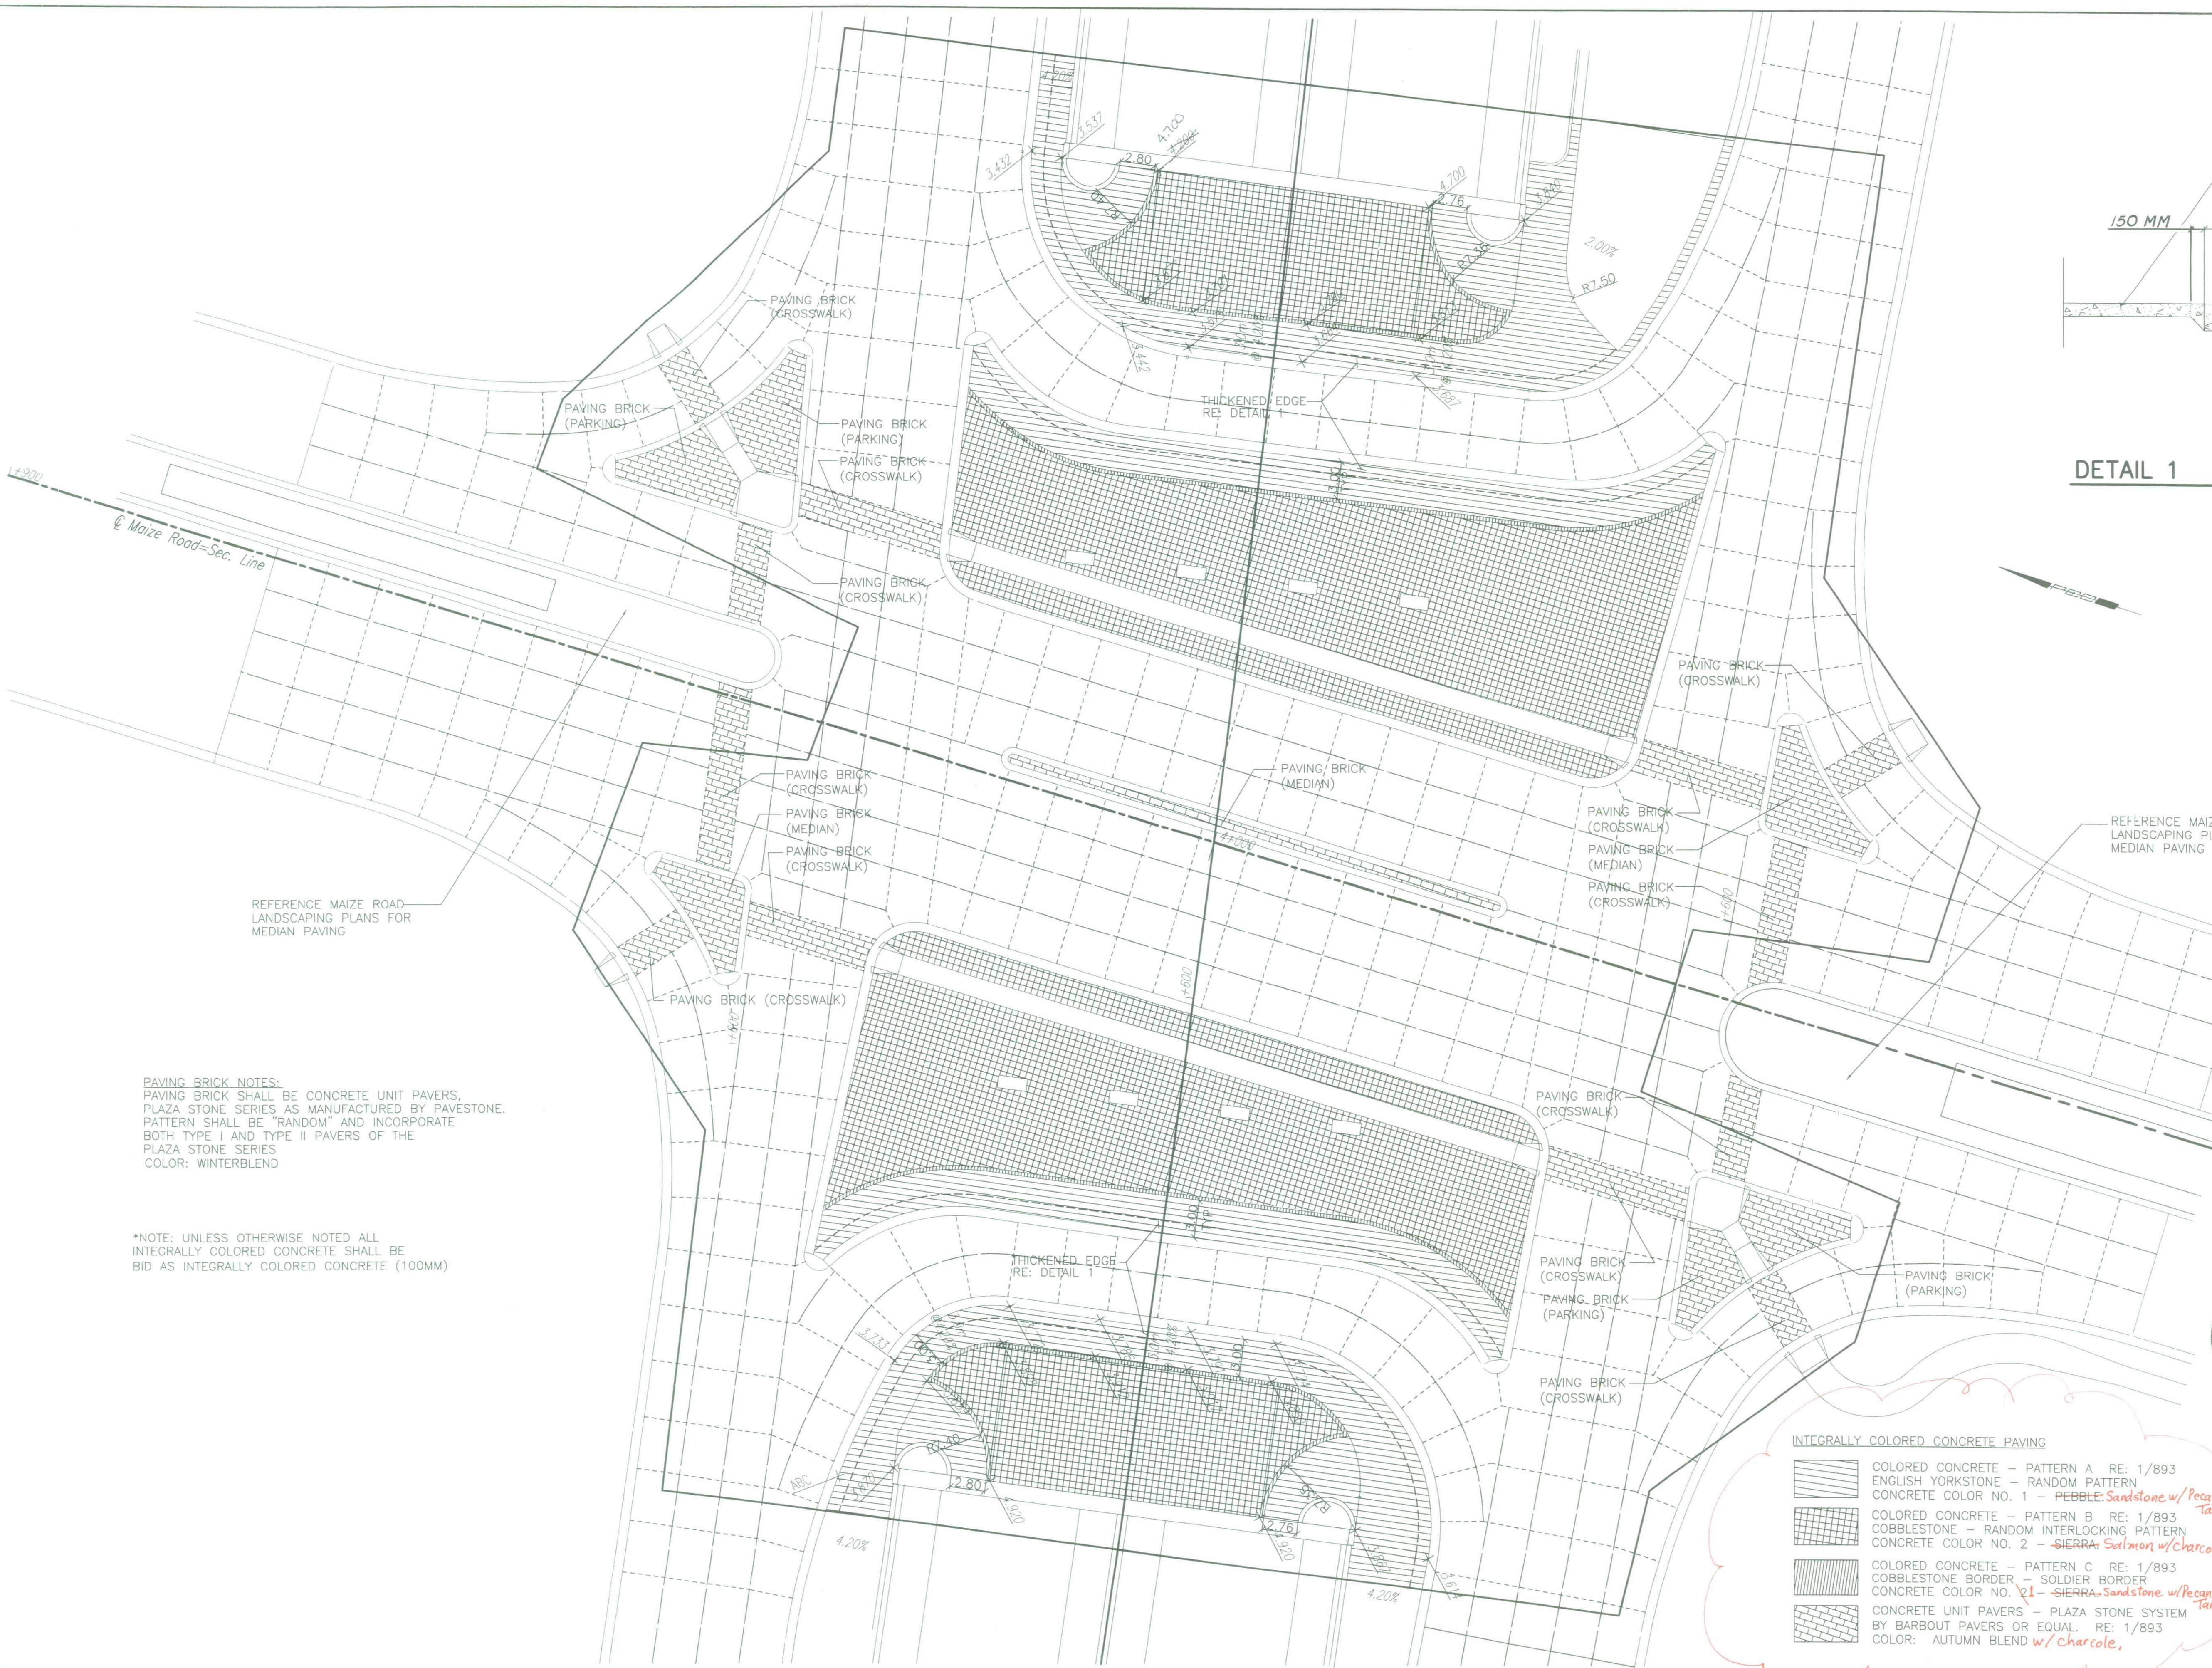

DETAIL 1
N.T.S.

PAVING BRICK NOTES:
PAVING BRICK SHALL BE CONCRETE UNIT PAVERS, PLAZA STONE SERIES AS MANUFACTURED BY PAVESTONE. PATTERN SHALL BE "RANDOM" AND INCORPORATE BOTH TYPE I AND TYPE II PAVERS OF THE PLAZA STONE SERIES
COLOR: WINTERBLEND

*NOTE: UNLESS OTHERWISE NOTED ALL INTEGRALLY COLORED CONCRETE SHALL BE BID AS INTEGRALLY COLORED CONCRETE (100MM)

- INTEGRALLY COLORED CONCRETE PAVING
- COLORED CONCRETE - PATTERN A RE: 1/893 ENGLISH YORKSTONE - RANDOM PATTERN CONCRETE COLOR NO. 1 - *PEBBLE Sandstone w/ Pecan-Tan*
 - COLORED CONCRETE - PATTERN B RE: 1/893 COBBLESTONE - RANDOM INTERLOCKING PATTERN CONCRETE COLOR NO. 2 - *SIERRA Salmon w/charcole*
 - COLORED CONCRETE - PATTERN C RE: 1/893 COBBLESTONE BORDER - SOLDIER BORDER CONCRETE COLOR NO. 21 - *SIERRA Sandstone w/ Pecan-Tan*
 - CONCRETE UNIT PAVERS - PLAZA STONE SYSTEM BY BARBOUT PAVERS OR EQUAL RE: 1/893 COLOR: AUTUMN BLEND *w/charcole*



DSNR: WDH OPER: JGP SCALE: 1:250
I:/1997/97362/INTERSECTIONS/MAIZE_myp.dgn 12-21-2000 15:07:39 LAST REV: 10-16-01 BY: JGP

1		Revisions		By	Date
No.					
CITY OF WICHITA					
ORNAMENTAL PAVING PLAN MAIZE ROAD					
SEDGWICK COUNTY					
Professional Engineering Consultants, P.A.					
303 S. TOPEKA • WICHITA, KANSAS 67202 316-262-2691 • FAX 316-262-3003					
Designed by	SMP	Checked by	JPM		
Drawn by	DWR	Date	April, 2002	Job No.	97362